

P21-024 Calder Park

Drawing Register: Fibaform

Works Completed: Gatehouse

Drawing No.	Drawing Title	Rev
P21024-FIB-XX-00-DR-X-0001	Plan View	P05
P21024-FIB-XX-00-DR-X-0002	Elevations	P05
P21024-FIB-XX-00-DR-X-0003	Elevations (Clad)	P05
P21024-FIB-XX-00-DR-X-0004	Base Detail	P05
P21024-FIB-XX-00-DR-X-0005	Lighting Grid	P05

6800

OVERALL SIZE INCLUDING CLADDING

2400 x 1200 D/G
HORIZONTAL SLIDING WINDOW
(GREY ANTI SUN GLAZING)

3190
GRP STRUCTURE SIZE

2400 x 1200 D/G
FIXED PANE WINDOW
CENTRE MULLIONS
(GREY ANTI SUN GLAZING)

DOUBLE RCD
SOCKET
IN 3 COMPARTMENT
DADO TRUNKING

DOUBLE RCD
SOCKET
IN 3 COMPARTMENT
DADO TRUNKING

DOUBLE RCD DOUBLE RCD
SOCKET SOCKET
IN 3 COMPARTMENT IN 3 COMPARTMENT
DADO TRUNKING DADO TRUNKING

WORKTOP
900mm DEPTH

DOUBLE RCD
SOCKET
IN 3 COMPARTMENT
DADO TRUNKING

DOUBLE RCD
SOCKET
IN 3 COMPARTMENT
DADO TRUNKING
12 WAY CONSUMER
UNIT

FLOOR ACCESS
700mm x 700mm

1.50 KW HEATER

762 x 1981
AMERICAN WHITE OAK
WITH LEVER HANDLE
AND KICK PLATES

DOUBLE RCD
SOCKET
LIGHT SWITCH
(KEY TEST)

DOUBLE
BASE UNIT
& UNDER
SINK WATER
HEATER

COAT HOOK

762 x 1981
AMERICAN WHITE OAK
WITH LEVER HANDLE
AND KICK PLATES

HAND
DRIER

9.5KW
INSTANT
WATER
HEATER

HAND BASIN WITH
750 x 400
MIRROR

7.5 KW HEATER

950 x 2200 INWARD
OPENING DOOR

LIGHT SWITCH
(KEY TEST)

2 No. DOUBLE
RCD SOCKETS
(ONE ABOVE
& ONE BELOW
WORKTOP)

Ø100 AXIAL
EXTRACT FAN

3450

OVERALL SIZE INCLUDING CLADDING

INTERNAL FINISHES:

- * FLOOR – POLYFLO –POLYSAFE STANDARD PUR – NORDIC GREY 4090
- * CEILING – ARMSTRONG SUSPENDED CEILING – DUNE EVO – TEGULAR TILES
- * WALLS – 9mm MFC BOARDING – WHITE TEXTURED FINISH
- * INTERNAL DOORS – AMERICAN WHITE OAK
- * WORKTOPS – DARK GREY
- * WINDOW CILLS / SKIRTING / ARCHITRAVE – UPVC





2400 x 1200 D/G
HORIZONTAL SLIDING WINDOW
(GREY ANTI SUN GLAZING)

6505
GRP STRUCTURE SIZE

PLAN VIEW

REV No.	MODIFICATIONS	DRAWN	DATE

DRAWN	DATE	CLIENT	APPROVAL	DATE
J.BUCHANAN	09.06.22			
TITLE: AS BUILT BESPOKE GATEHOUSE 7.00m x 3.60m x 2.80m HIGH PLAN VIEW				
DRG No. FPL /	P21024-FB-XX-00-DR-X-0001-PRO5 AS BUILT			
MD 02	PROJECT – E21-024 CALDER PARK 016008			
FIBAFORM PRODUCTS LTD. 22 Lonsil Industrial Estate, Cotton Road, Lancaster, LA1 3PQ. DESIGNERS AND MANUFACTURERS OF GLASSFIBRE PRODUCTS.				

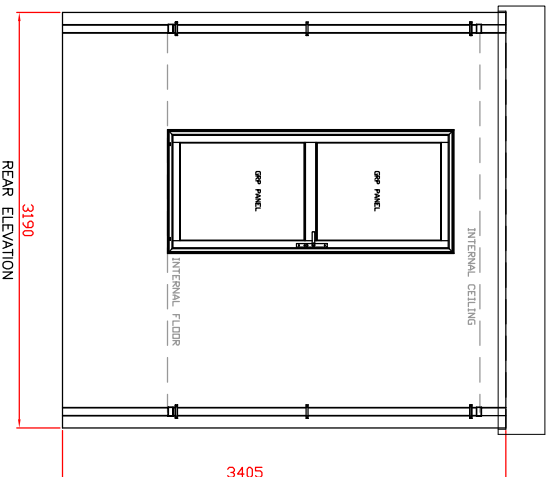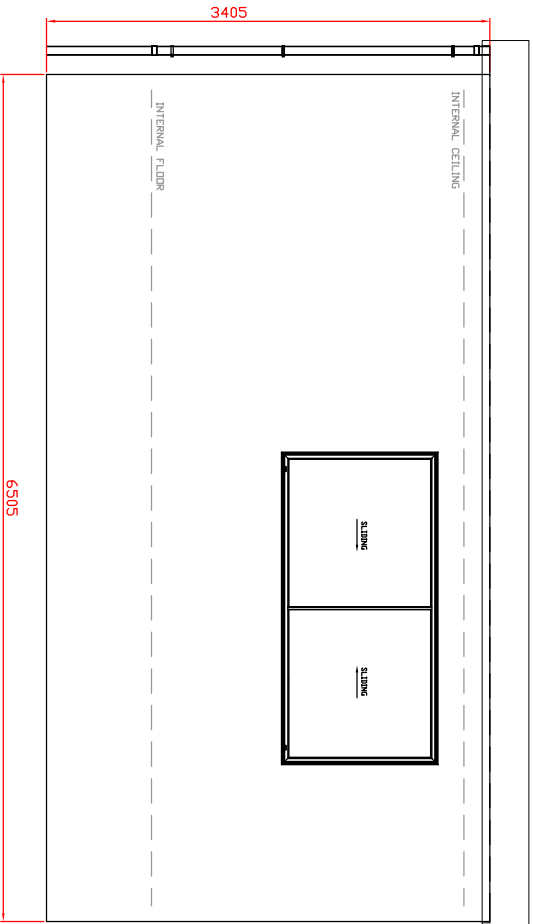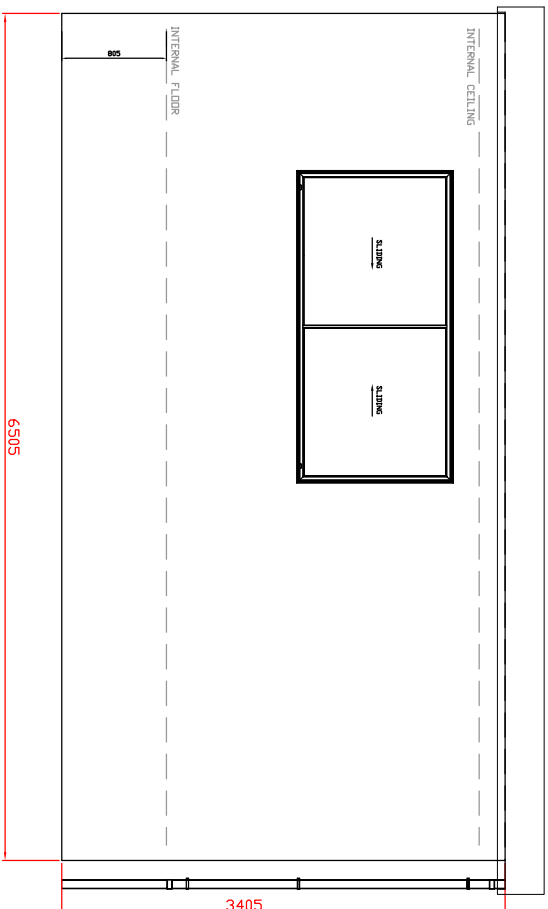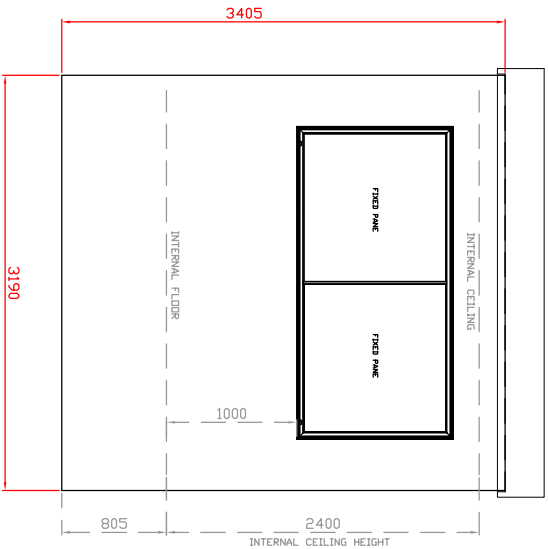

EXTERNAL FINISHES:

WALLS – GRP HIGH GLOSS FINISH – COLOUR 180 40 05 MERLIN GREY
WINDOWS / DOOR FRAMES – POWDER COATED – 180 40 05 MERLIN GREY
GLAZING – GREY TINTED ANTI SUN

LEFT HAND ELEVATION




FRONT ELEVATION

RIGHT HAND ELEVATION

REAR ELEVATION

REV No.	MODIFICATIONS	DRAWN	DATE

DRAWN	DATE	CLIENT APPROVAL	DATE
J.BUCHANAN	09.06.22		
TITLE: AS BUILT BESPOKE GATEHOUSE 7.00m x 3.60m x 2.80m HIGH ELEVATIONS – UNCLAD			
DRG No. FPL / P21024-FIB-XX-00-DR-X-0002-F05 AS BUILT			
MD 02 PROJECT – P21-024 CALDER PARK 016008			
FIBAFORM PRODUCTS LTD. 22 Lonsill Industrial Estate, Coton Road, Lancaster, LA1 3PD. DESIGNERS AND MANUFACTURERS OF GLASSFIBRE PRODUCTS.			

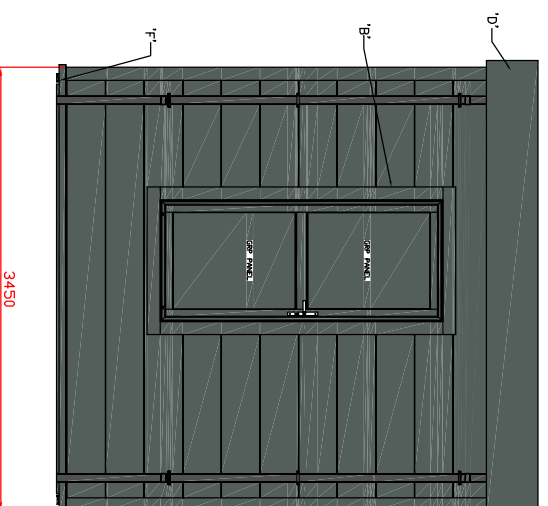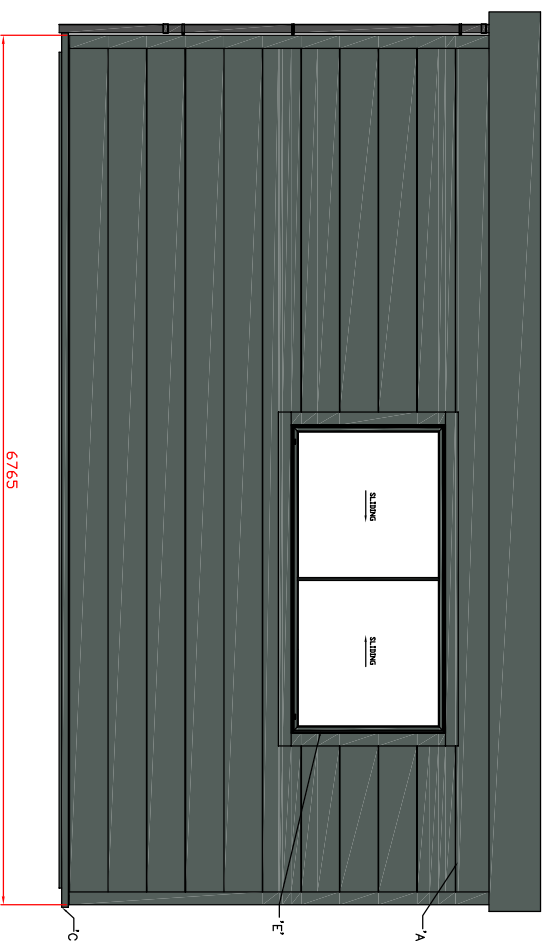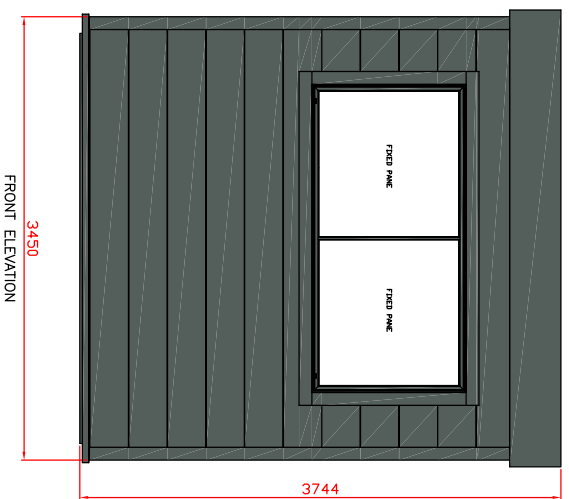


EXTERNAL FINISHES:

LEFT HAND ELEVATION

^a EXTERNAL CLADDING – CASIO MR CLADDING – 180 40 05 / 18 B 25 MERLIN GREY
^b WINDOW & DOOR SURROUND – ALUMINIUM PROFILE – 180 40 05 MERLIN GREY
^c DRIP FLASHING – 180 40 05 MERLIN GREY
^d FLASH / SIFTS – POWDER COATED ALUMINIUM PROFILE – 180 40 05 MERLIN GREY
^e WINDOW / DOORS – POWDER COATED – 18 B 25 WITH GREY TINTED ANTI SUN FLIM
^f CONCEALED RWF – SQUARE PROFILE – BLACK

REV. No.	MODIFICATIONS	DRAWN	DATE


DRAWN	DATE	CLIENT	APPROVAL	DATE
J. BUCHANAN	09.06.22			
TITLE: AS BUILT BESPOKE GATEHOUSE 7.00m x 3.60m x 2.80m HIGH ELEVATIONS - CLAD				
DWG No. FR4 / P21024-FIB-XI-00-DR-X-0003-P05 AS BUILT MD 02 PROJECT - P21-024 CALDER PARK 016008				
FIBAFORM PRODUCTS LTD. 22 Larnal Industrial Estate, Caton Road, Lancaster, LA1 3PQ. DESIGNERS AND MANUFACTURERS OF GLASSFIBRE PRODUCTS.				

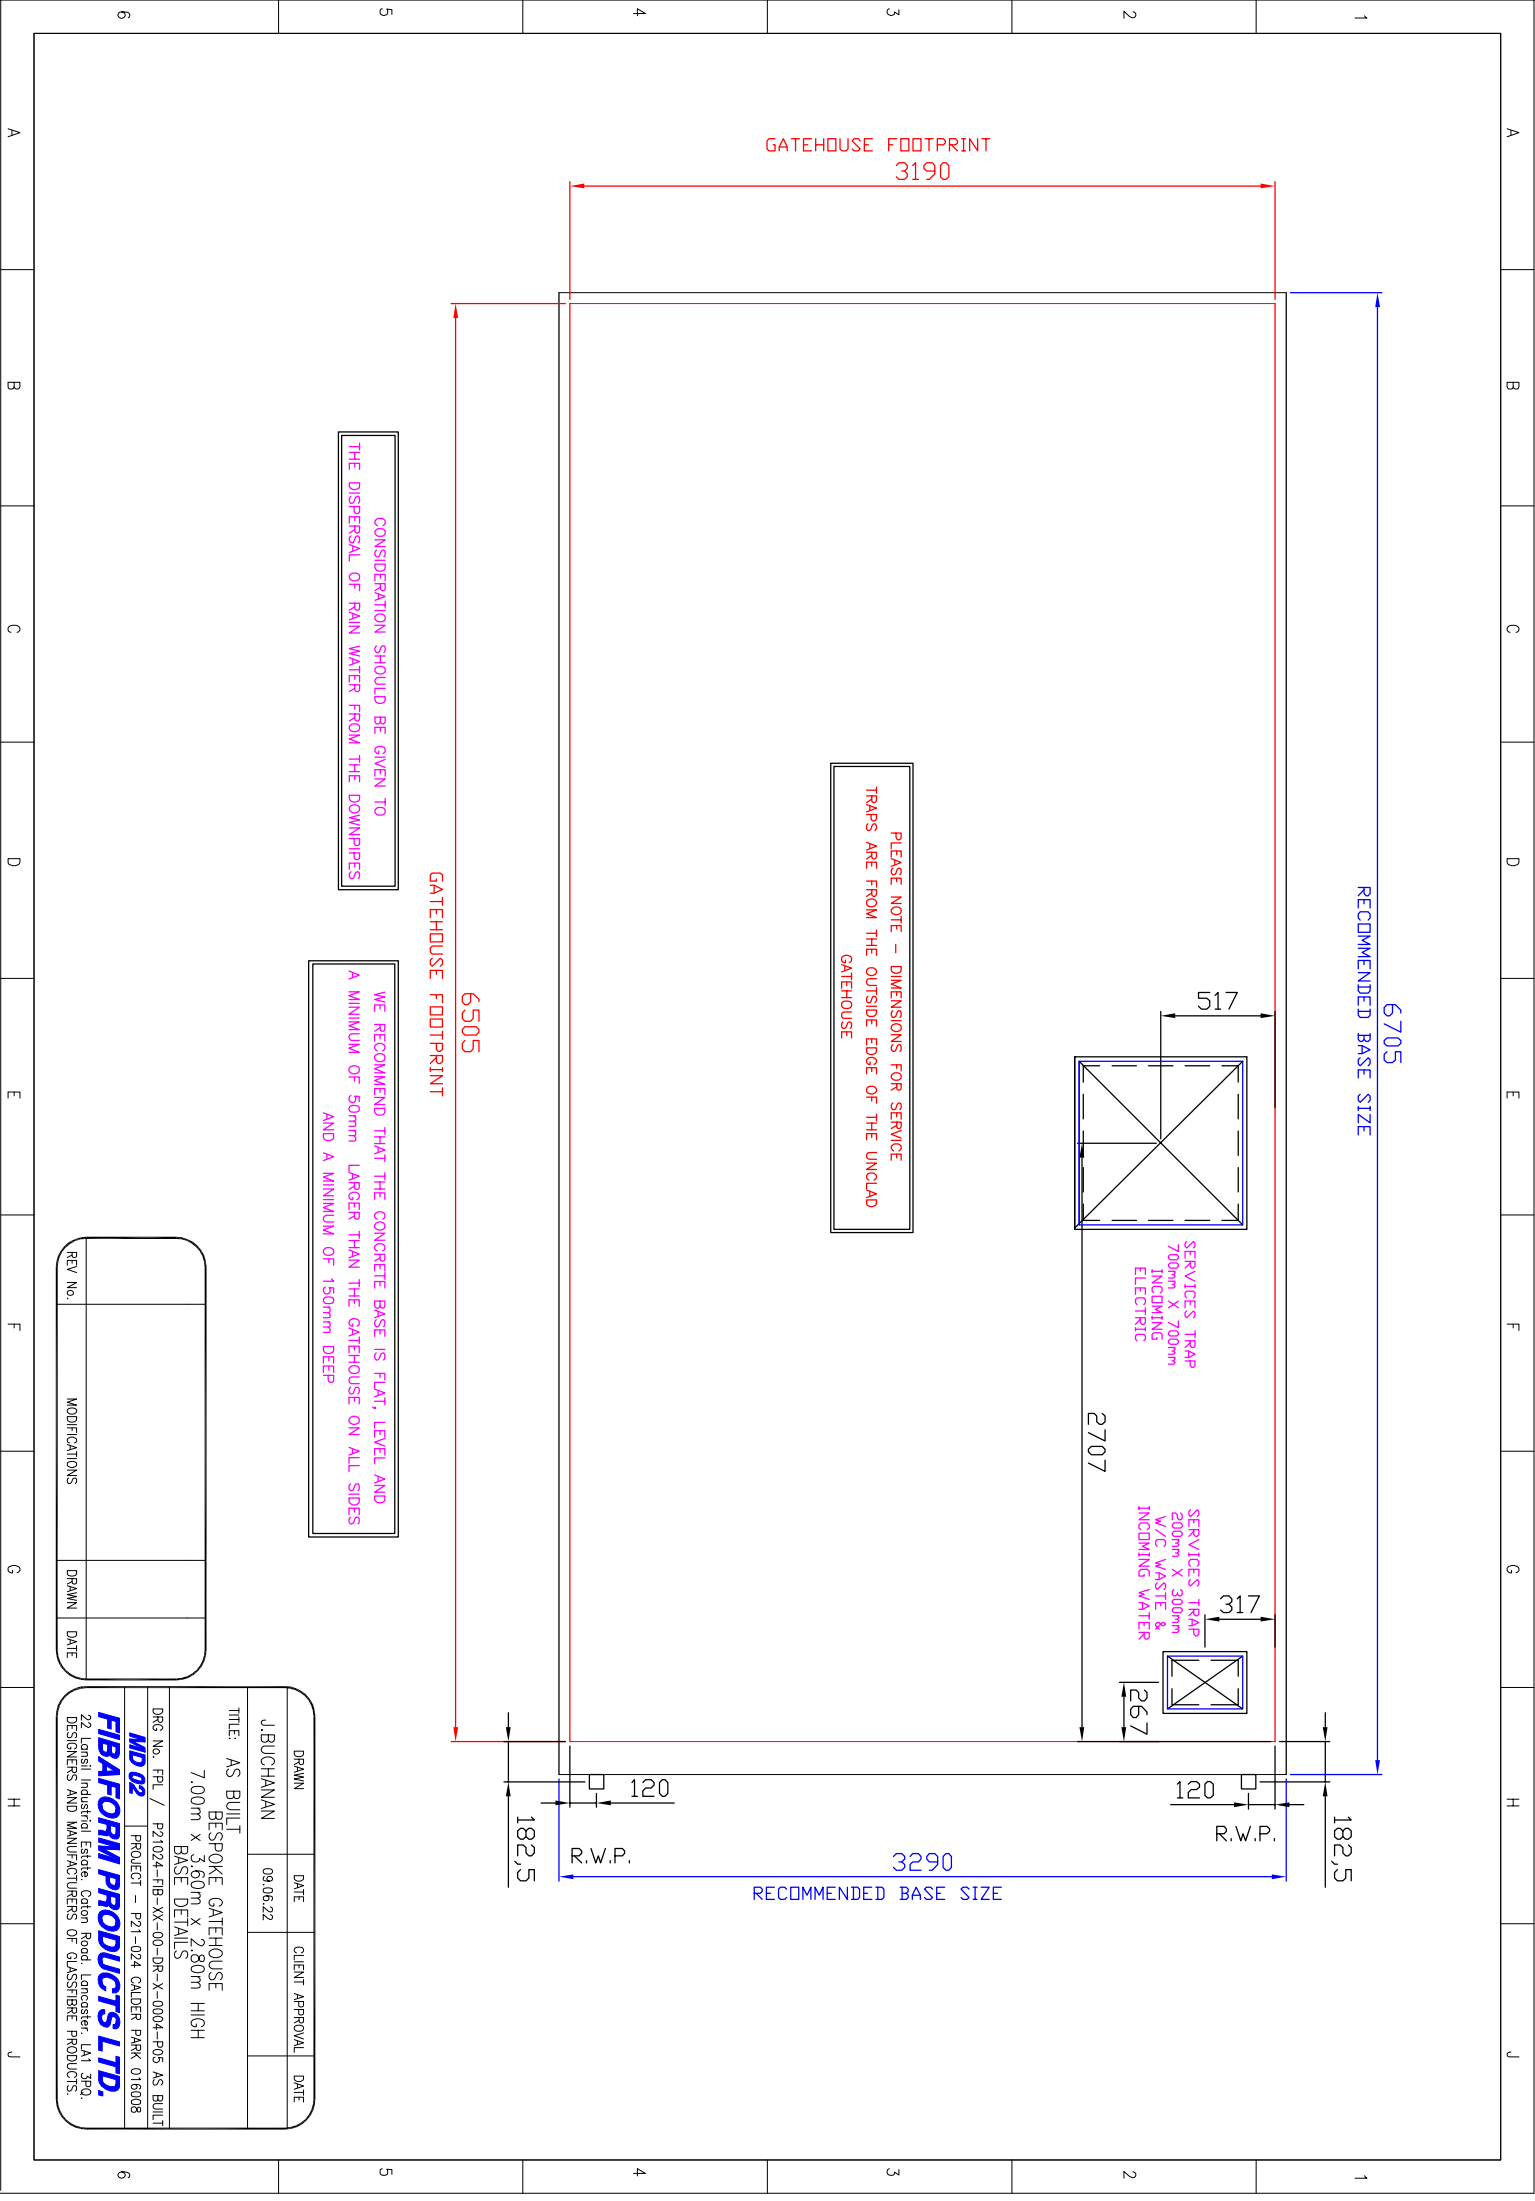

REV No.	MODIFICATIONS	DRAWN	DATE

DRAWN	DATE	CLIENT APPROVAL	DATE
J.BUCHANAN	09.06.22		
TITLE: AS BUILT BESPOKE GATEHOUSE 7.00m x 3.60m x 2.80m HIGH BASE DETAILS			
DRG No. FPL / P21024-FB-XX-00-DR-X-0004-P05 AS BUILT			
MD 02 PROJECT - P21-024 CALDER PARK 016008			
22 Lonsill Industrial Estate, Caton Road, Lancaster, LA1 3PD. DESIGNERS AND MANUFACTURERS OF GLASSFIBRE PRODUCTS.			

FIBAFORM PRODUCTS LTD.

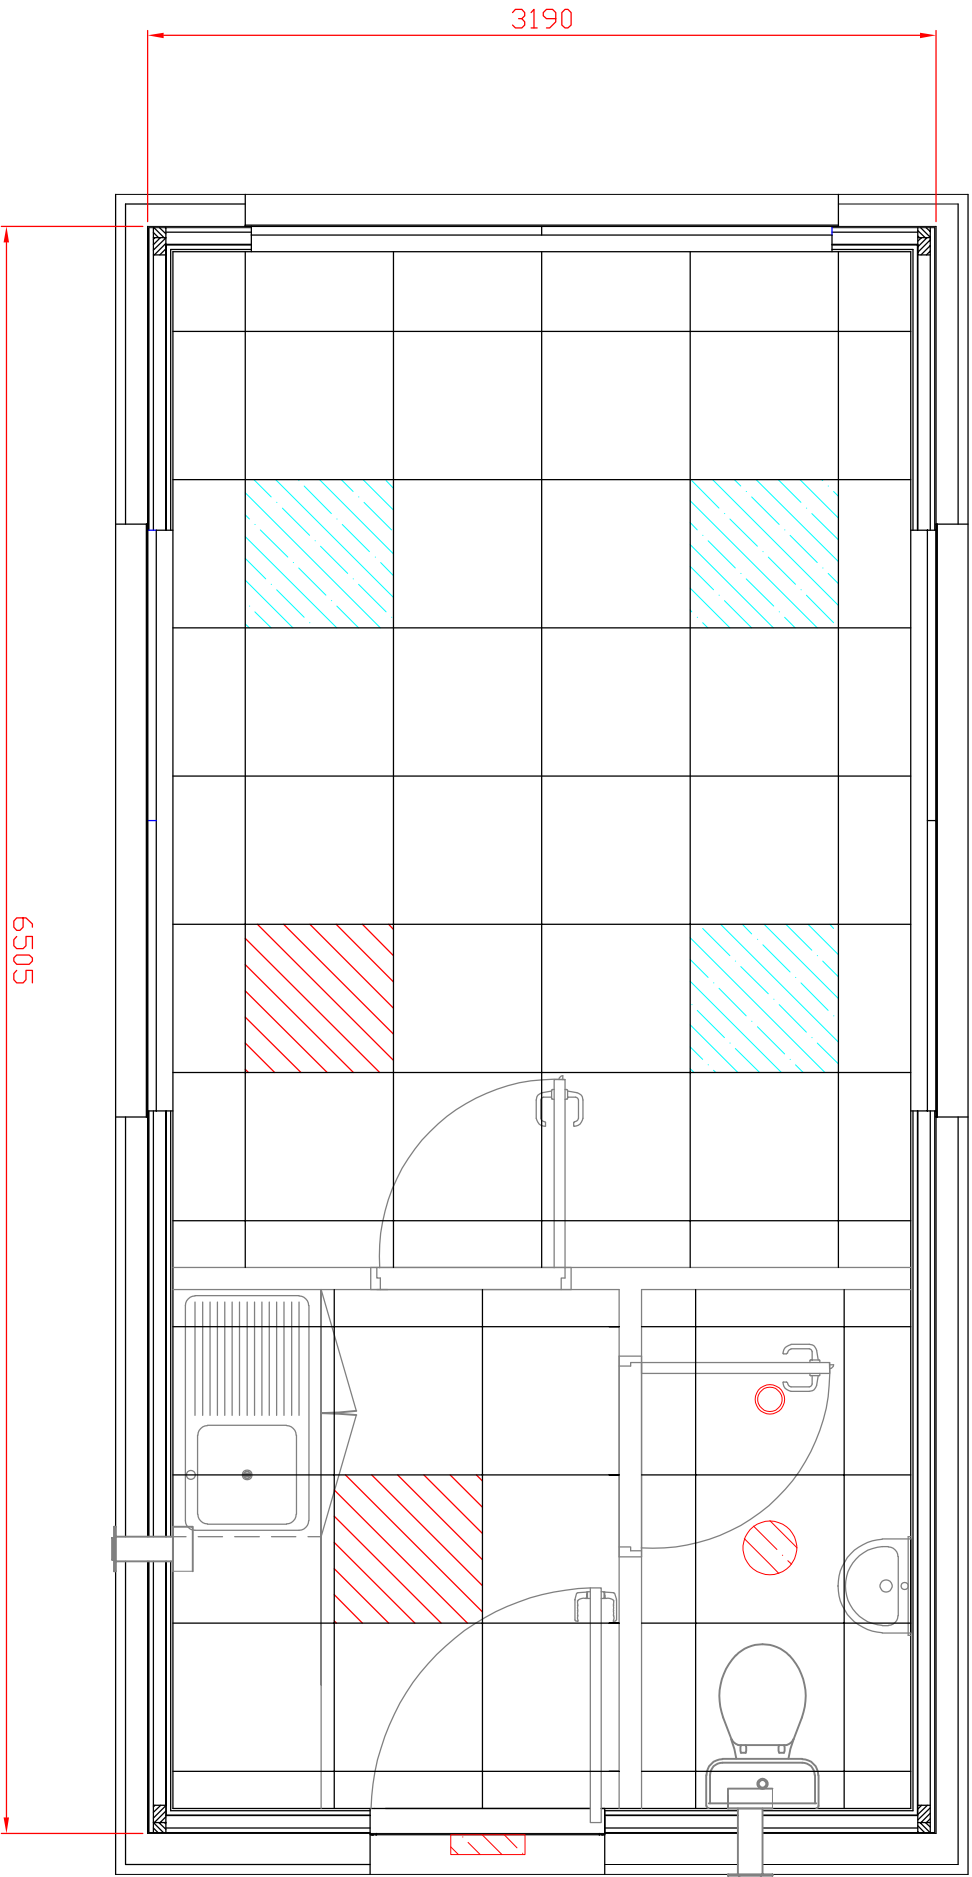

600 X 600
LED LIGHT



ROUND
LED LIGHT
(EMERGENCY)



PIR SENSOR



600 X 600
LED LIGHT
(EMERGENCY)



RECTANGULAR BULKHEAD
LED LIGHT
(EMERGENCY)

REV No.	MODIFICATIONS	DRAWN	DATE

DRAWN	DATE	CLIENT APPROVAL	DATE
J.BUCHANAN	09.06.22		
TITLE: AS BUILT BESPOKE GATEHOUSE 7.00m x 3.60m x 2.80m HIGH LIGHTING GRID			
DRG No. FPL / P21024-FB-XX-00-DR-X-0005-P05 AS BUILT			
MD 02 PROJECT - P21-024 CALDER PARK 016008			
FIBAFORM PRODUCTS LTD. 22 Lonsill Industrial Estate, Cotton Road, Lancaster, LA1 3PD. DESIGNERS AND MANUFACTURERS OF GLASSFIBRE PRODUCTS.			