
P21-024 Calder Park

Drawing Register: Cauntons

Works Completed: Structural Steelwork

Drawing No.	Drawing Title	Rev
P21024-CEL-U1-XX-DR-X-0001	Column Location Plan	AB-01
P21024-CEL-U1-XX-DR-X-0002	Foundation Plan sheet 1 of 2	AB-01
P21024-CEL-U1-XX-DR-X-0003	Foundation Plan sheet 2 of 2	AB-01
P21024-CEL-U1-XX-DR-X-0004	Base Plates Details	AB-01
P21024-CEL-U1-XX-DR-X-0005	Section on Grid line 25	AB-01
P21024-CEL-U1-XX-DR-X-0006	Section on Grid line 24	AB-01
P21024-CEL-U1-XX-DR-X-0007	Section on Grid line R	AB-01
P21024-CEL-U1-XX-DR-X-0008	Warehouse Roof Plan	AB-01
P21024-CEL-U1-XX-DR-X-0009	Office Floor Plans	AB-01
P21024-CEL-U1-XX-DR-X-0010	Elevation on Grid line A	AB-01
P21024-CEL-U1-XX-DR-X-0011	Elevation on Grid line W	AB-01
P21024-CEL-U1-XX-DR-X-0012	Elevation on Grid line 3	AB-01
P21024-CEL-U1-XX-DR-X-0013	Elevation on Grid line 29	AB-01
P21024-CEL-U1-XX-DR-X-0014	Main Office Elevations	AB-01
P21024-CEL-U1-XX-DR-X-0015	Hub Office Plan and Elevations	AB-01
P21024-CEL-U1-XX-DR-X-0016	Office Roof Plans	AB-01
P21024-CEL-U1-XX-DR-X-0017	Door and Window Details	AB-01
P21024-CEL-U1-XX-DR-X-0018	Stair Details	AB-01

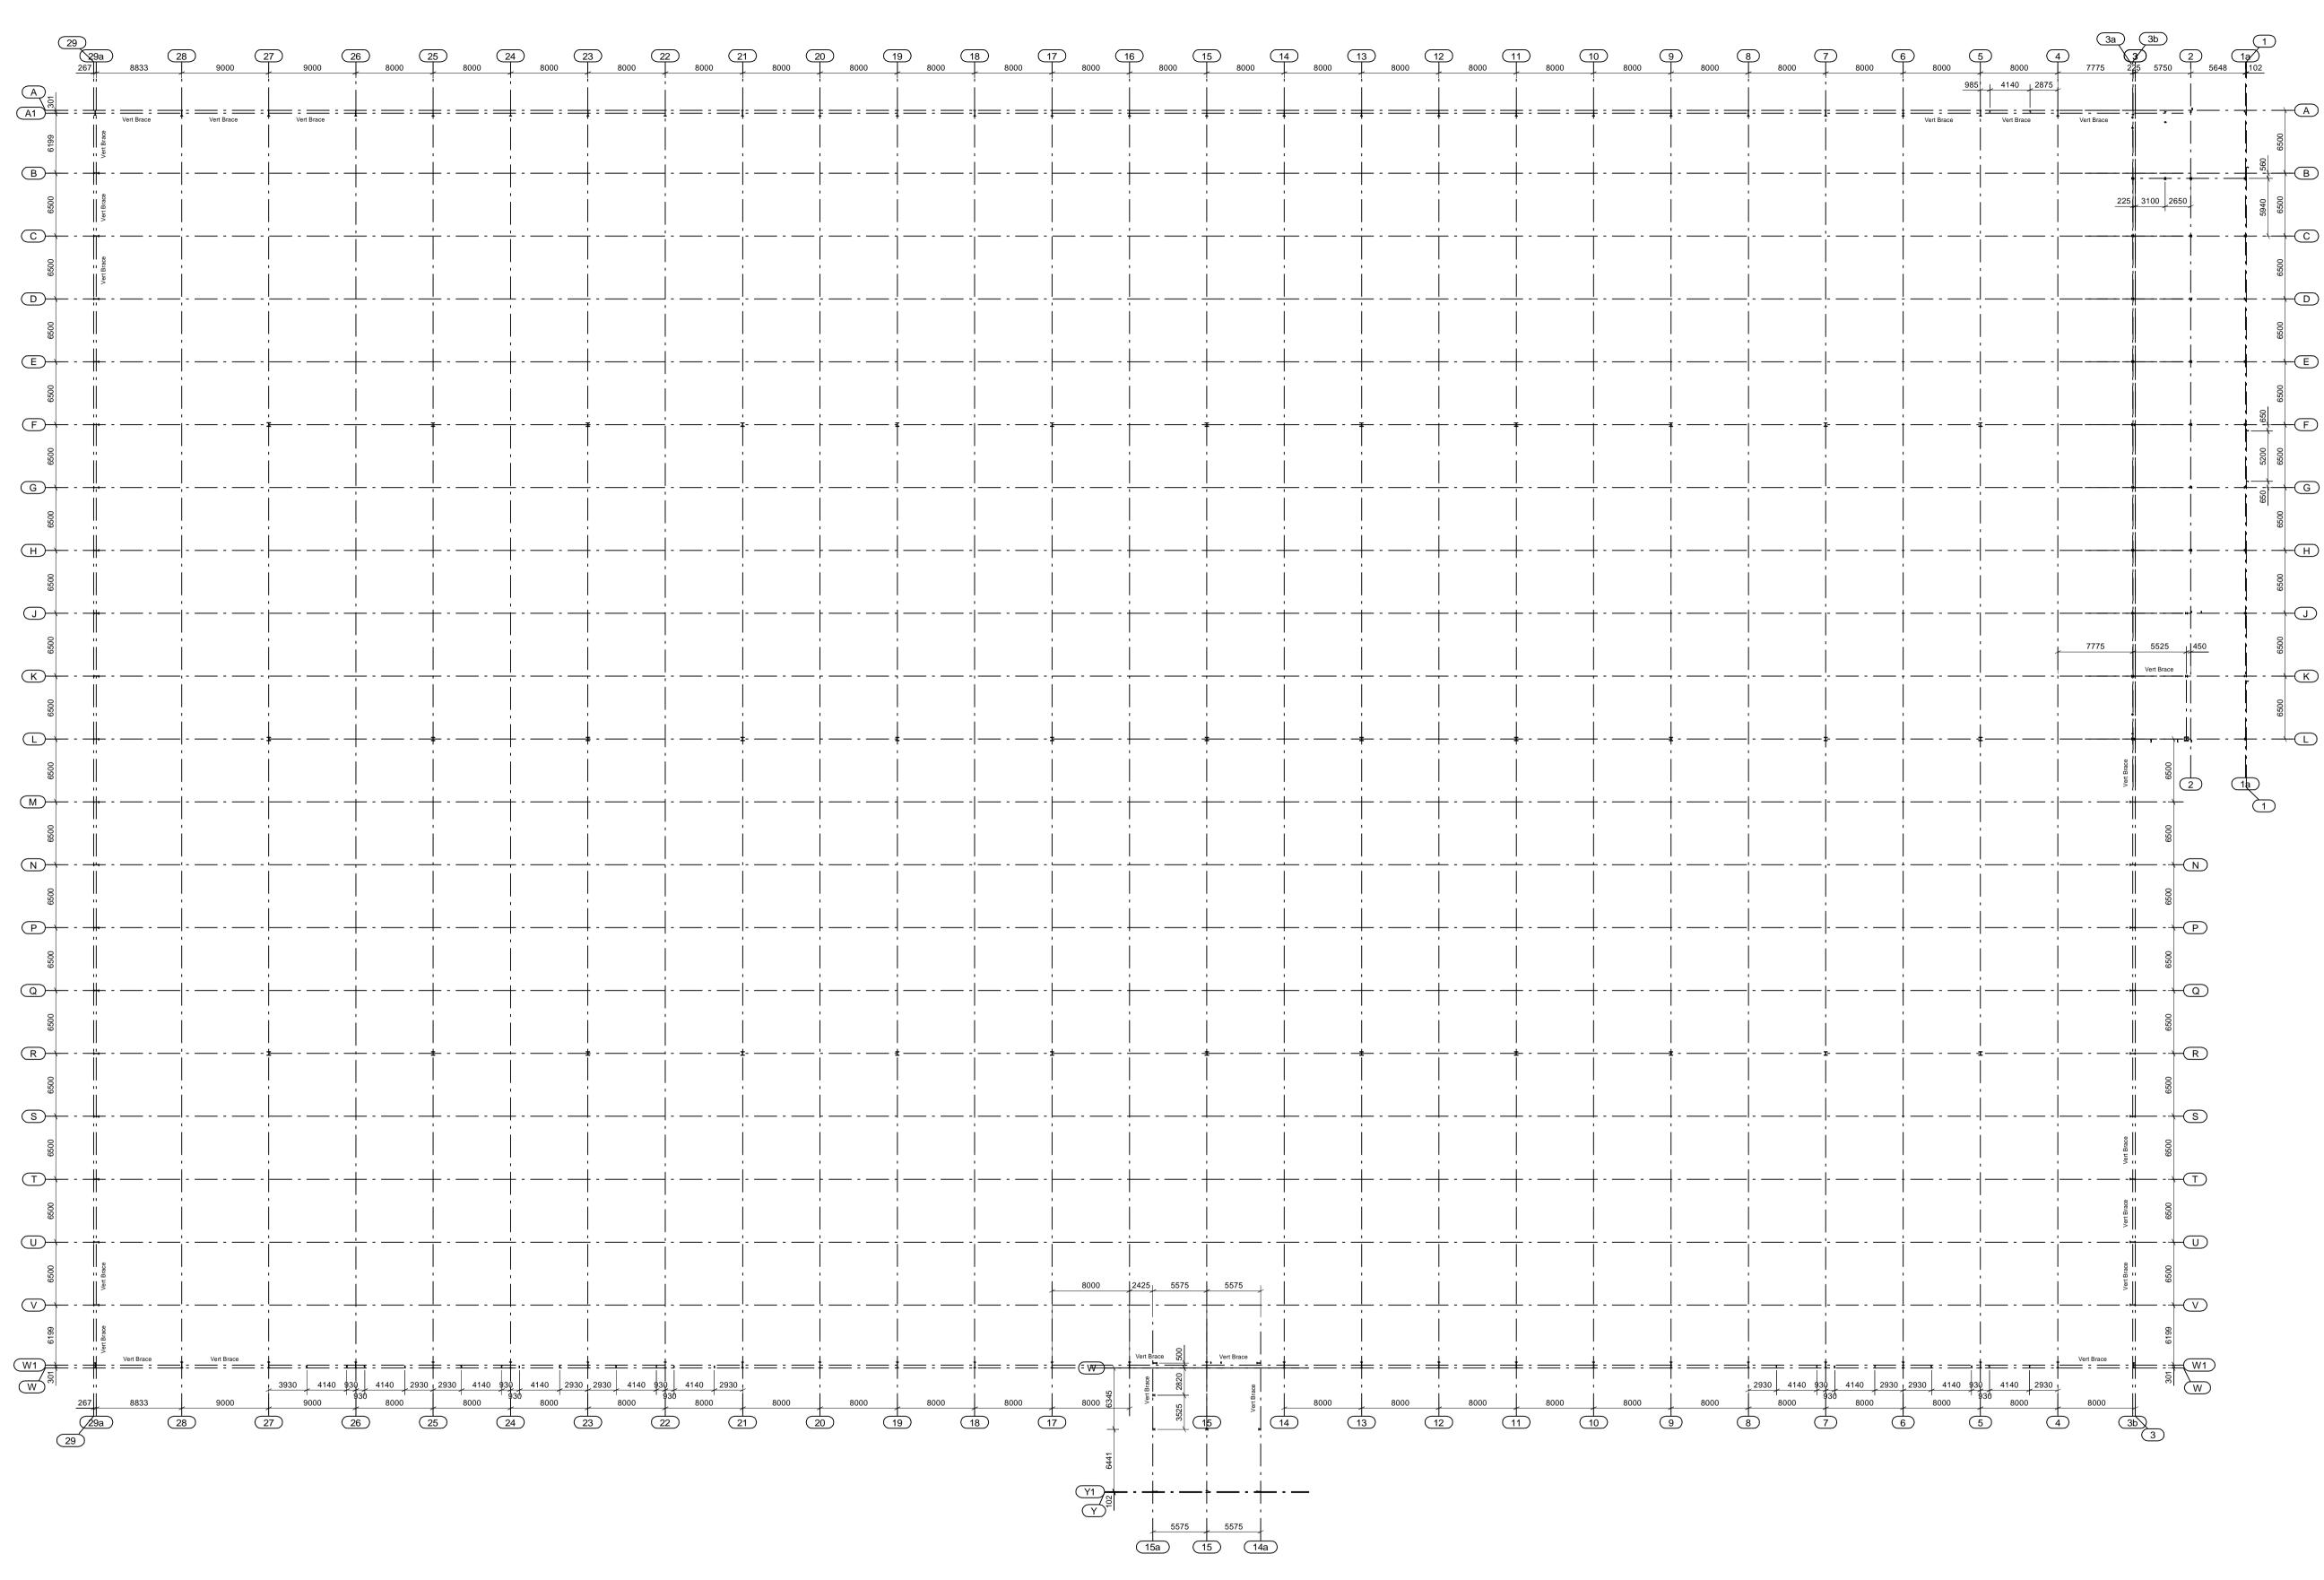

Column Location Plan


Do not scale from this drawing Dimensions are in millimetres unless noted otherwise Erection marks for orientation denoted (M) PDF issues of this drawing are controlled All other formats of this drawing (e.g. DWG/AutoCad) are un-controlled and are used at your own risk. oject Notes Caunton Engineering is not the principal des*** for this project. The Principal Designer for this project has responsibility for approving this drawing. The steel frame shown on this drawing has been designed to 85:6950. The steel frame shown on this drawing will be erected in accordance with the tolerances specified in the current NSSS (National Structural Steelwork Specification) Any queries relating to information on this drawing are to be referred, in the first instance to the Principal Designer. This drawing is to be read in conjunction with all information produced by the Principal Designer, Architect, Engineer and all other specialist trade contractors employed on this project. It is down on this drawing construction interfaces. Any queries soludibe raised with the Principal Designer.	eneral Notes
Caunton Engineering is not the principal des*** for this project. The Principal Designer for this project has responsibility for approving this drawing. The steel frame shown on this drawing has been designed to BS:5950. The steel frame shown on this drawing will be erected in accordance with the tolerances specified in the current NSSS (National Structural Steelwork Specification) Any queries relating to information on this drawing are to be referred, in the first instance to the Principal Designer. This drawing is to be read in conjunction with all information produced by the Principal Designer, Architect, Engineer and all other specialist trade contractors employed on this project. It should not be assumed the steel frame shown on this drawing has been coordinated with other specialist trade contractors regarding construction interfaces. Any queries should be raised with the Principal Designer.	Dimensions are in millimetres unless noted otherwise. All levels are in metres unless noted otherwise Erection mark for orientation denoted O Only PDF issues of this drawing are controlled All other formats of this drawing (e.g. DWG/AutoCad}
for this project. The Principal Designer for this project has responsibility for approving this drawing. The steel frame shown on this drawing has been designed to 85:5950. The steel frame shown on this drawing will be erected in accordance with the tolerances specified in the current NSSS (National Structural Steelwork Specification) Any queries relating to information on this drawing are to be referred, in the first instance to the Principal Designer. This drawing is to be read in conjunction with all information produced by the Principal Designer, Architect, Engineer and all other specialist trade contractors employed on this project. It should not be assumed the steel frame shown on this drawing has been coordinated with other specialist trade contractors regarding construction interfaces. Any queries should be raised with the Principal Designer.	roject Notes
	for this project. The Principal Designer for this project has responsibility for approving this drawing. The steel frame shown on this drawing has been designed to 85:5950. The steel frame shown on this drawing will be erected in accordance with the tolerances specified in the current NSSS (National Structural Steelwork Specification) Any queries relating to information on this drawing are to be referred, in the first instance to the Principal Designer. This drawing is to be read in conjunction with all information produced by the Principal Designer, Architect, Engineer and all other specialist trade contractors employed on this project. It should not be assumed the steel frame shown on this drawing has been coordinated with other specialist trade contractors regarding construction interfaces. Any queries should be raised with the Principal Designer.

AO

IF IN DOUBT - ASK!


- 8. It is the responsibility of all specialist trade contractors that depend upon the steel frame for support to ensure they understand the tolerances defined in the current NSSS. Other specialist trade contractors must make provision in the design and construction of their works, including checking dimensions and positions on site if necessary, to deal with any potential conflict of tolerances which may arise.


AB01	As-Built Issue		30.06.2022	
C01	Construction Issue		13.10.2021	
P01	Preliminary Issue		14.07.2021	
REV. MARK	REVISION DESCRIPTION	l	REV. DATE	
	STATUS :	APPROVAL I	SSUE	
	Caun Moo Moorgree TEL: 01773	Caunt Engineering Limited orgreen Idustrial Park n, Nottingham. NG16 30U S31111 FAX: 01773-5320. www.caunton.co.uk ait drawing@caunton.co.uk	NEERING	
Client Winvic ( Project Des Calder				
Site Address Wakefie				
Drawing Title Column Location Plan				
Scale 1:250			CEL Job No. 21009	
Drawn by MatrixC		Project Type Design & Build	Date Created 14.07.2021 Date Reviewed	
Designed Ri	ewewed by		Date Revewed	
Project	Company Volume Le	vel Type Role Drawing No.	Revision	

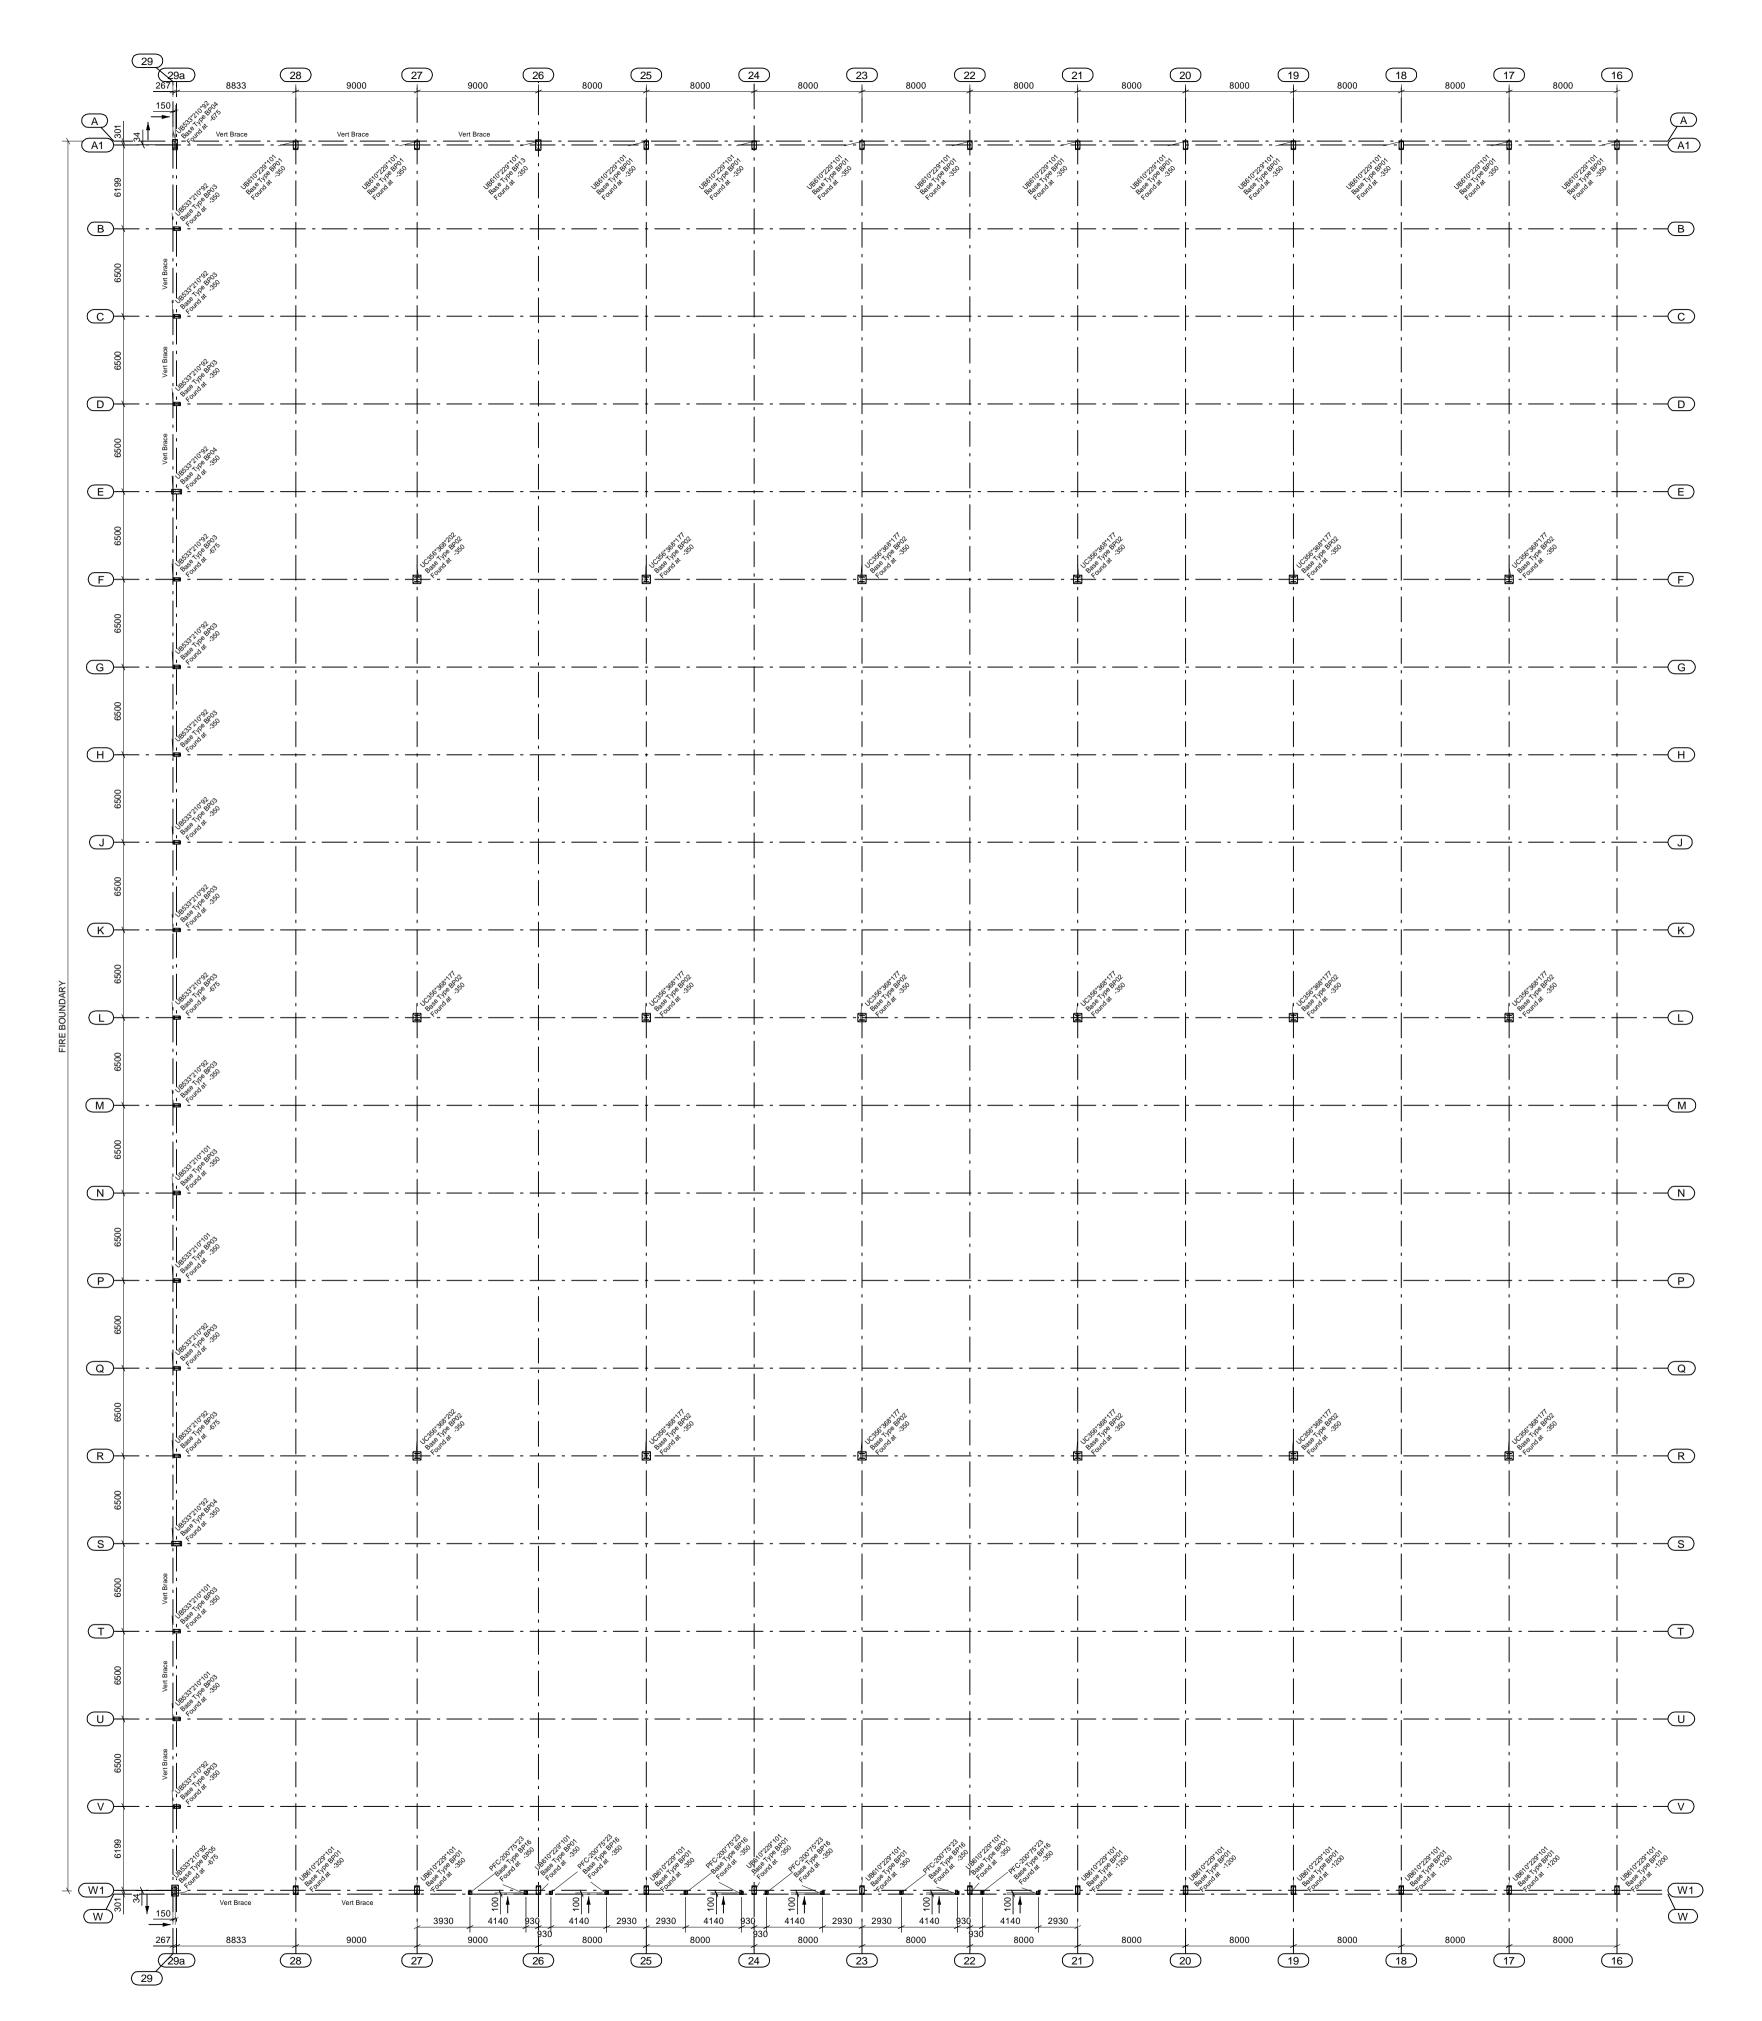


Foundation Plan

		_
	IF IN DOUBT - ASK! No copies to be taken without the permittation of Cauttion Engineering General Notes	2
	1. Do not scale from this drawing 2. Dimensions are in millenetres unless noted otherwise. 3. All levels are in metres unless noted otherwise 4. Erection mark for orientation denoted 5. Only JPDF issues of this drawing are controlled	
	6. All other formats of this drawing {e.g. DWG/AutoCad} are un-controlled and are used at your own risk. Project Notes	-
	<ol> <li>Caunton Engineering is not the principal des*** for this project.</li> <li>The Principal Designer for this project has responsibility for approving this drawing.</li> <li>The stele frame shown on this drawing has been</li> </ol>	
	<ul> <li>designed to BS:5950.</li> <li>The steel frame shown on this drawing will be erected in accordance with the tolerances specified in the current NSSS (National Structural Steelwork</li> </ul>	
	Specification) 5. Any queries relating to information on this drawing are to be referred, in the first instance to the Principal Designer. 6. This drawing is to be read in conjunction with all	
	information produced by the Principal Designer, Architect, Engineer and all other specialist trade contractors employed on this project. 7. It should not be assumed the steel frame shown on this drawing has been coordinated with other	
	<ul> <li>and stawing has been coolunated with the pecialist trade contractors regarding construction interfaces. Any queries should be raised with the Principal Designer.</li> <li>It is the responsibility of all specialist trade contractors that depend upon the steel frame for</li> </ul>	
	contractors that depend updnt the site internet of support to ensure they understand the tolerances defined in the current NSSS. Other specialist trade contractors must make provision in the design and construction of their works, including checking dimensions and positions on site if necessary, to	
	deal with any potential conflict of tolerances which may arise. Foundation Notes	-
	Setting out and Tolerances 1. All grid lines and datum levels are to be established and maintained throughout the steel frame erection period by the Principal Contractor. 2. Only Caunton Engineering drawings should be	
	used to set out holding down bolts and washer plates. 3. The setting out tolerances for all holding down bolts and cast foundation levels is to be in accordance with Section 9.1 of the NSSS.	
	<ol> <li>If post drilled resin or mechanical anchors are shown on the drawings they are to be installed strictly in accordance with the manufacturers' instructions.</li> <li><u>Construction Sequence</u></li> </ol>	
	<ol> <li>All holding down bolts, resin/mechanical anchors and washer plates shown on Caunton Engineering drawings are supplied and delivered to site by Caunton Engineering.</li> <li>If post drilled resin or mechanical anchors are shown</li> </ol>	
	or the drawings and are to be installed before steel erection starts they will be delivered to site with the holding down bolts. 7. Marking out and drilling of concrete for resin or mechanical anchors is to be by others.	
	<ol> <li>Holding down bolts are strength grade 8.8</li> <li>Conical bolt tubes must be placed around each H.D. bolt to form a pocket that will allow full rotational movement of the bolt at the top of the pocket.</li> </ol>	
	These are not supplied by Caunton Engineering. 10. All holding down bolts, washer flats and tubes should be placed in the required position before concrete is poured. 11. All threads to be thoroughly greased and protected before concrete is noured.	
	protected before concrete is poured. 12. All foundations must have a smooth and level surface onto which steel packing plates can be placed when steel erection starts. 13. Every holding down both must be able to move in the	
	pocket so they should be checked and if necessary shaken after concrete is poured and before it hardens. 14. Pockets must be kept clear of debris to ensure holding down bolts can move.	
	15. All timber templates used to cast the foundations are to be removed by the Principal Contractor or groundworks contractor prior to steel erection starting. 16. If polystyrene bolt tubes are used they must be	
	removed by the Principal Contractor or groundworks contractor prior to steel erection starting. <u>Damage to Holding Down Bolts</u> 17. If any holding down bolt is damaged after installation	
	17. If any noting boom boirs a damaged after installation the Principal Contractor must report the matter to Caunton Engineering. 18. If a grade 8.8 holding down bolt is bent after installation no attempt should be made to straighten it as this may lead to the bolt fracturing.	
	Grouting of Bases 19. The organisation responsible for designing foundations is also responsible for specifying the	
	product to be used to grout the holding down bolts and underside of column bases. 20. After the structure has been lined, levelled & plumbed by Caunton Engineering, to the tolerances stated in Section 9.6 of the NSSS, it will be handed over to the Principal Contractor for final checking	
	over to the Principal Contractor for final checking and grouting. 21. Al columns must be grouted within 24 hours of being handed over. Caunton Engineering is not responsible for grouting of columns.	
	C. LEVEL	
	CONECLEDCL TUBES (WOTHERS)	
	TYPICAL H.D. BOLT DETAIL	
		- 1
Der	notes direction of column offset from grid	
—► Der	notes direction of column offset from grid	
—► Der	notes direction of column offset from grid	
→ Der	notes direction of column offset from grid	
→ Der	notes direction of column offset from grid	
- Der	notes direction of column offset from grid	
Der	notes direction of column offset from grid	
- Der	notes direction of column offset from grid	
Der	notes direction of column offset from grid	
- Der	notes direction of column offset from grid	
Der	notes direction of column offset from grid	
Der	notes direction of column offset from grid	
Der	notes direction of column offset from grid	
- Der	notes direction of column offset from grid	
Der	notes direction of column offset from grid	
- Der	notes direction of column offset from grid	
Der	otes direction of column offset from grid	
Der	Αδθ1         ΛδωΠτιχω         2006.202           Ο         Construction Koue         1130.201	
Der	A801         As Sull Issue         300.402           C01         Construction Issue         200.402           C01         Exercision Issue         100.2021           R02         Bell Tissue         100.2021           R04         Exercision Issue         100.2021           R05         Bell Tissue Issue         100.2021           R06         R06.01         EXERCISION ISSCERPTION         REV DATE	
Der	A801         As-Balit Issan         306.202           C01         Construction Issan         101.922           C01         Den Virgen and Schül Grick Addd         101.922	
Der		
Der		
Der		
Der	Abiiiiiiiiiiiiiiiiiiiiiiiiiiiiiiiiiiii	

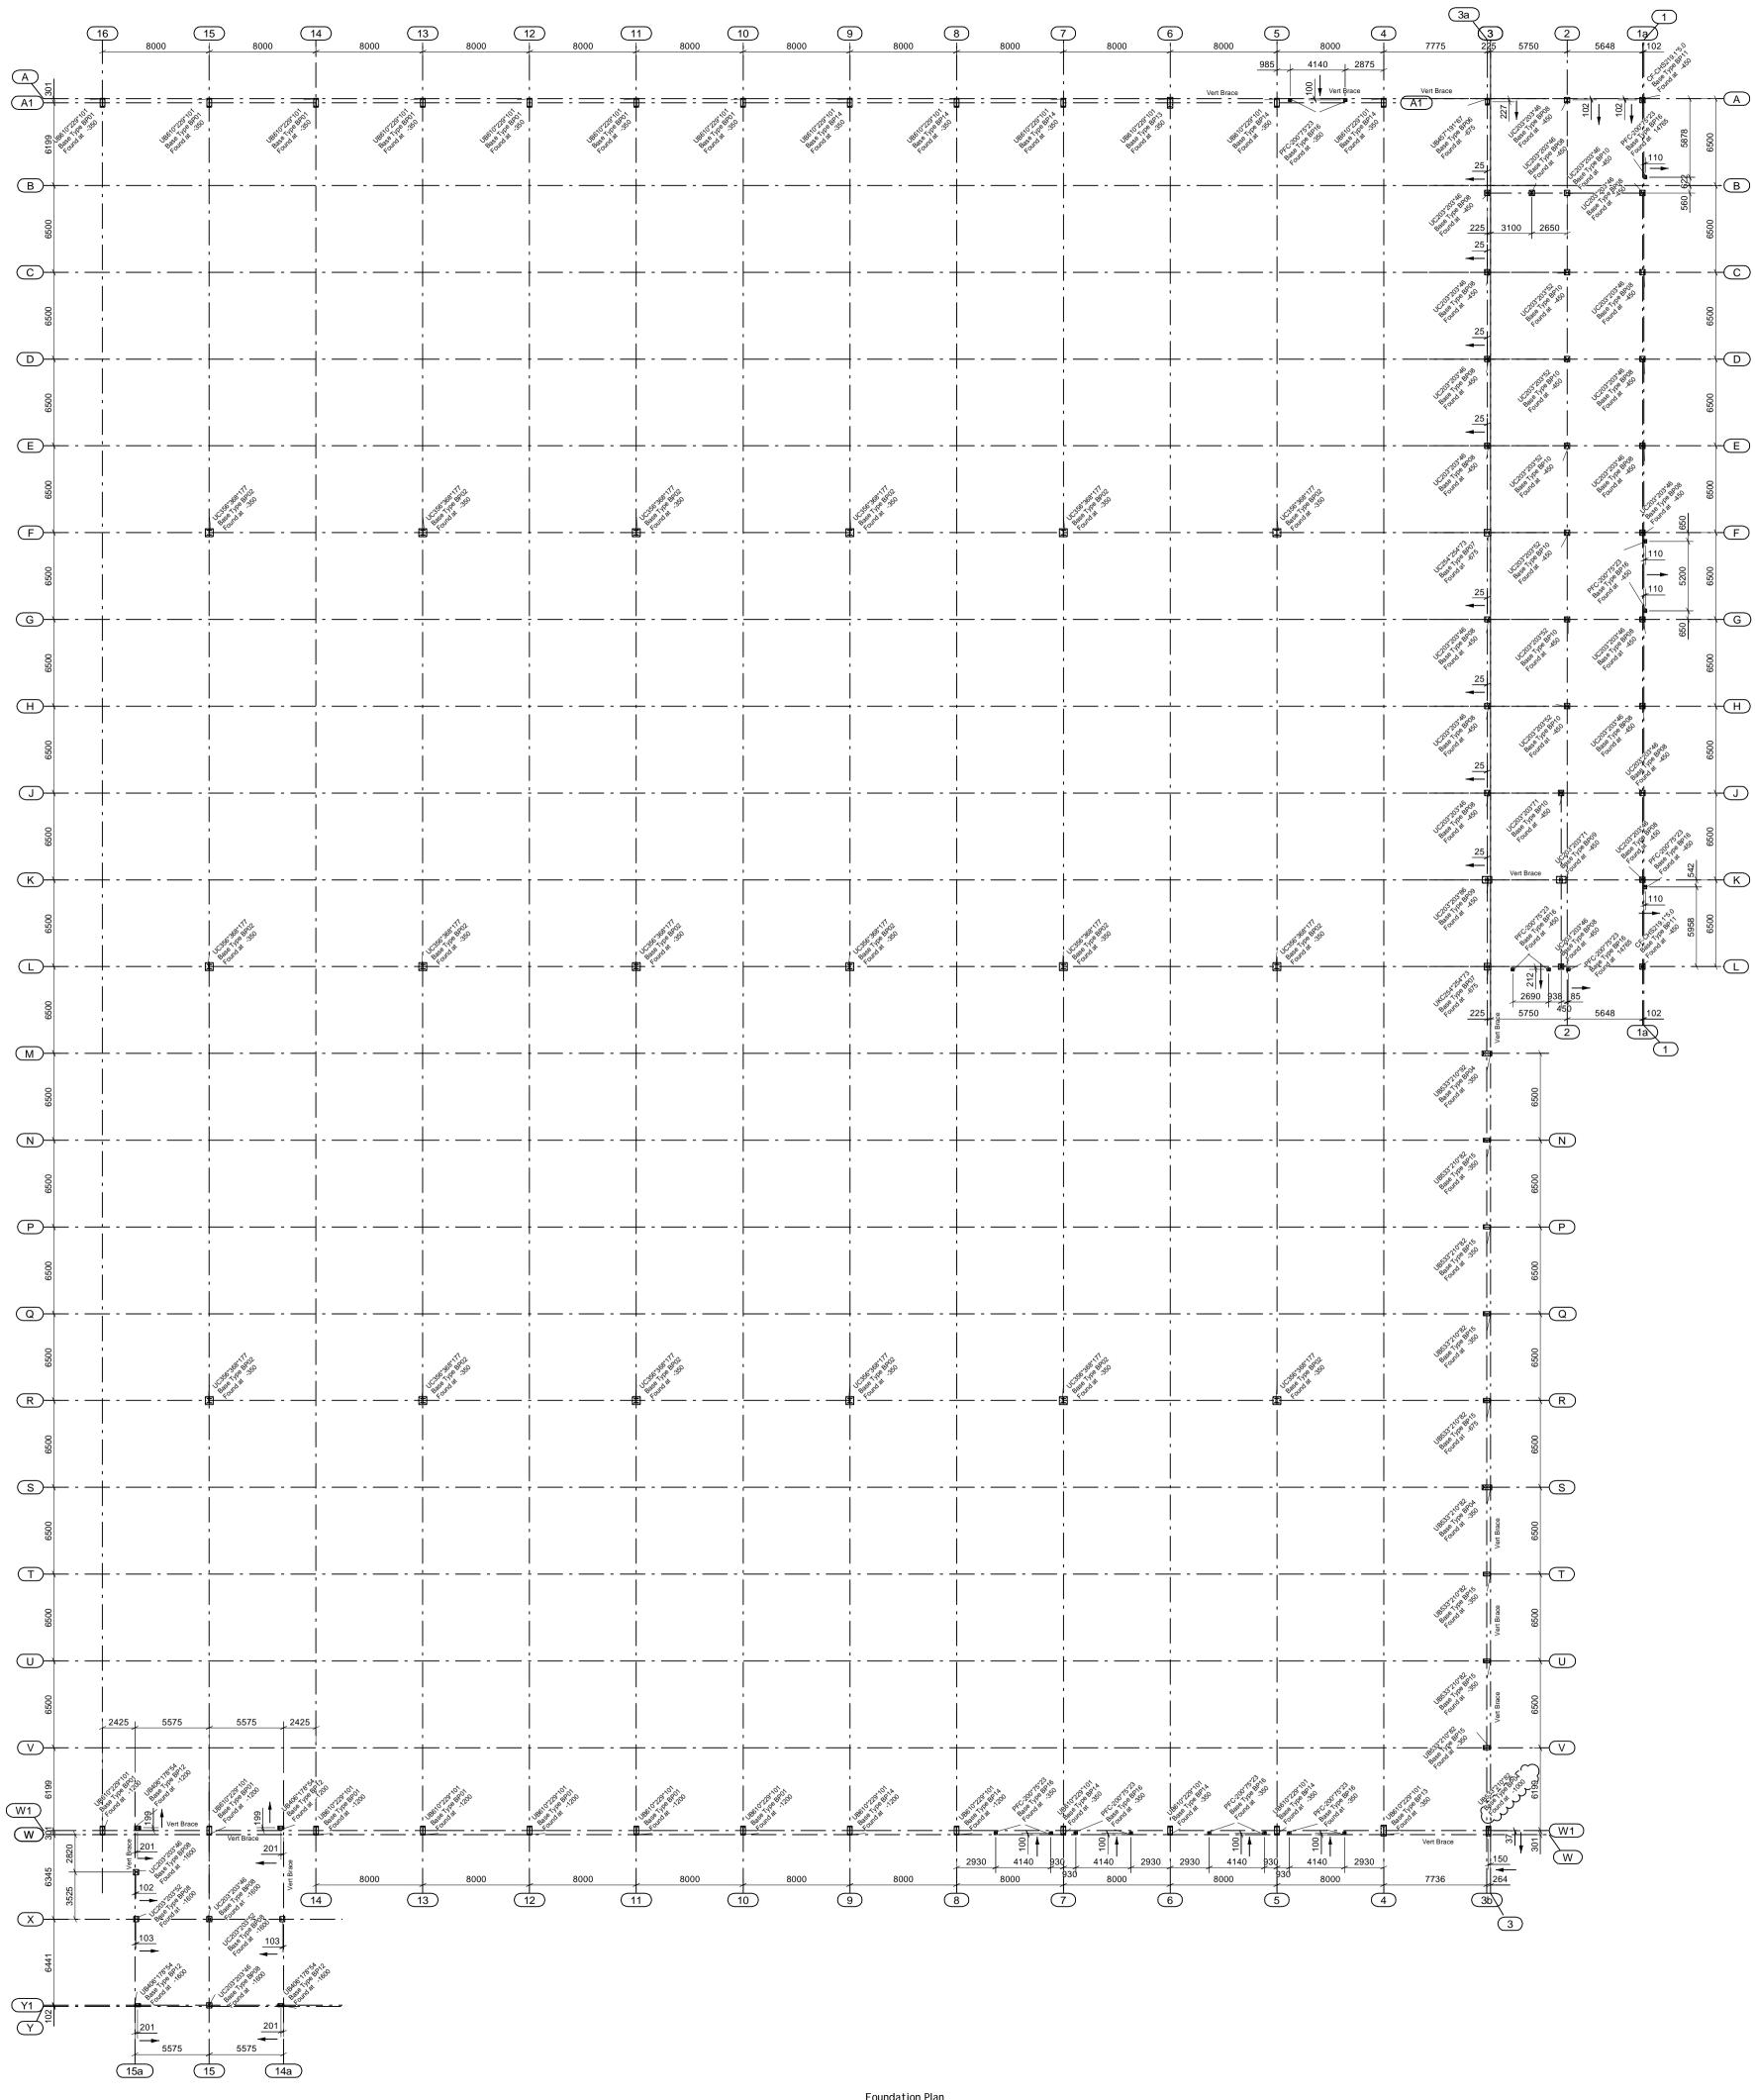

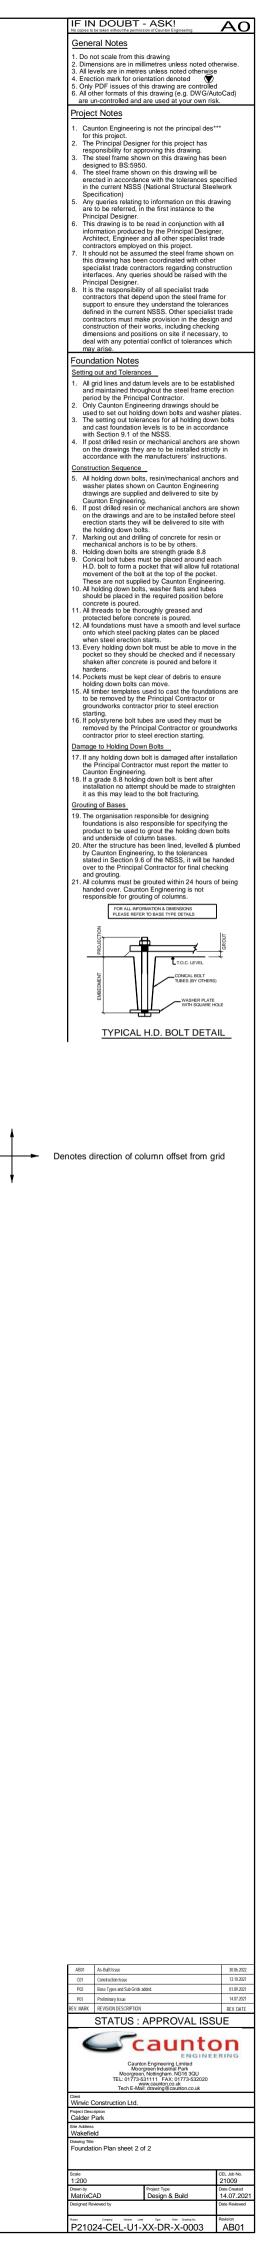


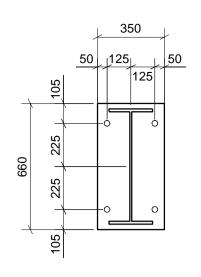

Base Type BP01


610x229x101 UB HD Bolt type SQ SQ O X Bolt size M24x450 Gr 8.8 HD Bolt Qty 4 Embedment 350mm Projection 100mm Base plate 350x660x20mm Washer plate 120Sq x 20 thk Weld see calc sheet Grout 25mm non shrink

35 N/mm²

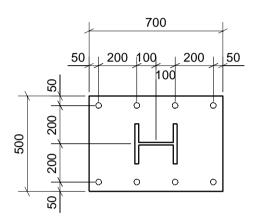


Base Type BP09

203x203x46 L	JC
HD Bolt type	SQ SQ O X
Bolt size	M24x450 Gr 8.8
HD Bolt Qty	350mm
Embedment	100mm
Projection	500x700x25mm
Base plate	120Sq x 20 thk
Washer plate	see calc sheet
Weld	25mm non shrink
Grout	35 N/mm <sup>2</sup>

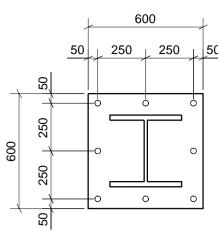


Base Type BPO2




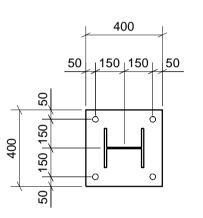


### Base Type BP10



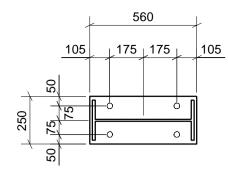


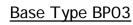



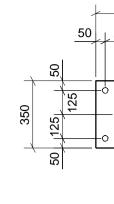


Weld Grout

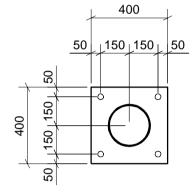

Base Type BP11

	219.1x5.0 CH HD Bolt type Bolt size HD Bolt Qty Embedment Projection Base plate Washer plate Weld Grout	S SQ SQ O X M24x450 Gr 8.8 4 350mm 100mm 400x400x20mm 120Sq x 20 thk see calc sheet 25mm non shrink 35 N/mm <sup>2</sup>
--	--	--

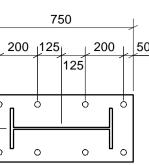




see calc sheet


35 N/mm²

25mm non shrink

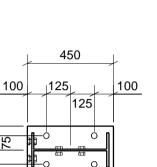


# Base Type BP12

Bolt size HD Bolt Qty Embedment Projection Base plate Washer plate Weld Grout	SQ SQ O X M24x450 Gr 8.8
--	-----------------------------

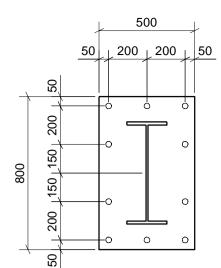


Base Type BP05

533x210x82,92 UB HD Bolt type SQ SQ O X Bolt size M24x450 Gr 8.8 HD Bolt Qty 10 Embedment 35 350mm Projection 100mm 500x800x20mm Base plate Washer plate 120Sq x 20 thk Weld Grout see calc sheet 25mm non shrink 35 N/mm²

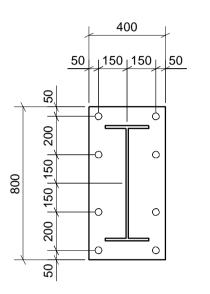


# Base Type BP13

610x229x101 HD Bolt type Bolt size HD Bolt Qty Embedment Projection Base plate Washer plate Weld Grout	SQ SQ O X M30x600 Gr 8.8 8 475mm 125mm 400x800x20mm 150Sq x 25 thk see calc sheet 25mm non shrink
Grout	25mm non shrink 35 N/mm <sup>2</sup>
	33 IV/IIII1*

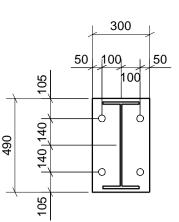


Base Type BP06

Bolt size HD Bolt Qty Embedment Projection Base plate Washer plate	B SQ SQ O X M30x600 Gr 8.8 4 475mm 125mm 300x490x20mm 150Sq x 25 thk see calc sheet 25mm non shrink 35 N/mm <sup>2</sup>
---	--

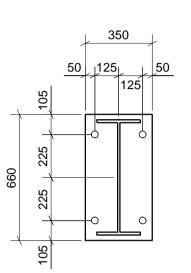


# Base Type BP14

610x229x101 HD Bolt type Bolt size HD Bolt Qty Embedment Projection Base plate Washer plate Weld Grout	UB SQ SQ O X M30x600 Gr 8.8 4 475mm 125mm 350x660x25mm 150Sq x 25 thk see calc sheet 25mm non shrink 35 N/mm <sup>2</sup>
	35 N/mm²

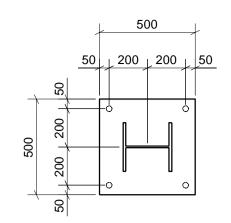


# Base Type BP07



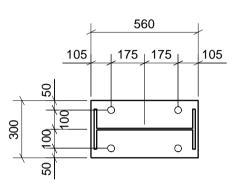


## Base Type BP15


533x210x82,92 UBHD Bolt typeSQ SQ O XBolt sizeM30x600 Gr 8.8HD Bolt Qty4Embedment475mmProjection125mmBase plate300x560x15mmWasher plate150Sq x 25 thkWeldsee calc sheetGrout25mm non shrin35 N/mm²	I
--	---

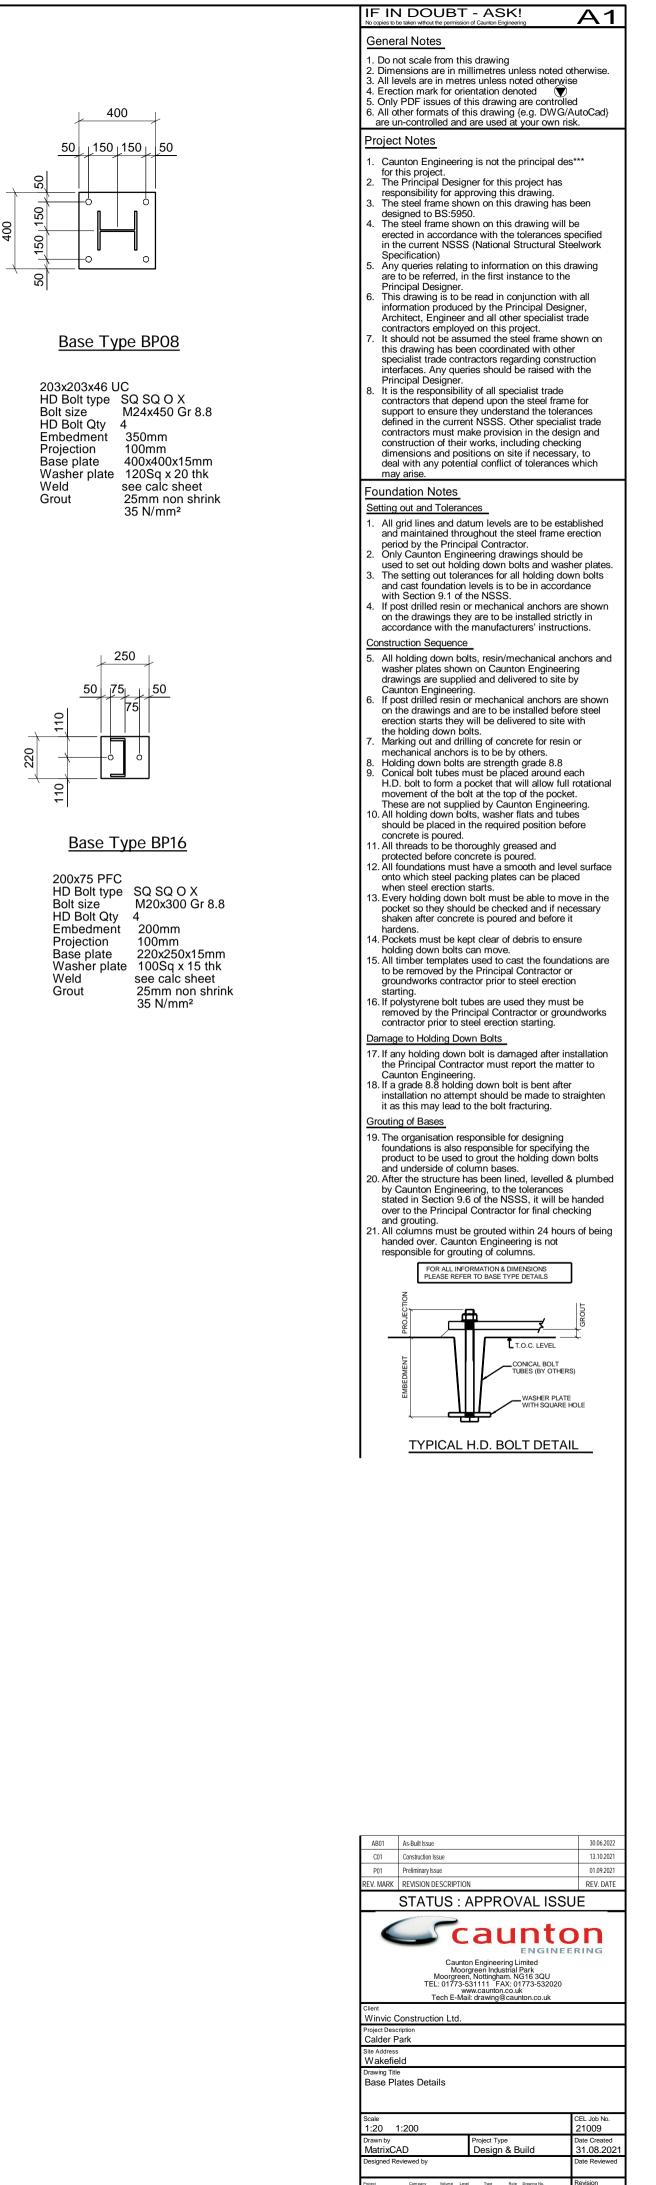


P21024-CEL-U1-XX-DR-X-0004 AB01

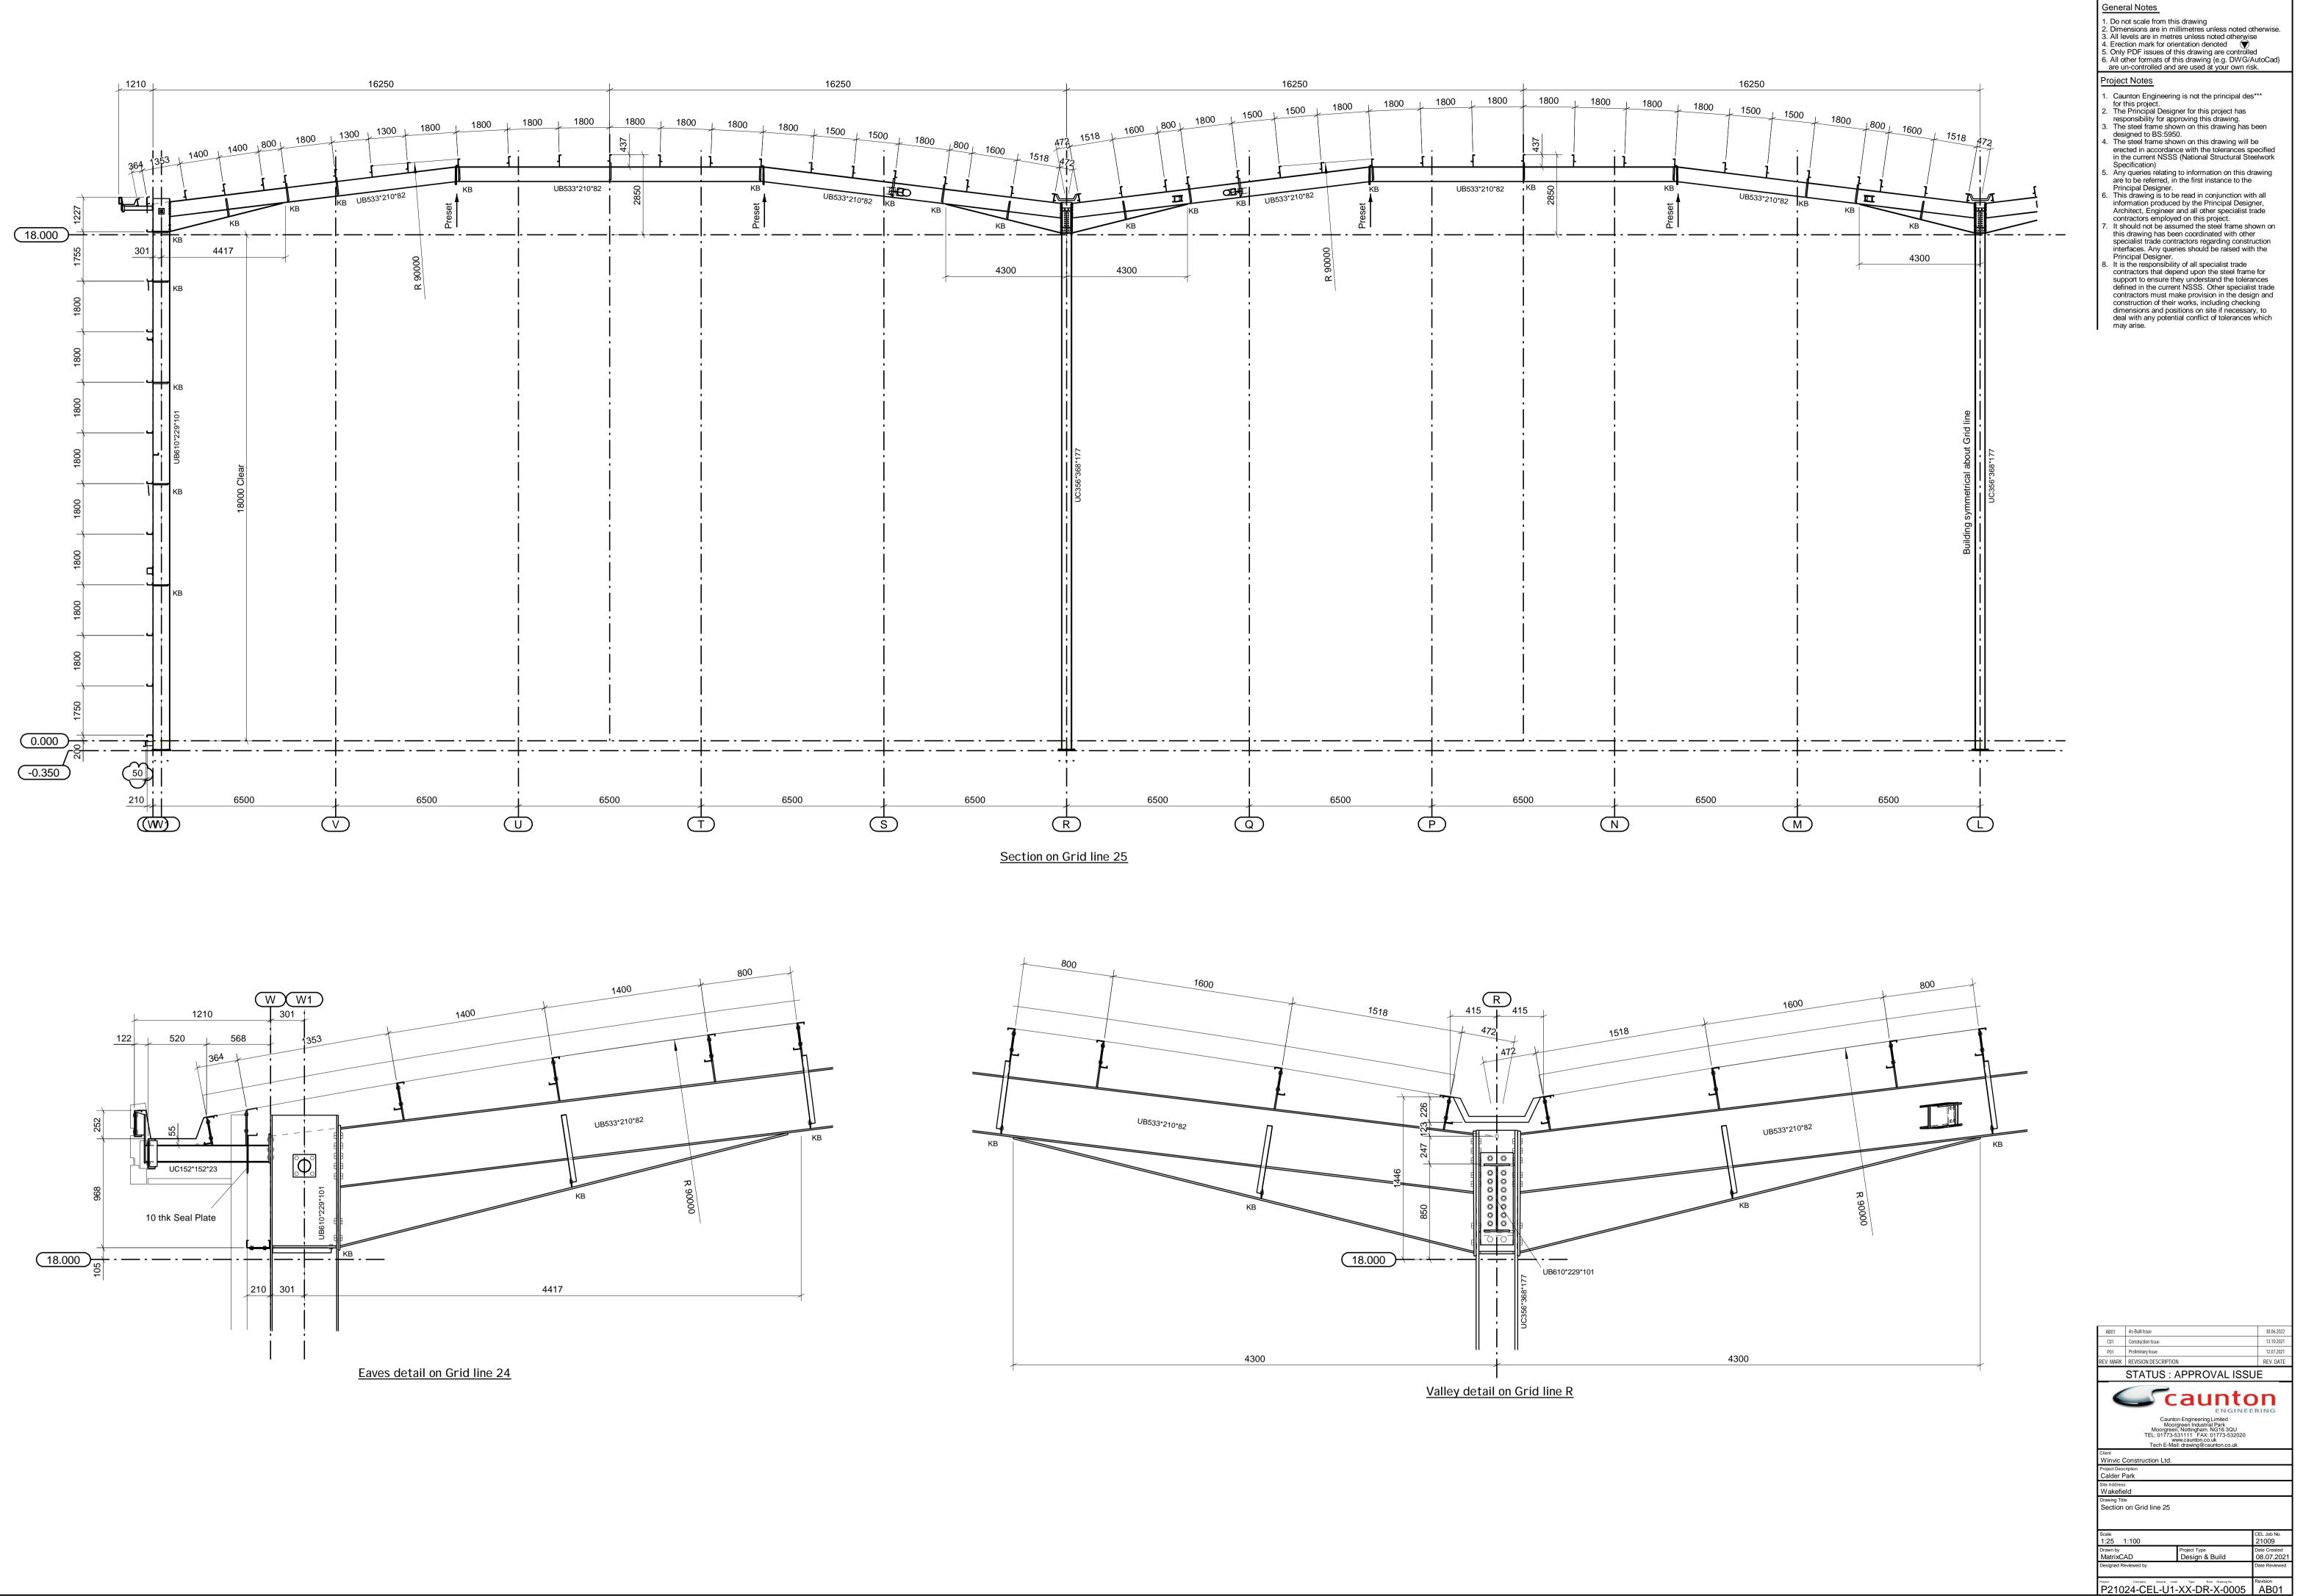


IF IN DOUBT - ASK!

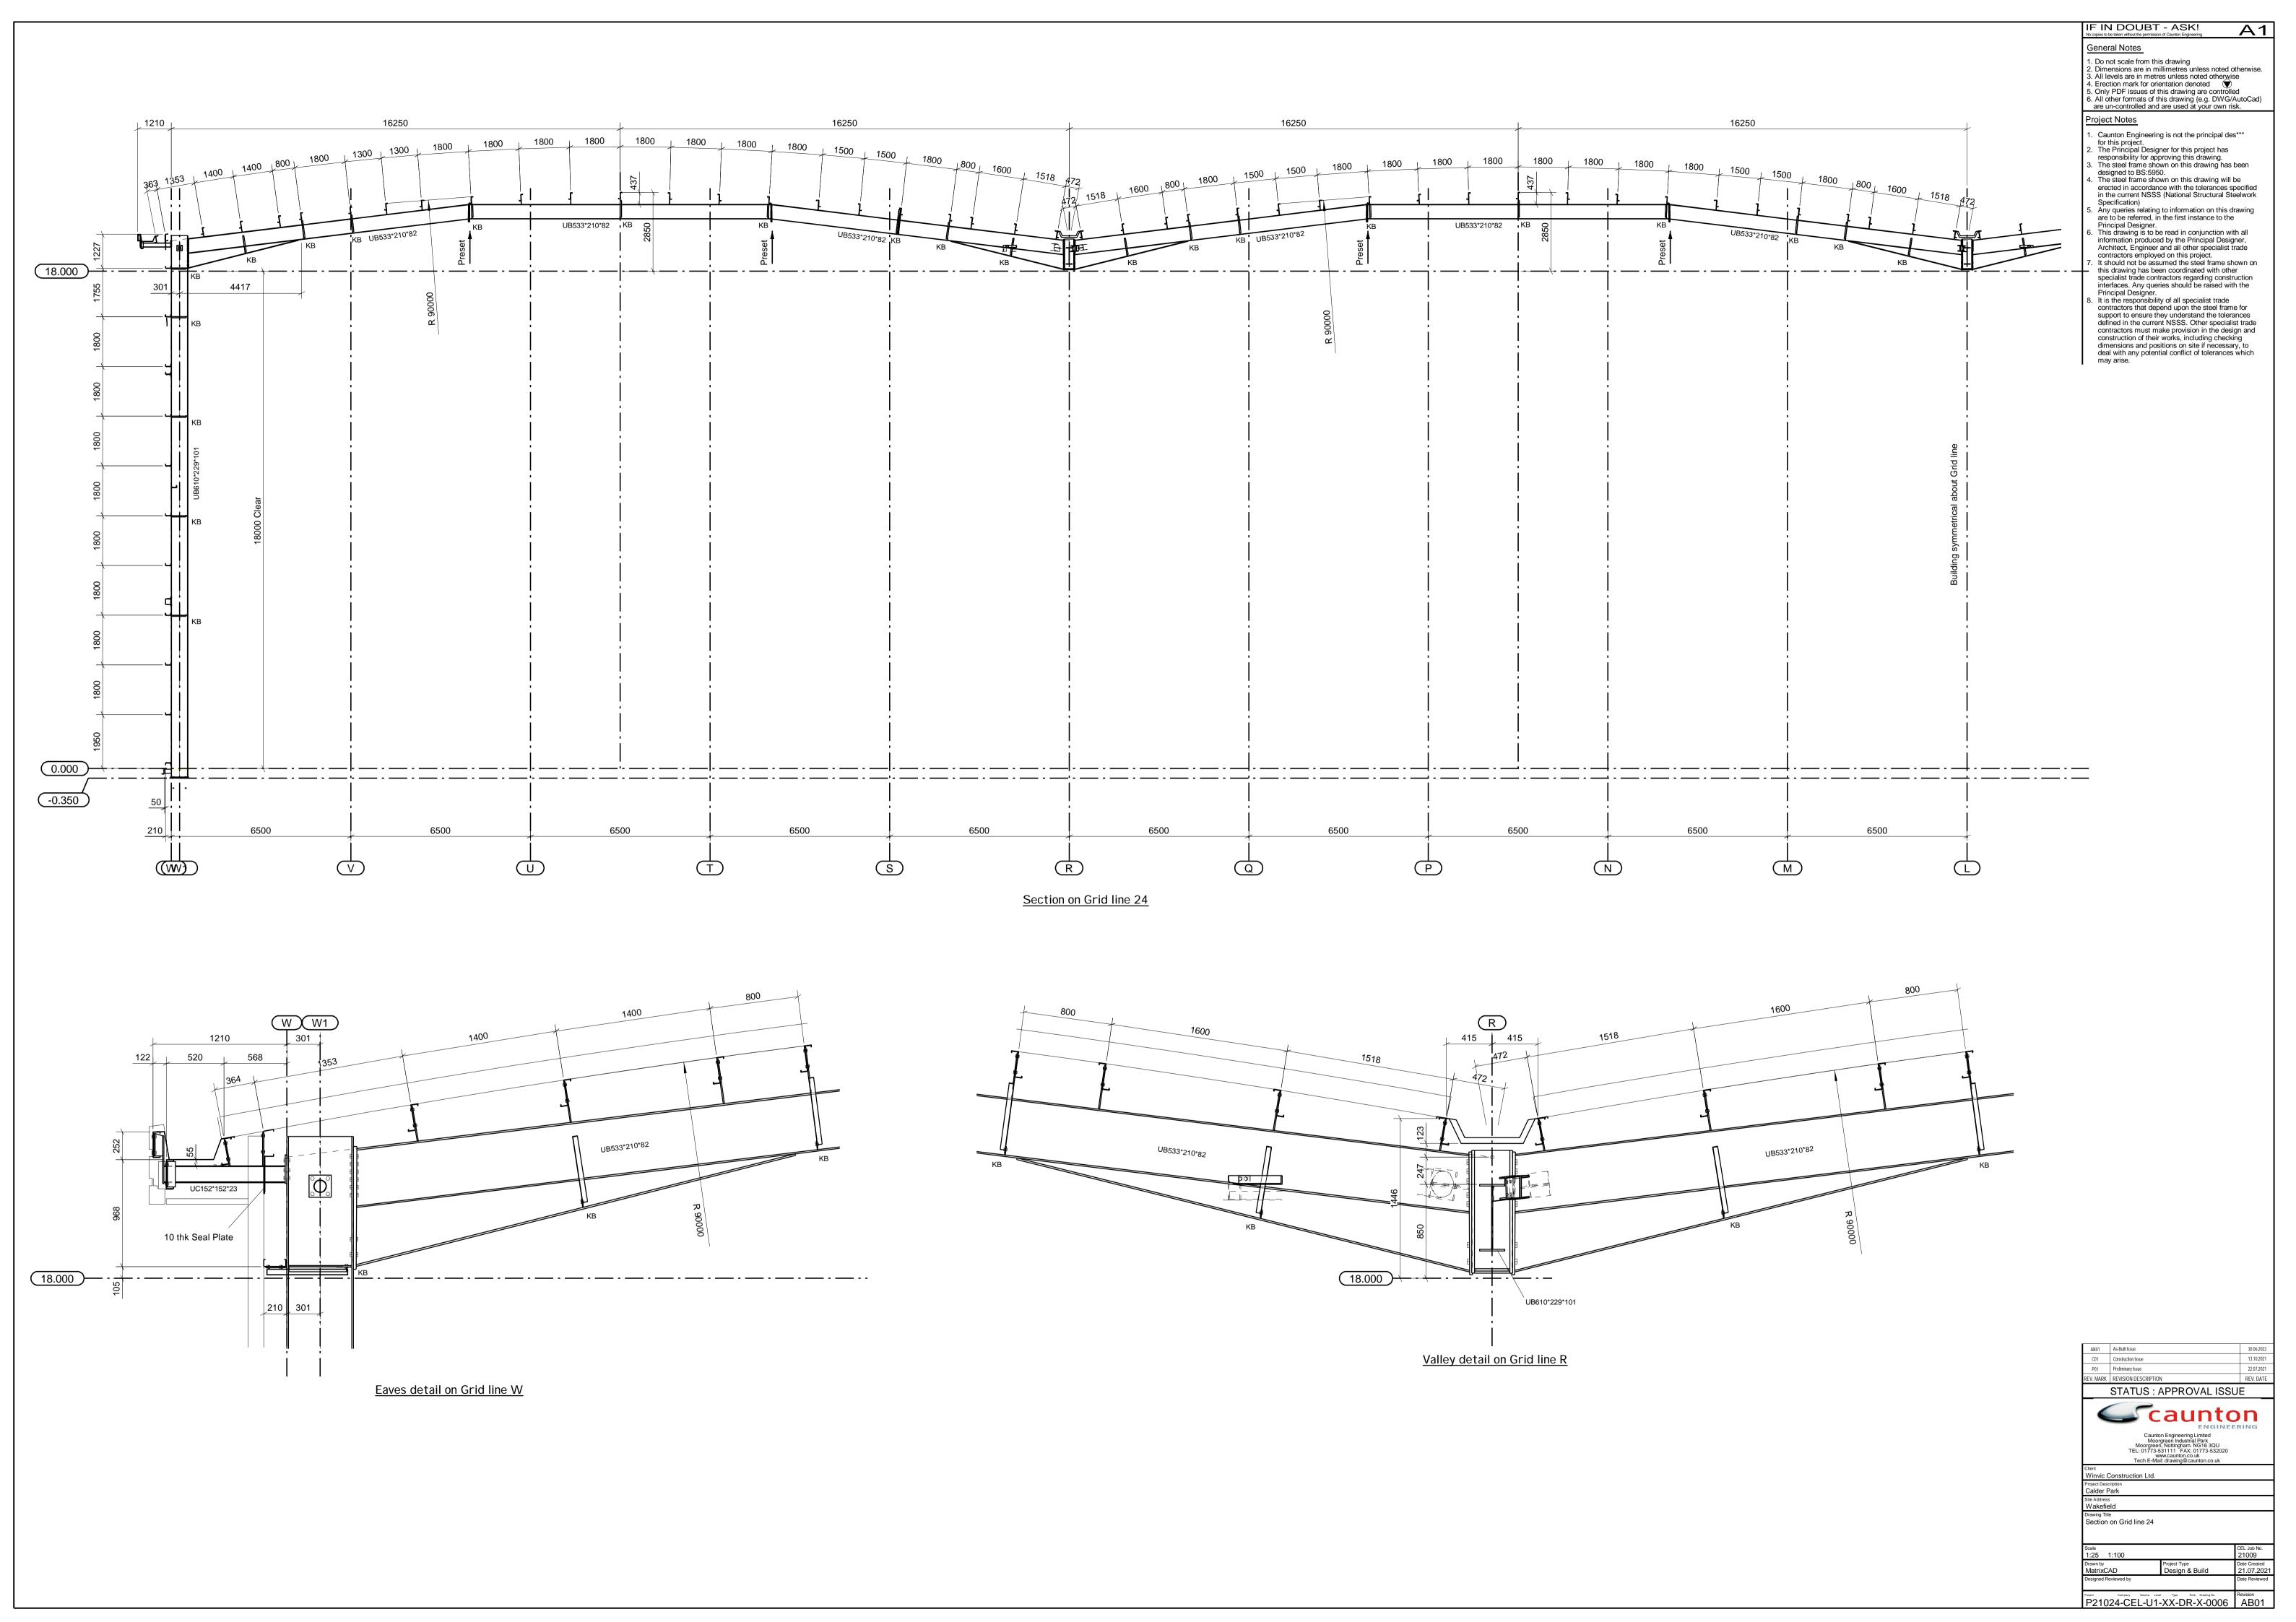


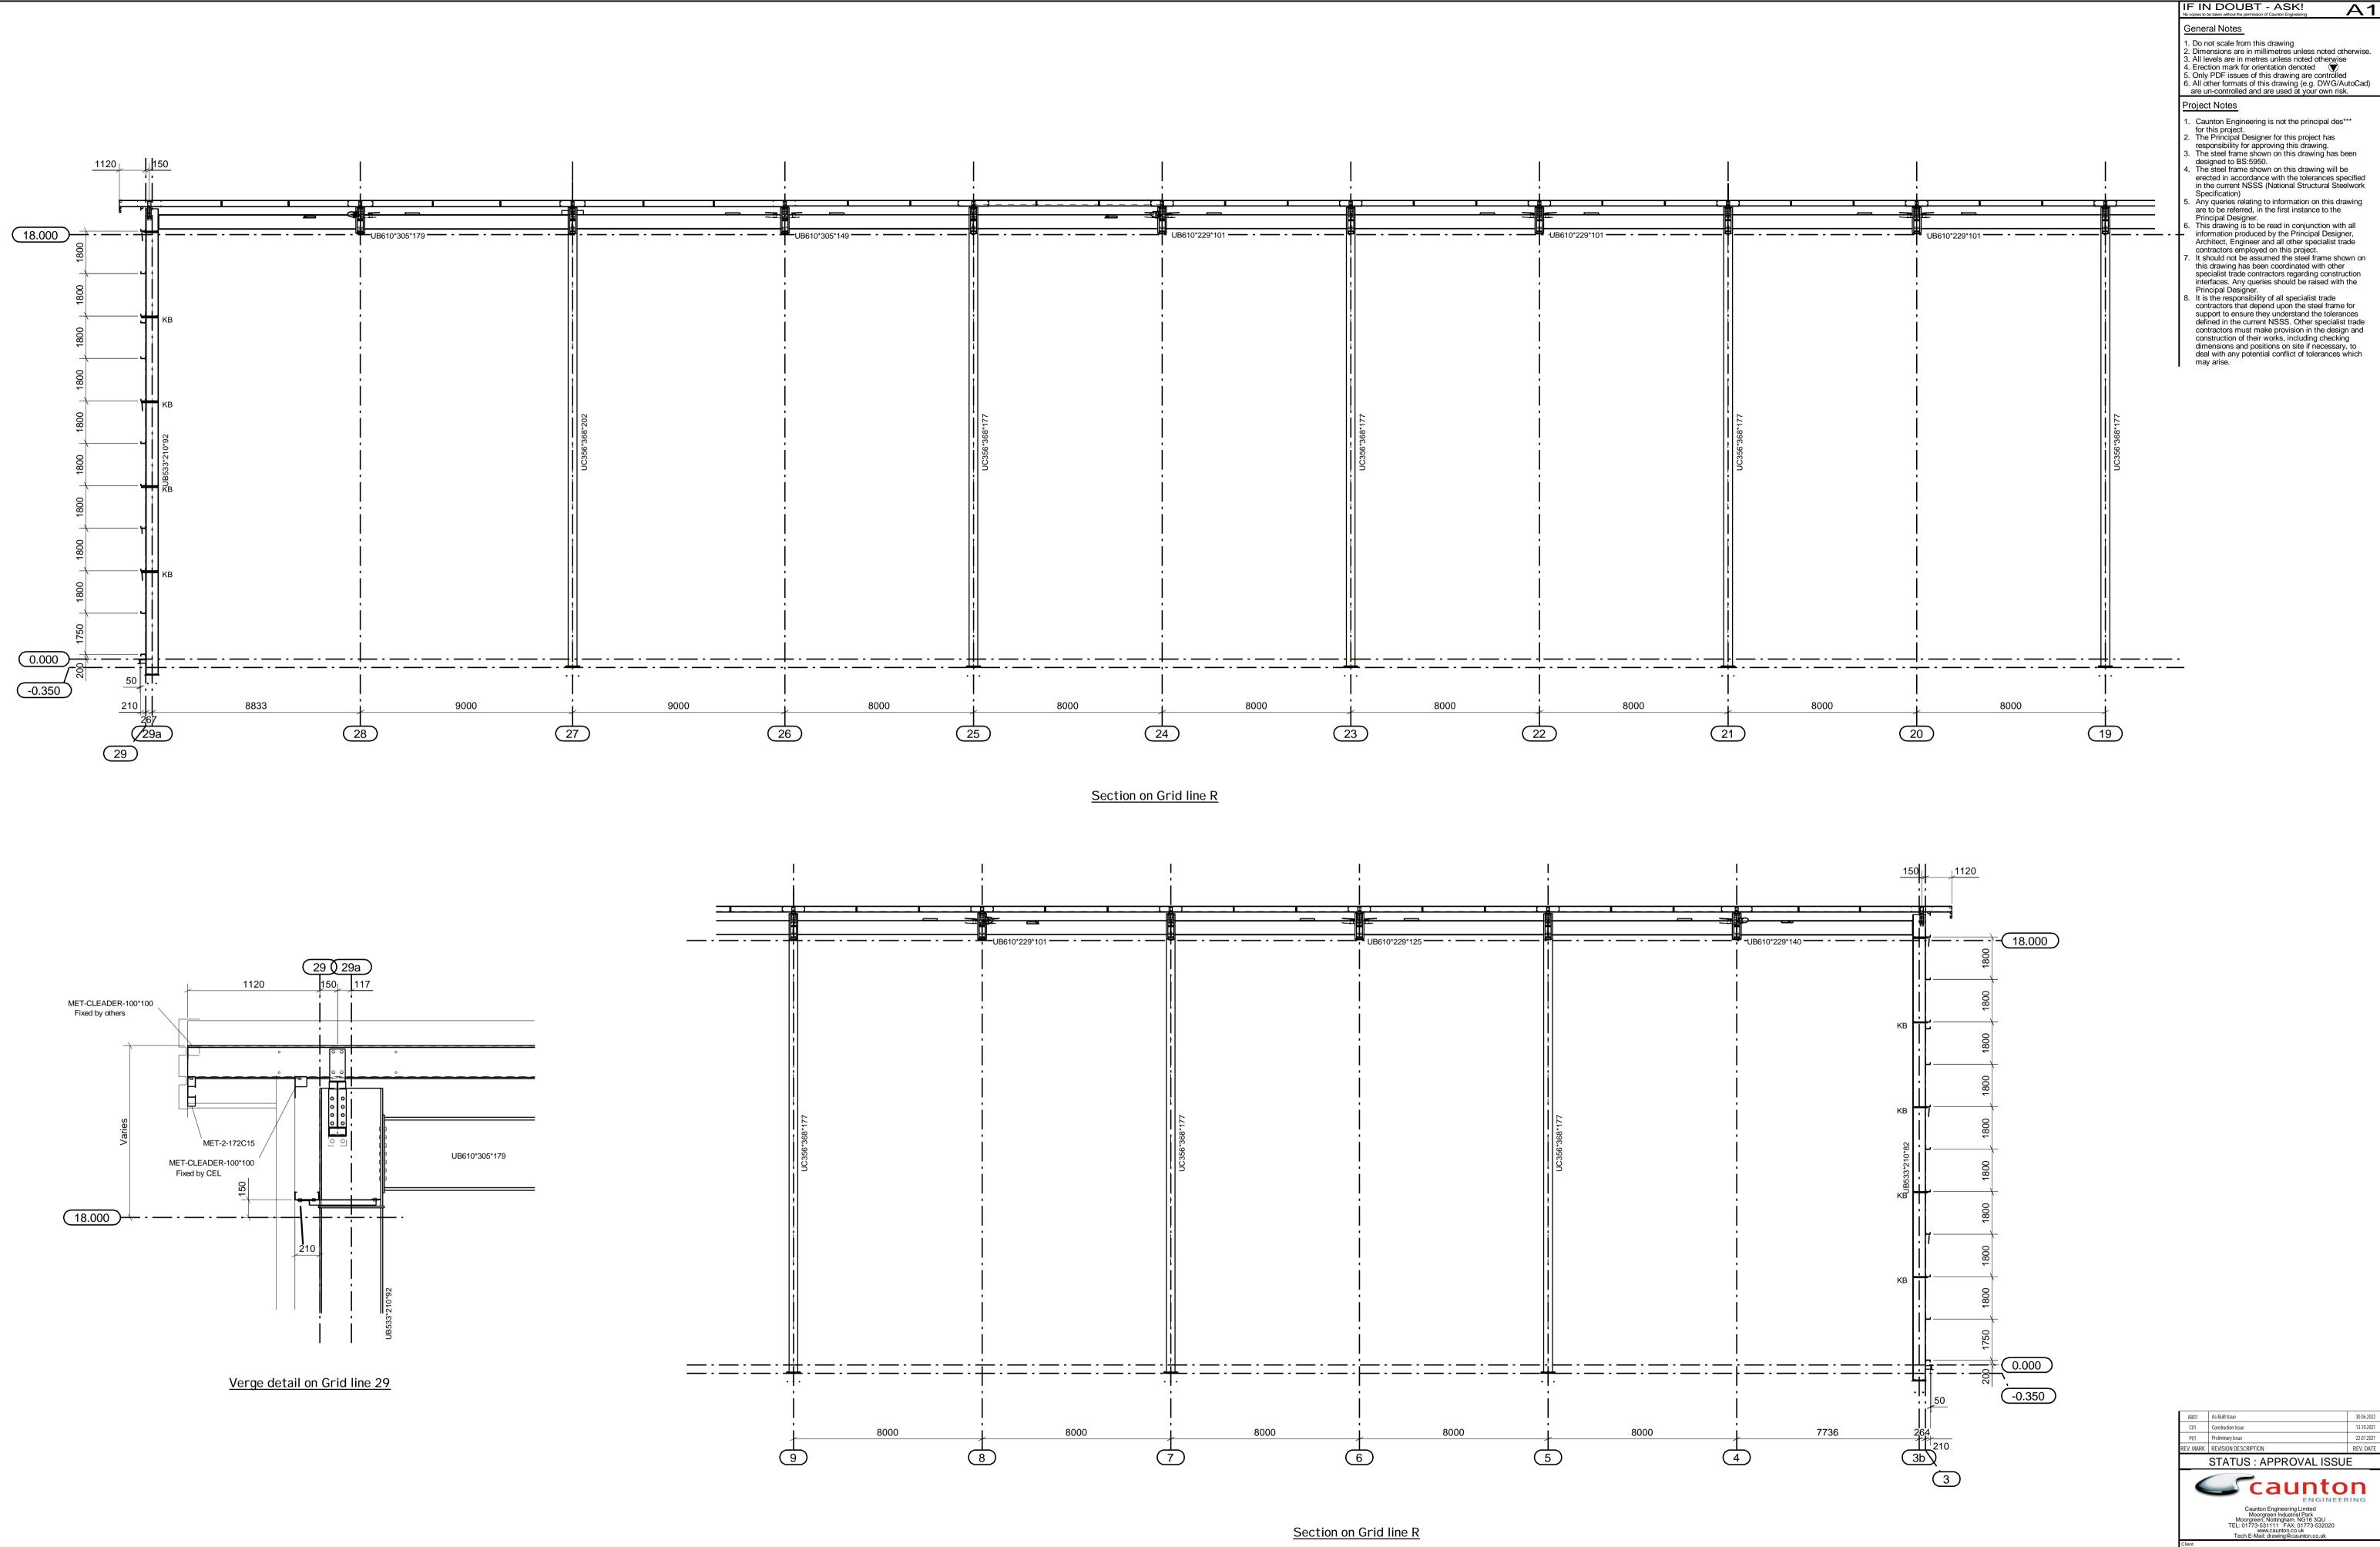


AB01	As-Built Issue		30.06.2022	
C01 Construction Issue			13.10.2021	
P01	Preliminary Issue		22.07.2021	
REV. MARK	REVISION DESCRIPTION	١	REV. DATE	
	STATUS : A	APPROVAL ISSU	Ē	
Caunton Engineering Limited Moorgreen Industrial Park Moorgreen, Nottingham. NG16 30U TEE: 1773-532111 FAX: 01773-532020 www.caunton.co.uk Teche F-Mait drawing@caunton.co.uk				
	construction Ltd.			
Project Desc Calder P				
Site Address Wakefie				
	Drawing Title Section on Grid line R			
Scale         CEL Job No.           1:25         1:125         21009				
Drawn by MatrixC/	AD	Project Type Design & Build	Date Created 19.07.2021	
Designed Reviewed by			Date Reviewed	
Project P210	Project Company Volume Level Tips Role Dawing No. P21024-CEL-U1-XX-DR-X-0007 AB01			

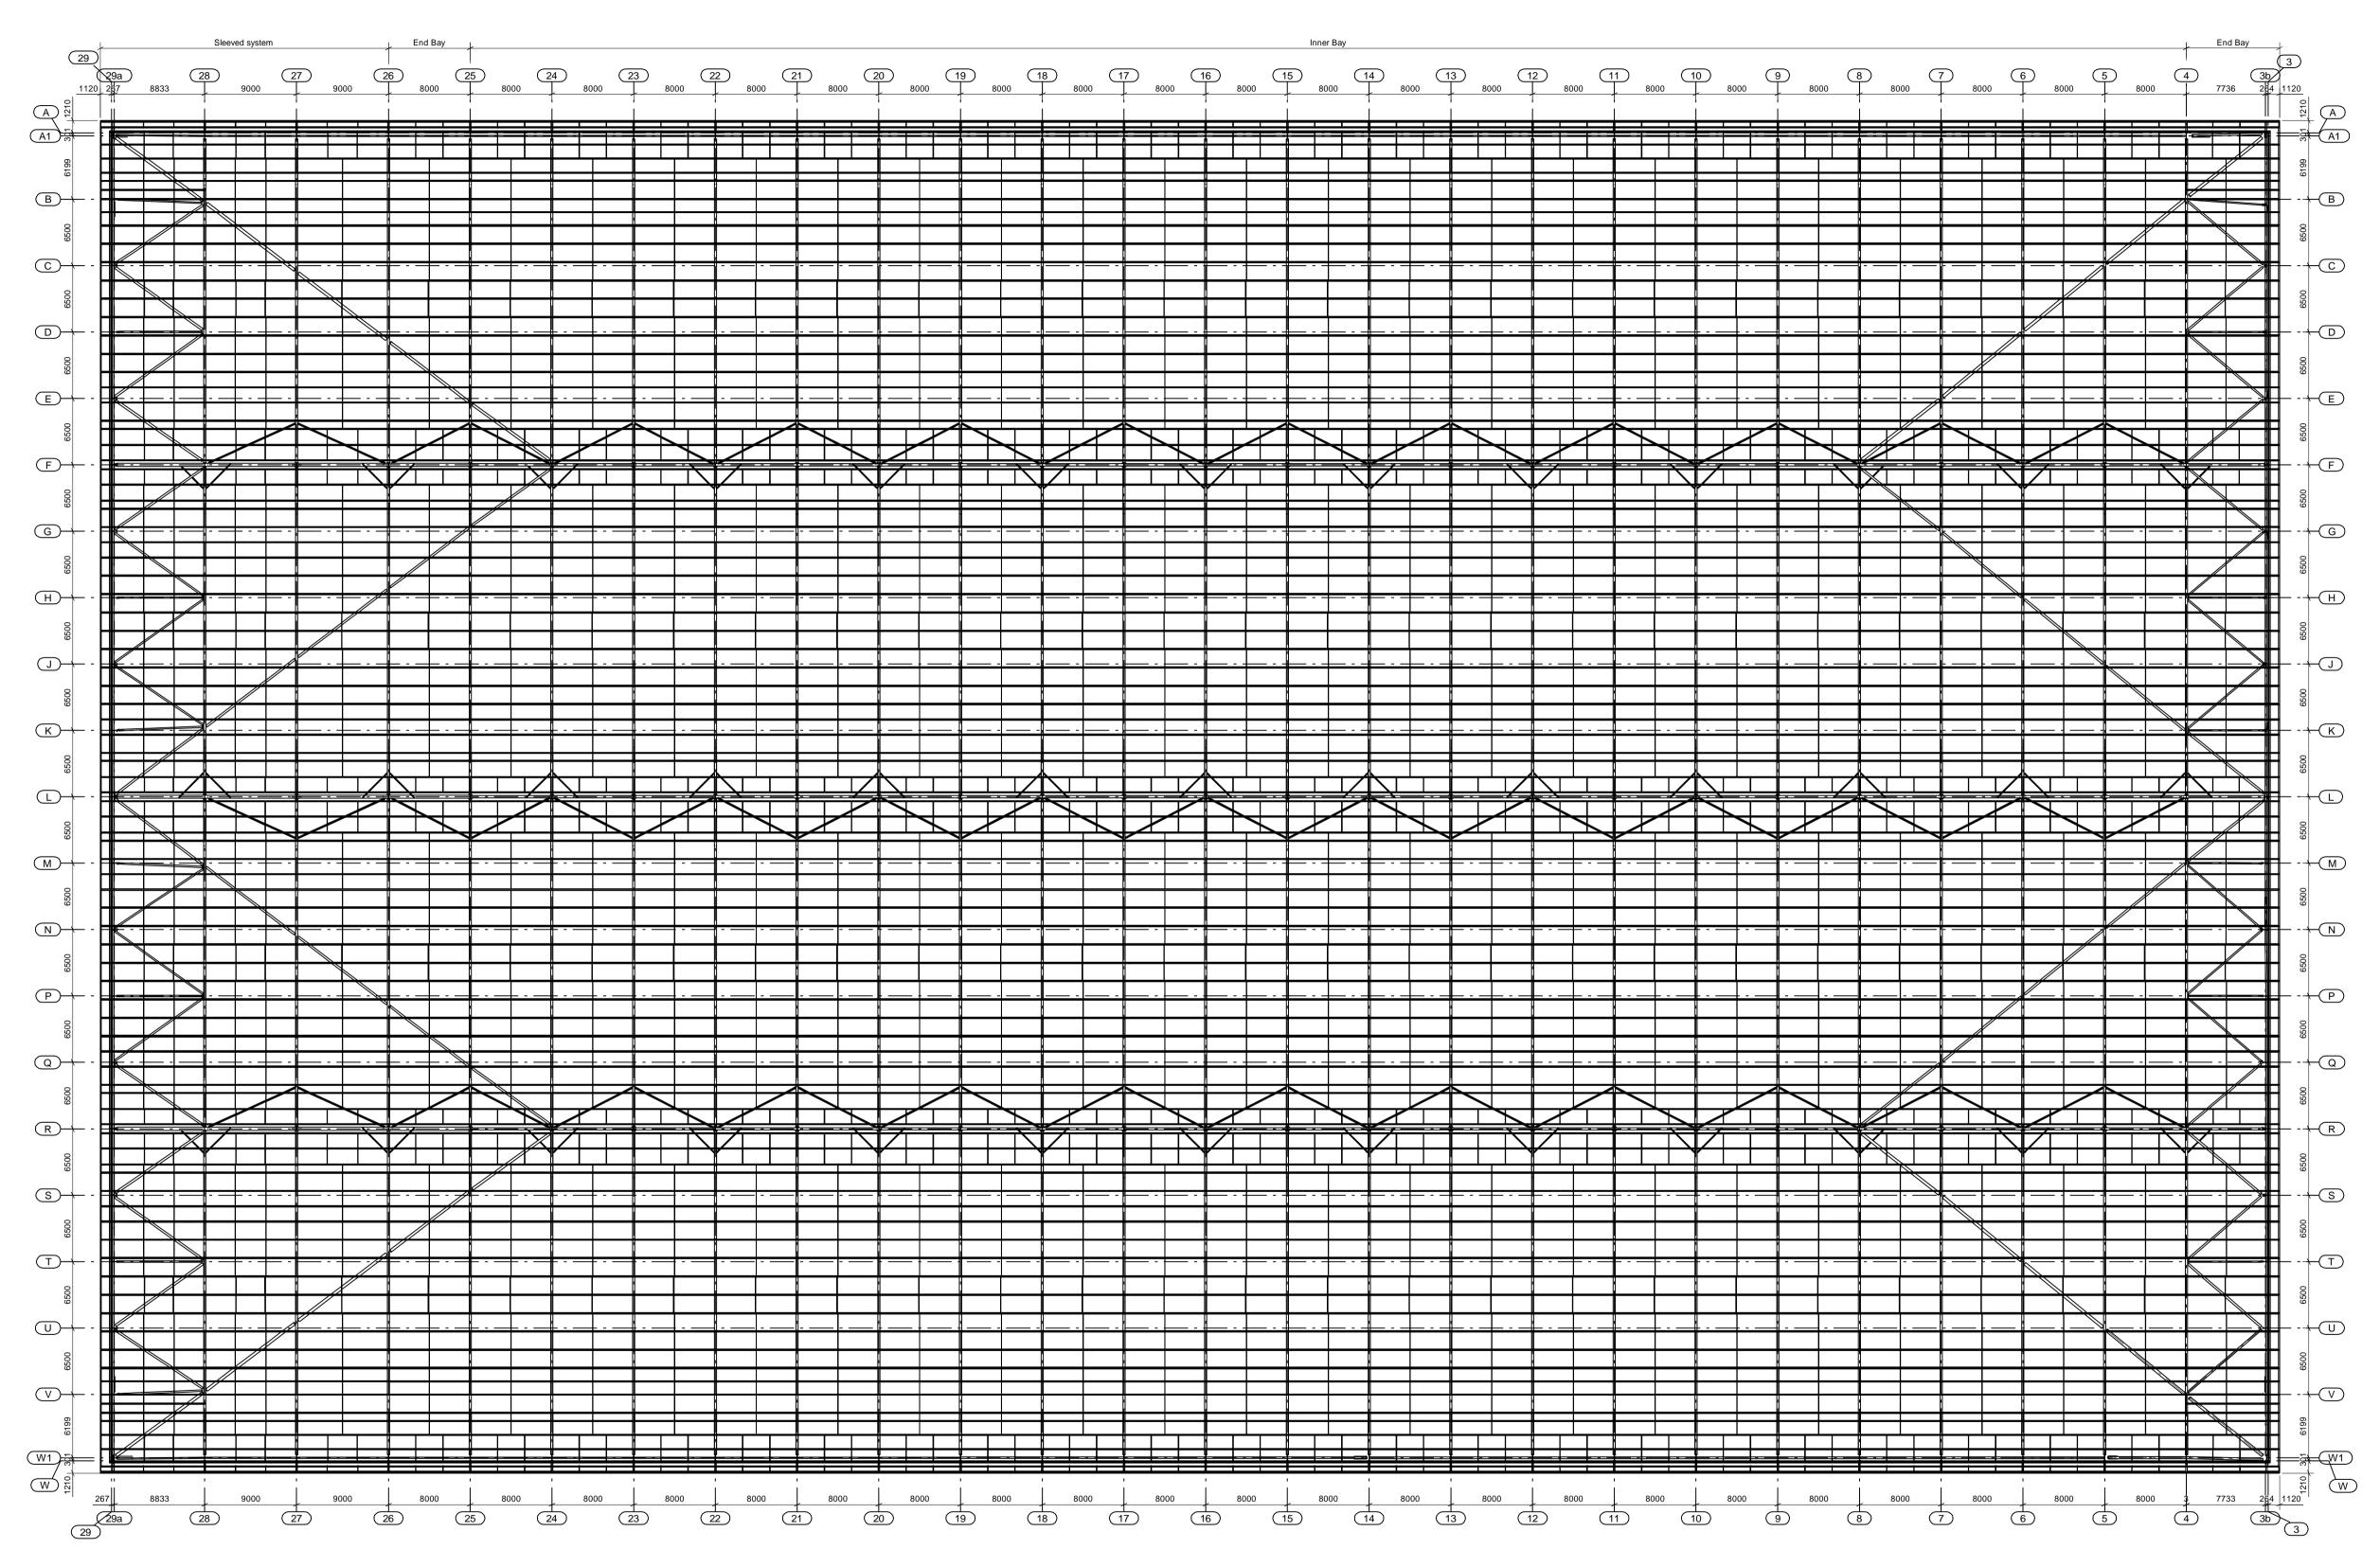


Warehouse Roof Plan

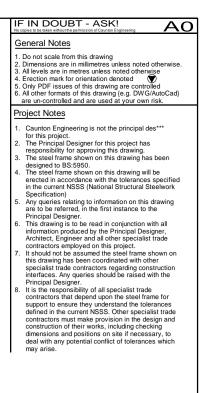


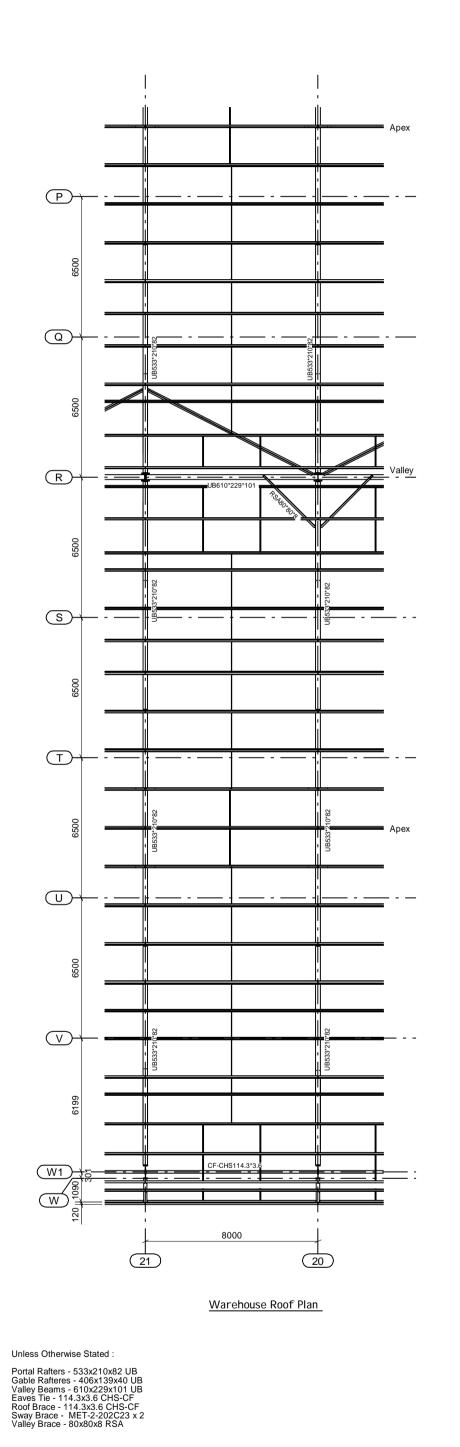


PURLIN SPEC Metsec Heavy End Bay system OUS Purlins Metsec End Bay - 232223 Inner Bay - 232215 PT = Purlin tie DPB = Diagonal pulin brace EB = Eaves brace SRS = Side rail support AS = Apex Strut UPEB = Under purlin eaves brace Cleader angle 100x100 supplied by Caunton fitted by others

AB01	As-Built Issue		30.06.2022		
C01	Construction Issue	13.10.2021			
P02	Purlins added		11.08.2021		
P01	Preliminary Issue		22.07.2021		
REV. MARK	REVISION DESCRIPT	ION	REV. DATE		
Winvic Construction Ltd.					
Project Desc	Moorg TEL: 017: Tech E Construction Lto	unton Engineering Limited Moorgreen Industrial Park reen, Nottingham. NG16 3QU 73-531111 FAX: 01773-5320 www.caunton.co.uk -Mail: drawing@caunton.co.uk			
Winvic O Project Deso Calder I Site Address Wakefie Drawing Title	M Moorg TEL: 017: Tech E Construction Lto Park s s	unton Engineering Limited Moorgreen Industrial Park reen, Nottingham. NG16 3QU 73-531111 FAX: 01773-5320 www.caunton.co.uk -Mail: drawing@caunton.co.uk			
Winvic O Project Deso Calder I Site Address Wakefie Drawing Title	Construction Ltd where the second se	unton Engineering Limited Moorgreen Industrial Park reen, Nottingham. NG16 3QU 73-531111 FAX: 01773-5320 www.caunton.co.uk -Mail: drawing@caunton.co.uk			

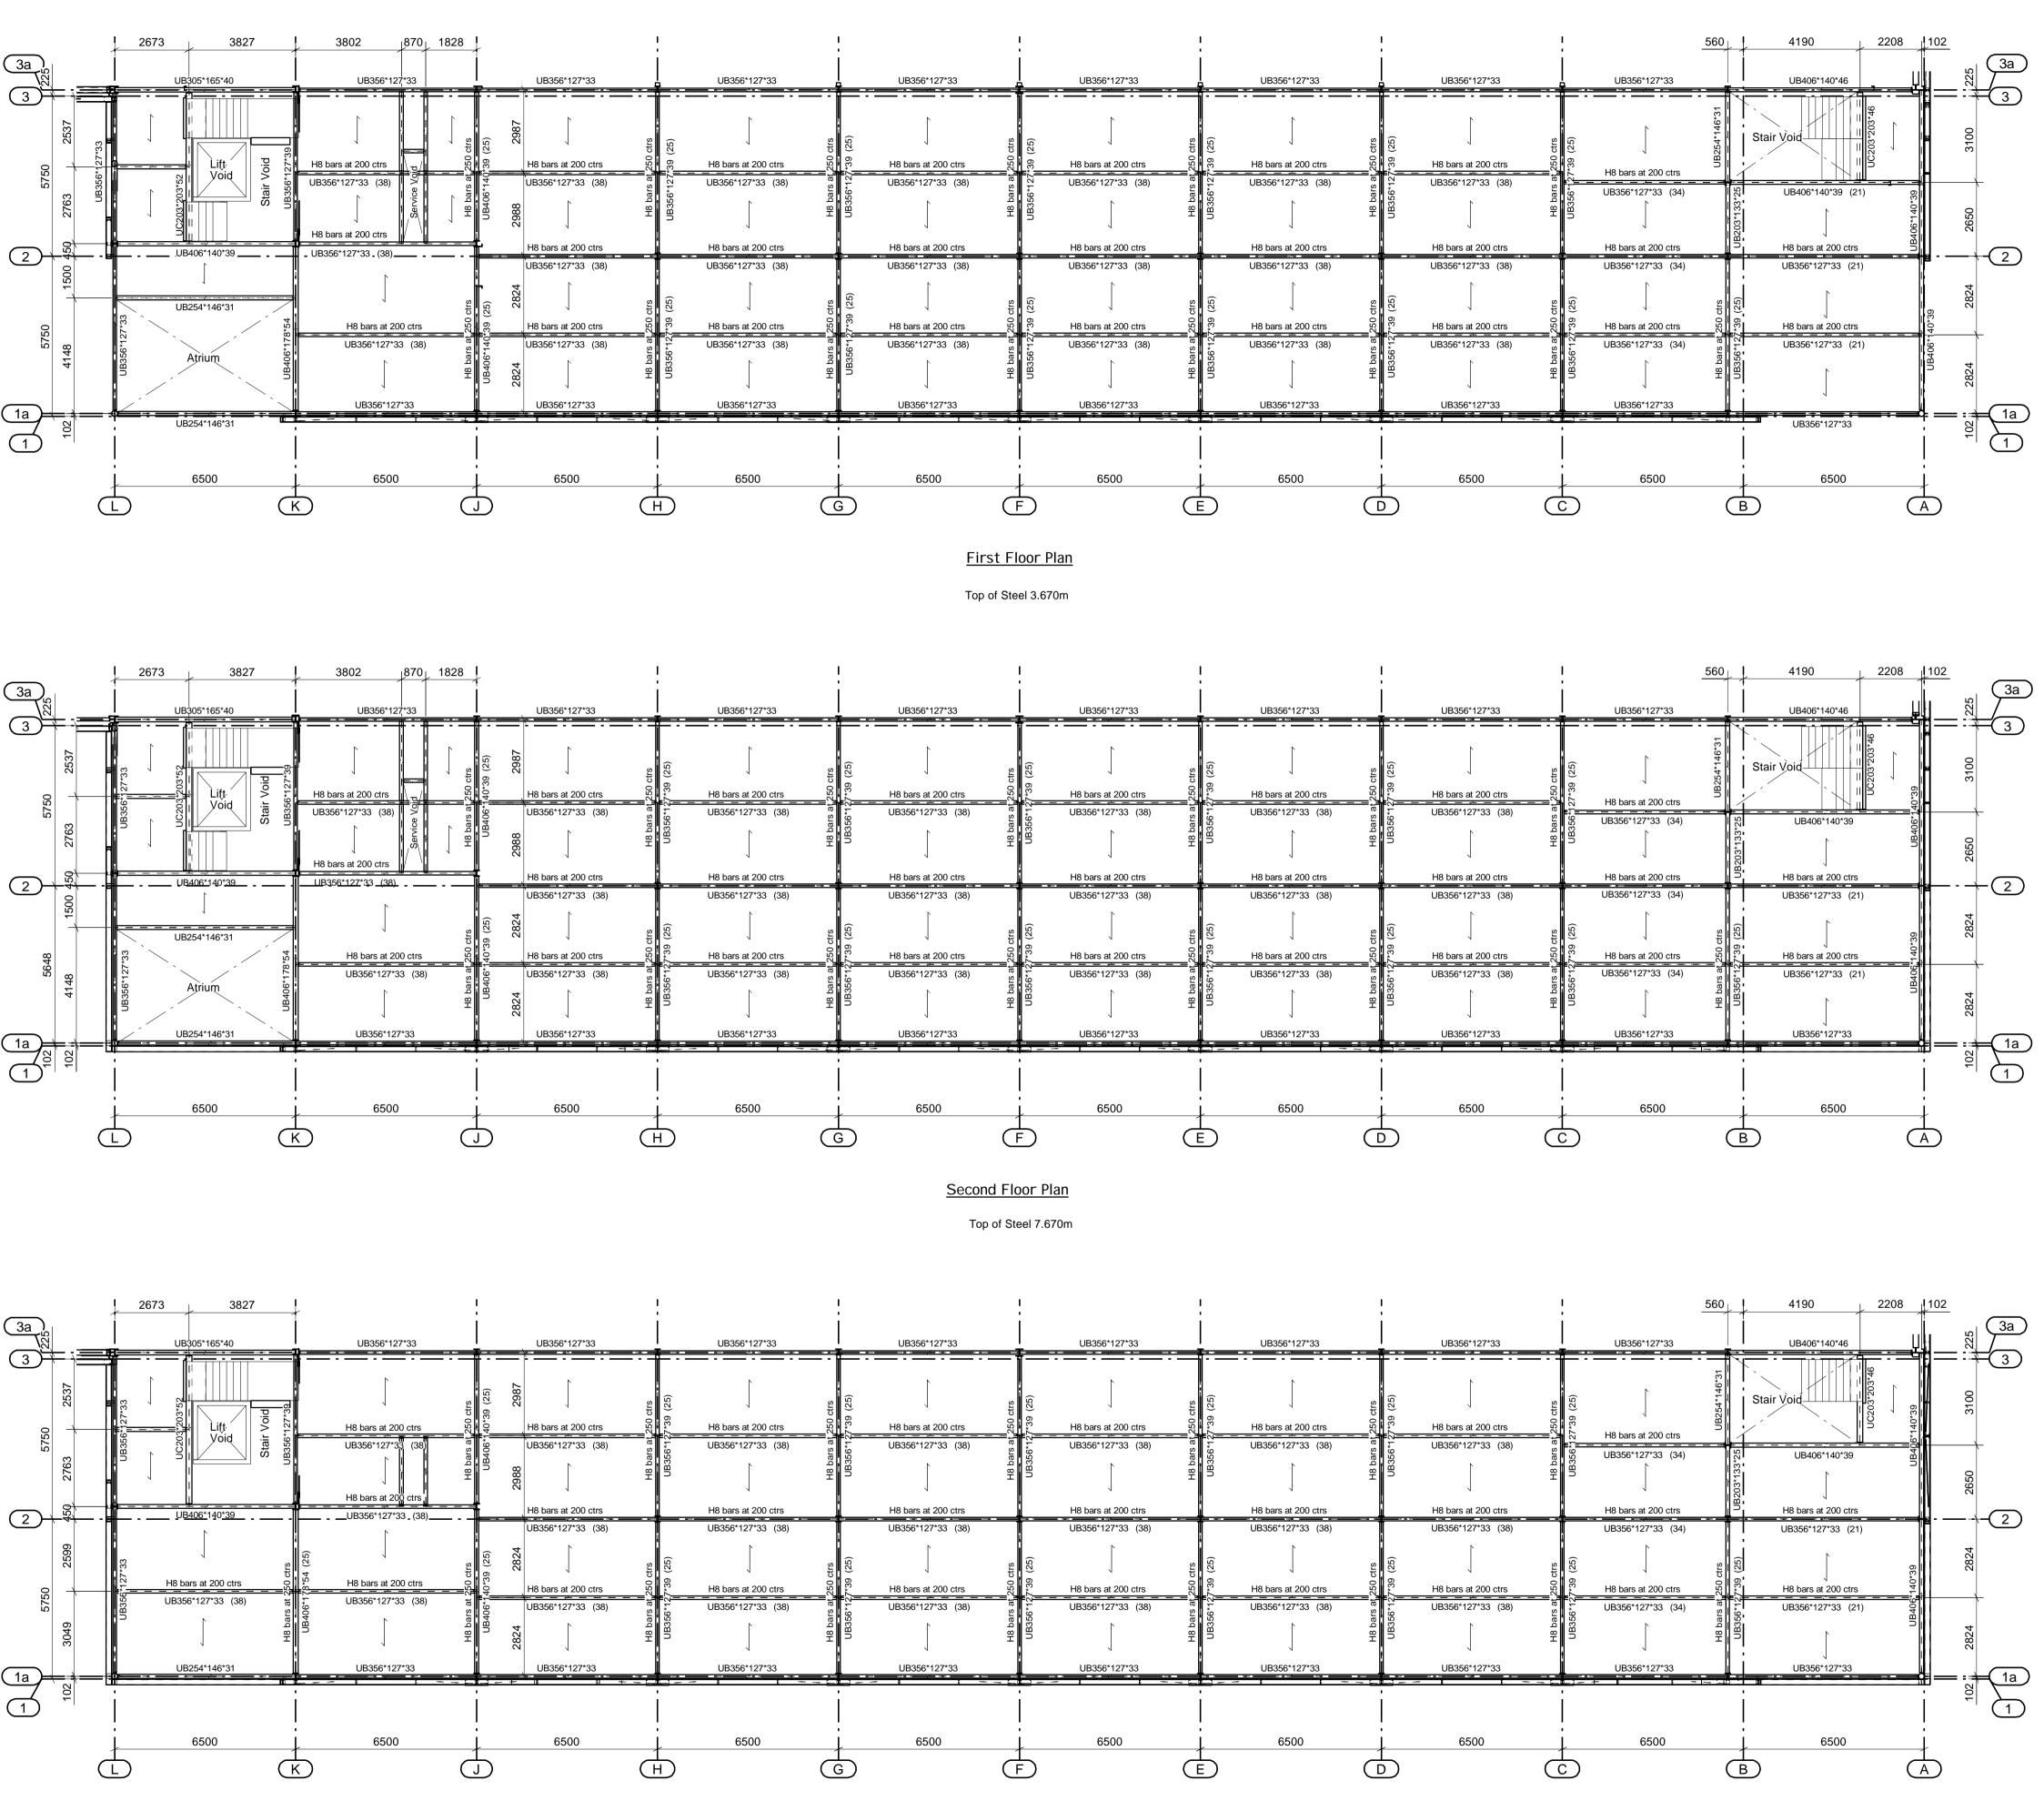

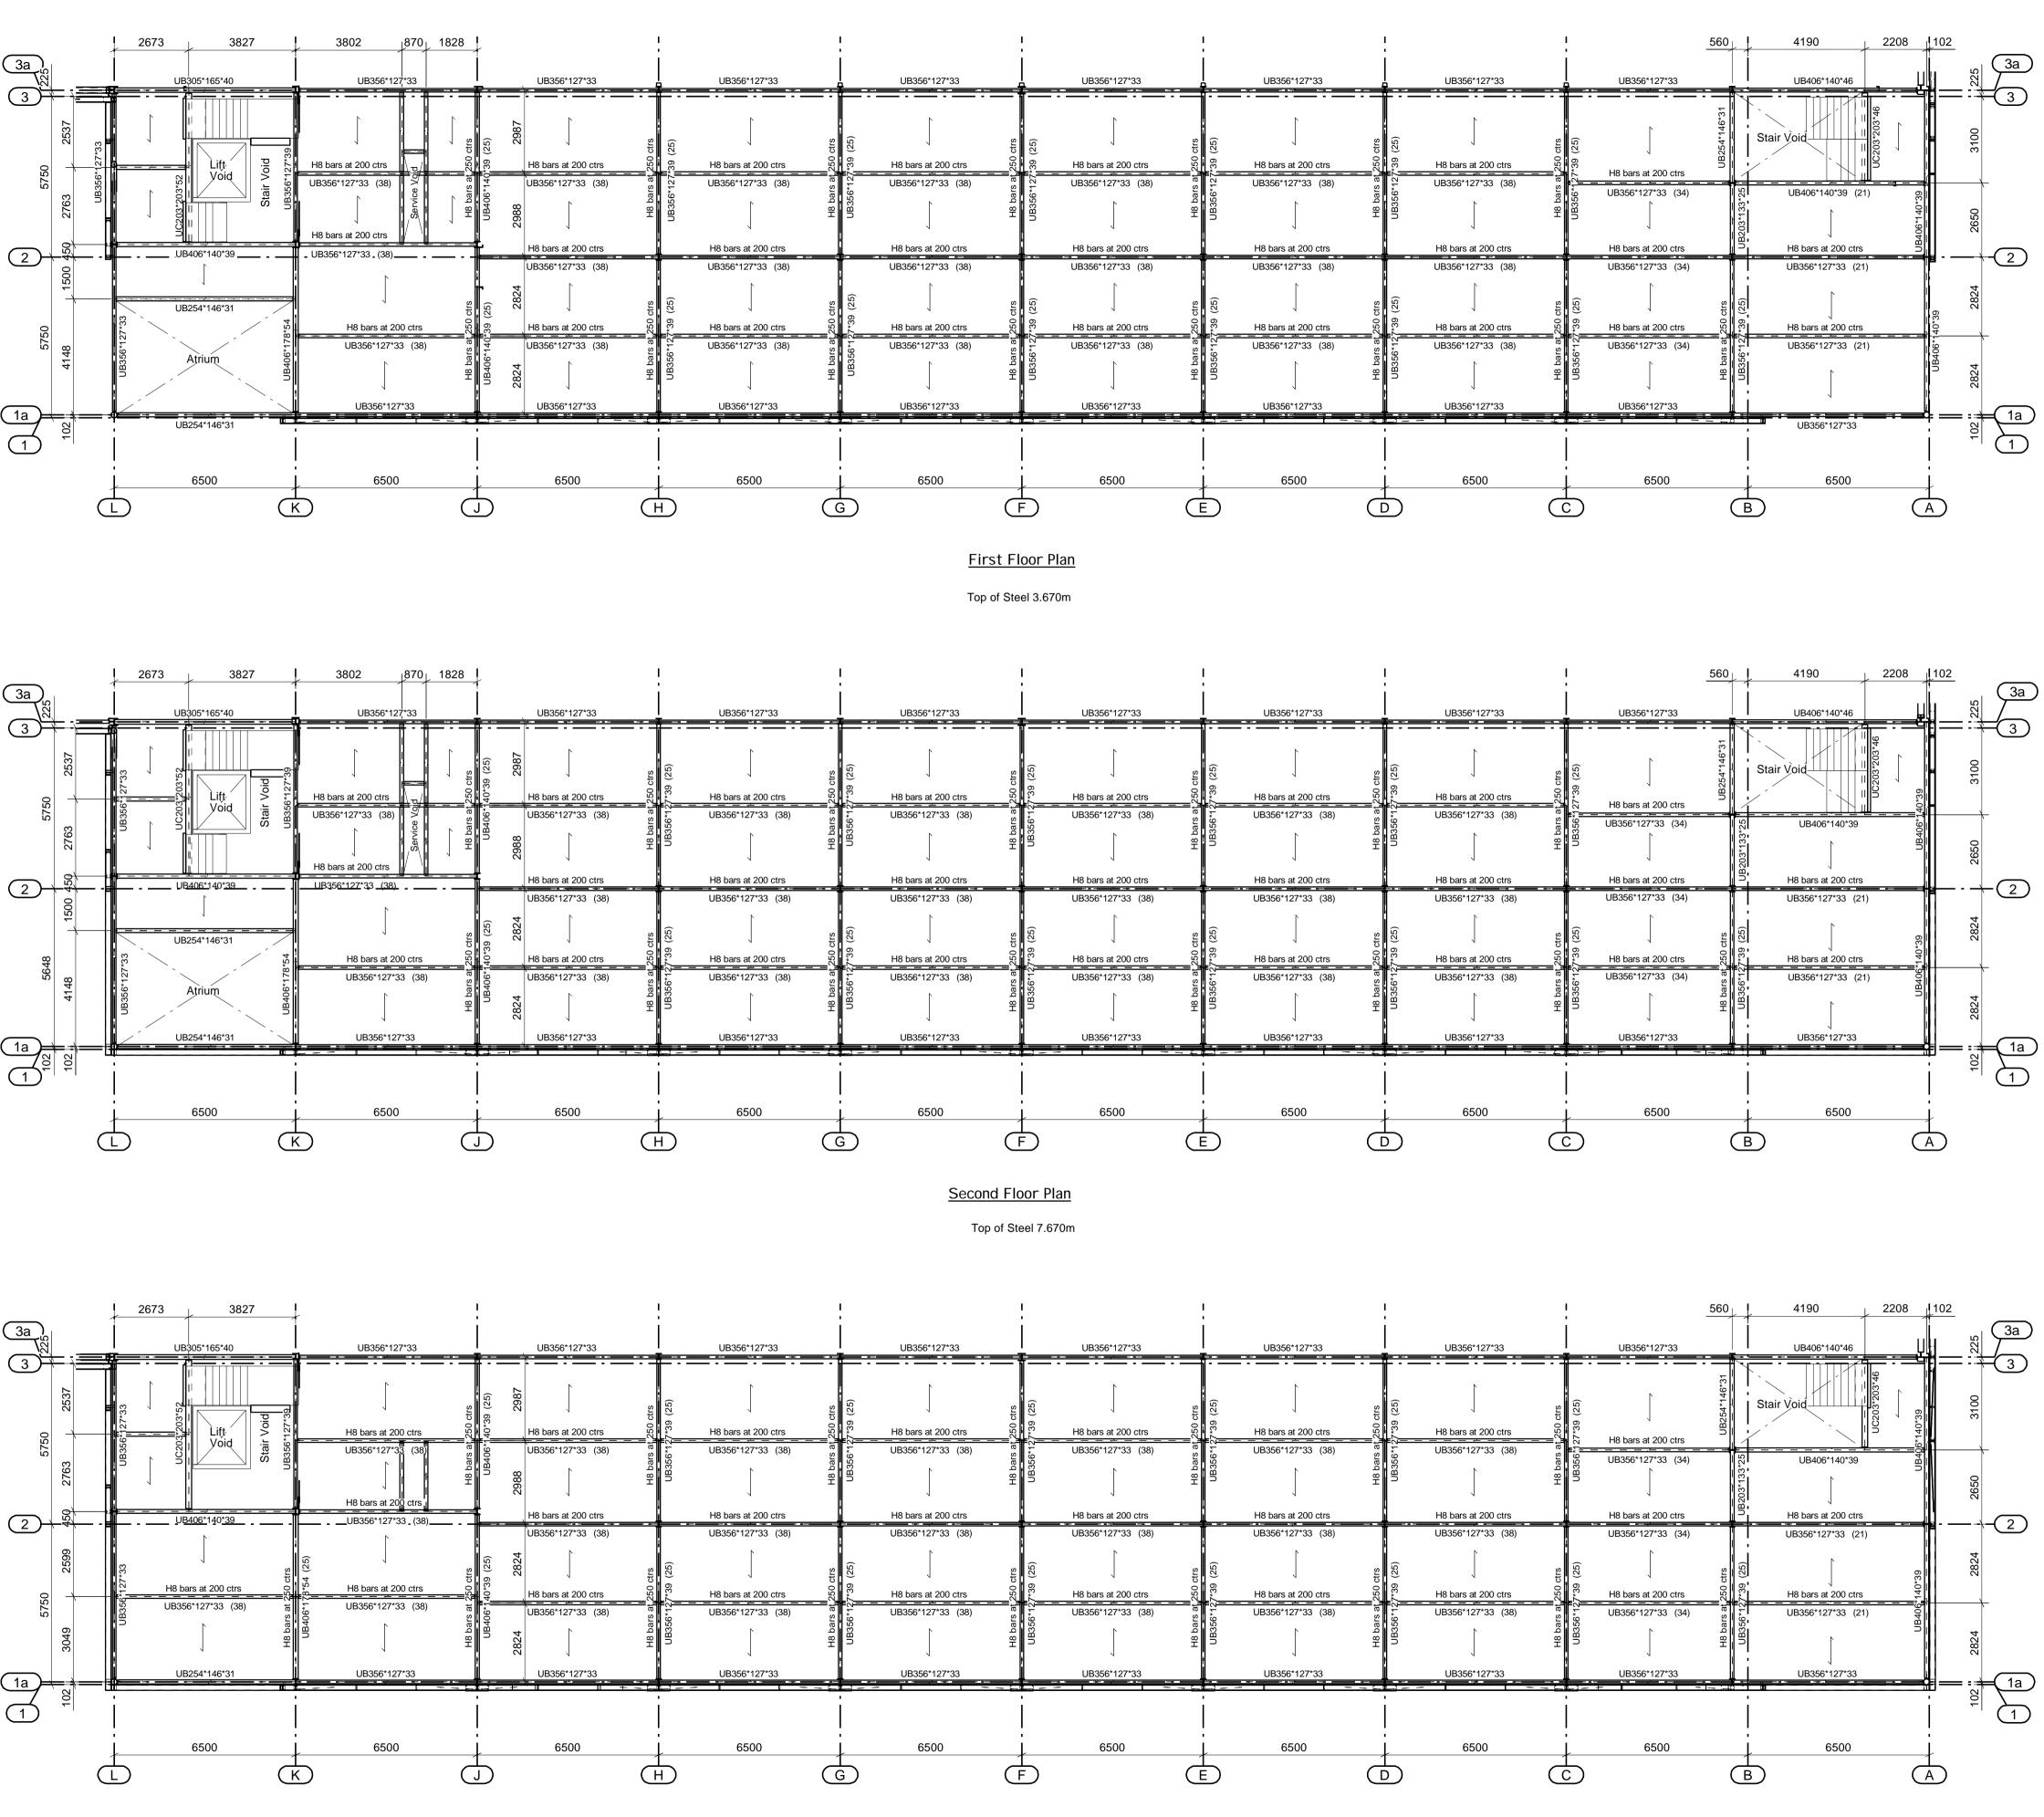

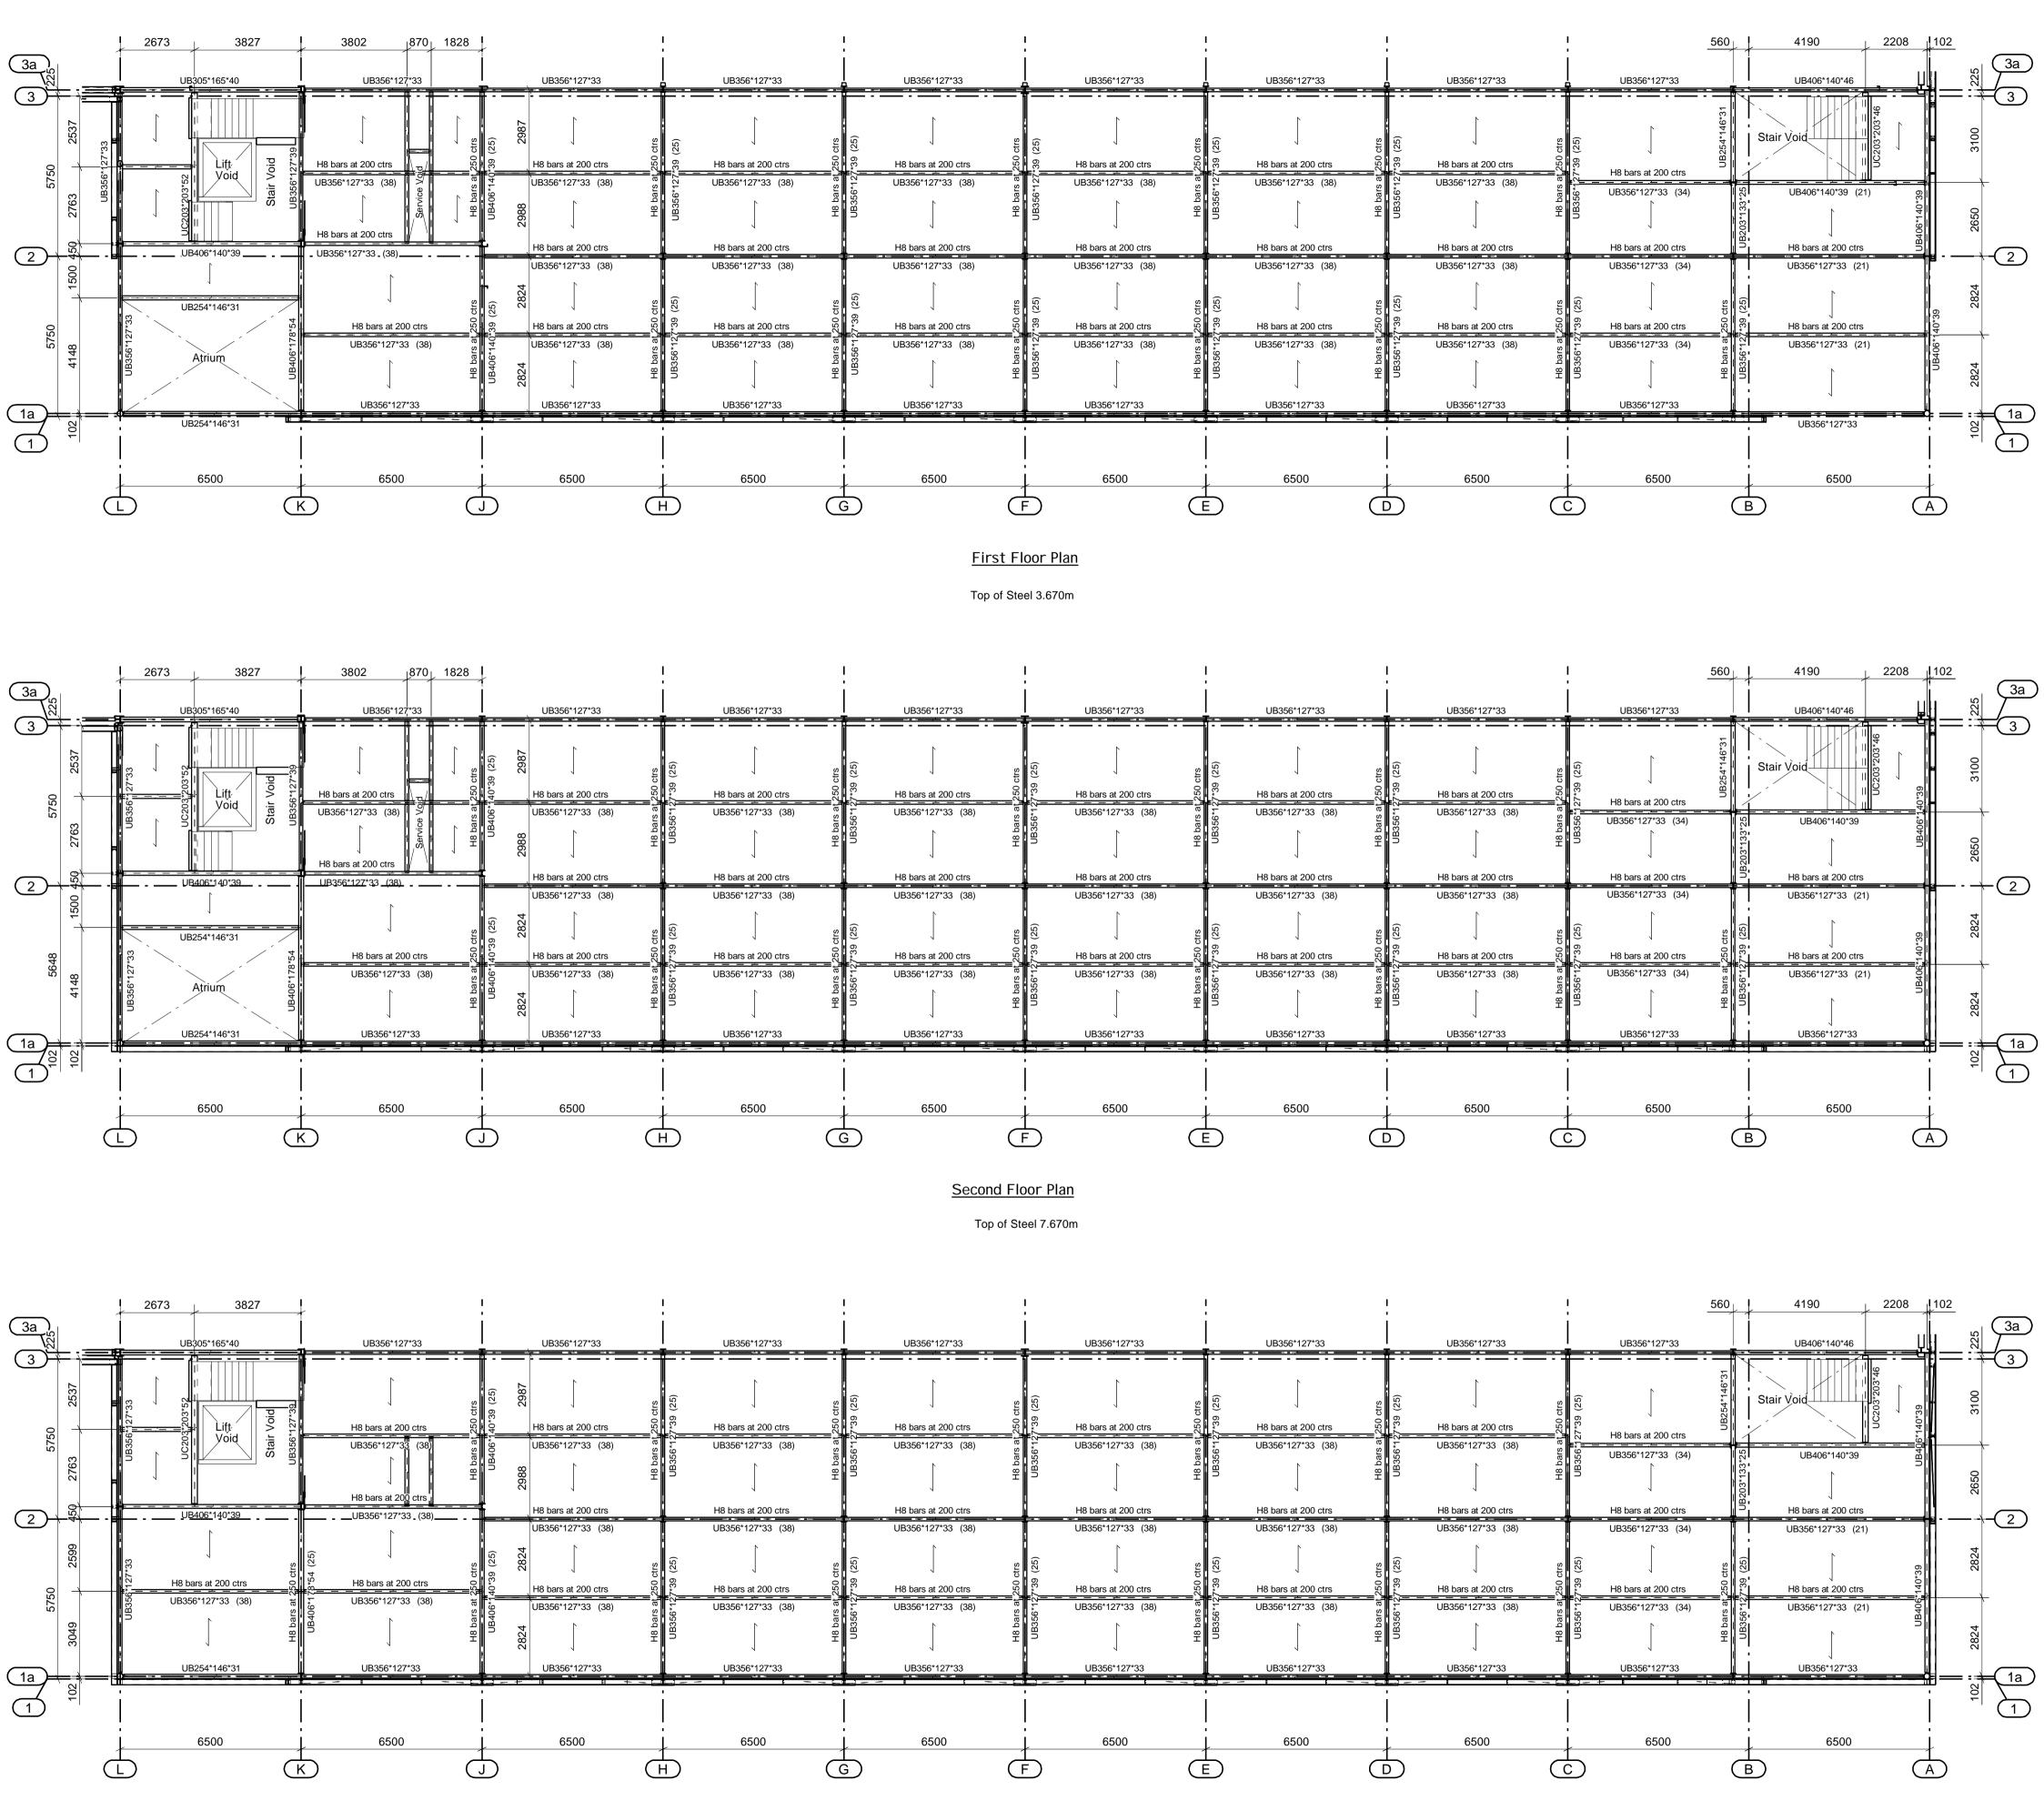

Third Floor Plan

Top of Steel 11.670m


Ge	eneral Notes
2. 3. 4. 5. 6.	Do not scale from this drawing Dimensions are in millimetres unless noted otherwise. All levels are in metres unless noted otherwise Erection mark for orientation denoted Only PDF issues of this drawing are controlled All other formats of this drawing {e.g. DWG/AutoCad} are un-controlled and are used at your own risk.
Pro	oject Notes
1.	Caunton Engineering is not the principal des***
2.	for this project. The Principal Designer for this project has
3.	responsibility for approving this drawing. The steel frame shown on this drawing has been
4.	designed to BS:5950. The steel frame shown on this drawing will be erected in accordance with the tolerances specified in the current NSSS (National Structural Steelwork Specification)
5.	Any queries relating to information on this drawing are to be referred, in the first instance to the
6.	Principal Designer. This drawing is to be read in conjunction with all information produced by the Principal Designer, Architect, Engineer and all other specialist trade contractors employed on this project.
7.	It should not be assumed the steel frame shown on this drawing has been coordinated with other specialist trade contractors regarding construction interfaces. Any queries should be raised with the
8.	Principal Designer. It is the responsibility of all specialist trade contractors that depend upon the steel frame for support to ensure they understand the tolerances defined in the current NSSS. Other specialist trade contractors must make provision in the design and construction of their works, including checking dimensions and positions on site if necessary, to
	deal with any potential conflict of tolerances which may arise.
	cking Notes
1. 2.	Metal decking to be MD60x0.9. Grade S350 UNO Decking to be double/single span U.N.O.
3. 4.	Concrete grade to be C30. 150mm thick. Shear studes are 19mm diameter in accordance
5.	with EN ISO 13198 Fire resistance period 60 minutes to suit project.
6.	Min mesh A252 cover 40mm from top of slab. Please note the use of flying ends may be
7.	required to achieve the minimum concrete cover. Caunton Engineering are responsible for the
	design of the metal decking in the temporary and permanent conditions. We will also advise
	the minimum concrete strength, depth and reinforcement required for our composite beam
	design and to achieve the minimum fire resistance period. The responsibility for the
	design of the slab including reinforcement requirements under concentrated loads, at
	openings or edges, and for anti-crack requirements is to be with others. All slab and
	reinforcement drawings and schedules, including
8.	sitework and day joints, are to be by others. The supply, delivery and installation of reinforcement
9.	and casting of the slab is to be by others. The design responsibility of the floor as a
	diaphragm is to be with others.
10.	for flood pouring of concrete. Concrete is to be poured to a constant depth above beam top flanges to a tolerance of -0/+10mm. We recommend that
	the slab is cast in accordance with the guideline set out in the SCI publication P300 "Composite
	Slabs and beams using steel decking: Best
	practice for design and construction".
	practice for design and construction". Depending on the quality of the slab pour we anticipate a flatness tolerance of SR3 in accordance with BS:8204. (Max 10mm gap below a 2m straight edge).
12.	Depending on the quality of the slab pour we anticipate a flatness tolerance of SR3 in accordance with BS:8204. (Max 10mm gap below a 2m straight edge). Number in brackets = min number of studs
12. 13.	Depending on the quality of the slab pour we anticipate a flatness tolerance of SR3 in accordance with BS:8204. (Max 10mm gap below a 2m straight edge).


IF IN DOUBT - ASK!


A1

agreed with Caunton Engineering design department.
Composite edge beams to have shear studs located no closer than 6d (d = stud diameter) from the free edge of the slab.

AB01	As-Built Issue		30.06.2022							
C01	Construction Issue		13.10.2021							
P02	Top of Steel level altered 11.08.2021									
P01	Preliminary Issue	Preliminary Issue 22.07.2021								
REV. MARK	REV. DATE									
	STATUS : /	APPROVAL IS	SUE							
	Caunto Moor Moorgreer TEL: 01773-5 W	n Engineering Limited green Industrial Park Nottingham. NG16 30U 31111 FAX: 01773-53202 ww.caunton.co.uk it drawing@caunton.co.uk	IEERING							
<sup>Client</sup> Winvic C	Construction Ltd.									
Project Desc Calder F										
Site Address										
Drawing Title Office F	。 Ioor Plans									
Scale 1:125			CEL Job No. 21009							
Drawn by MatrixC		Project Type Design & Build	Date Created 22.07.2021							
Designed Re	eviewed by		Date Reviewed							
Project P210	Company Volume Leve	Type Role Drawing No.	9 AB01							

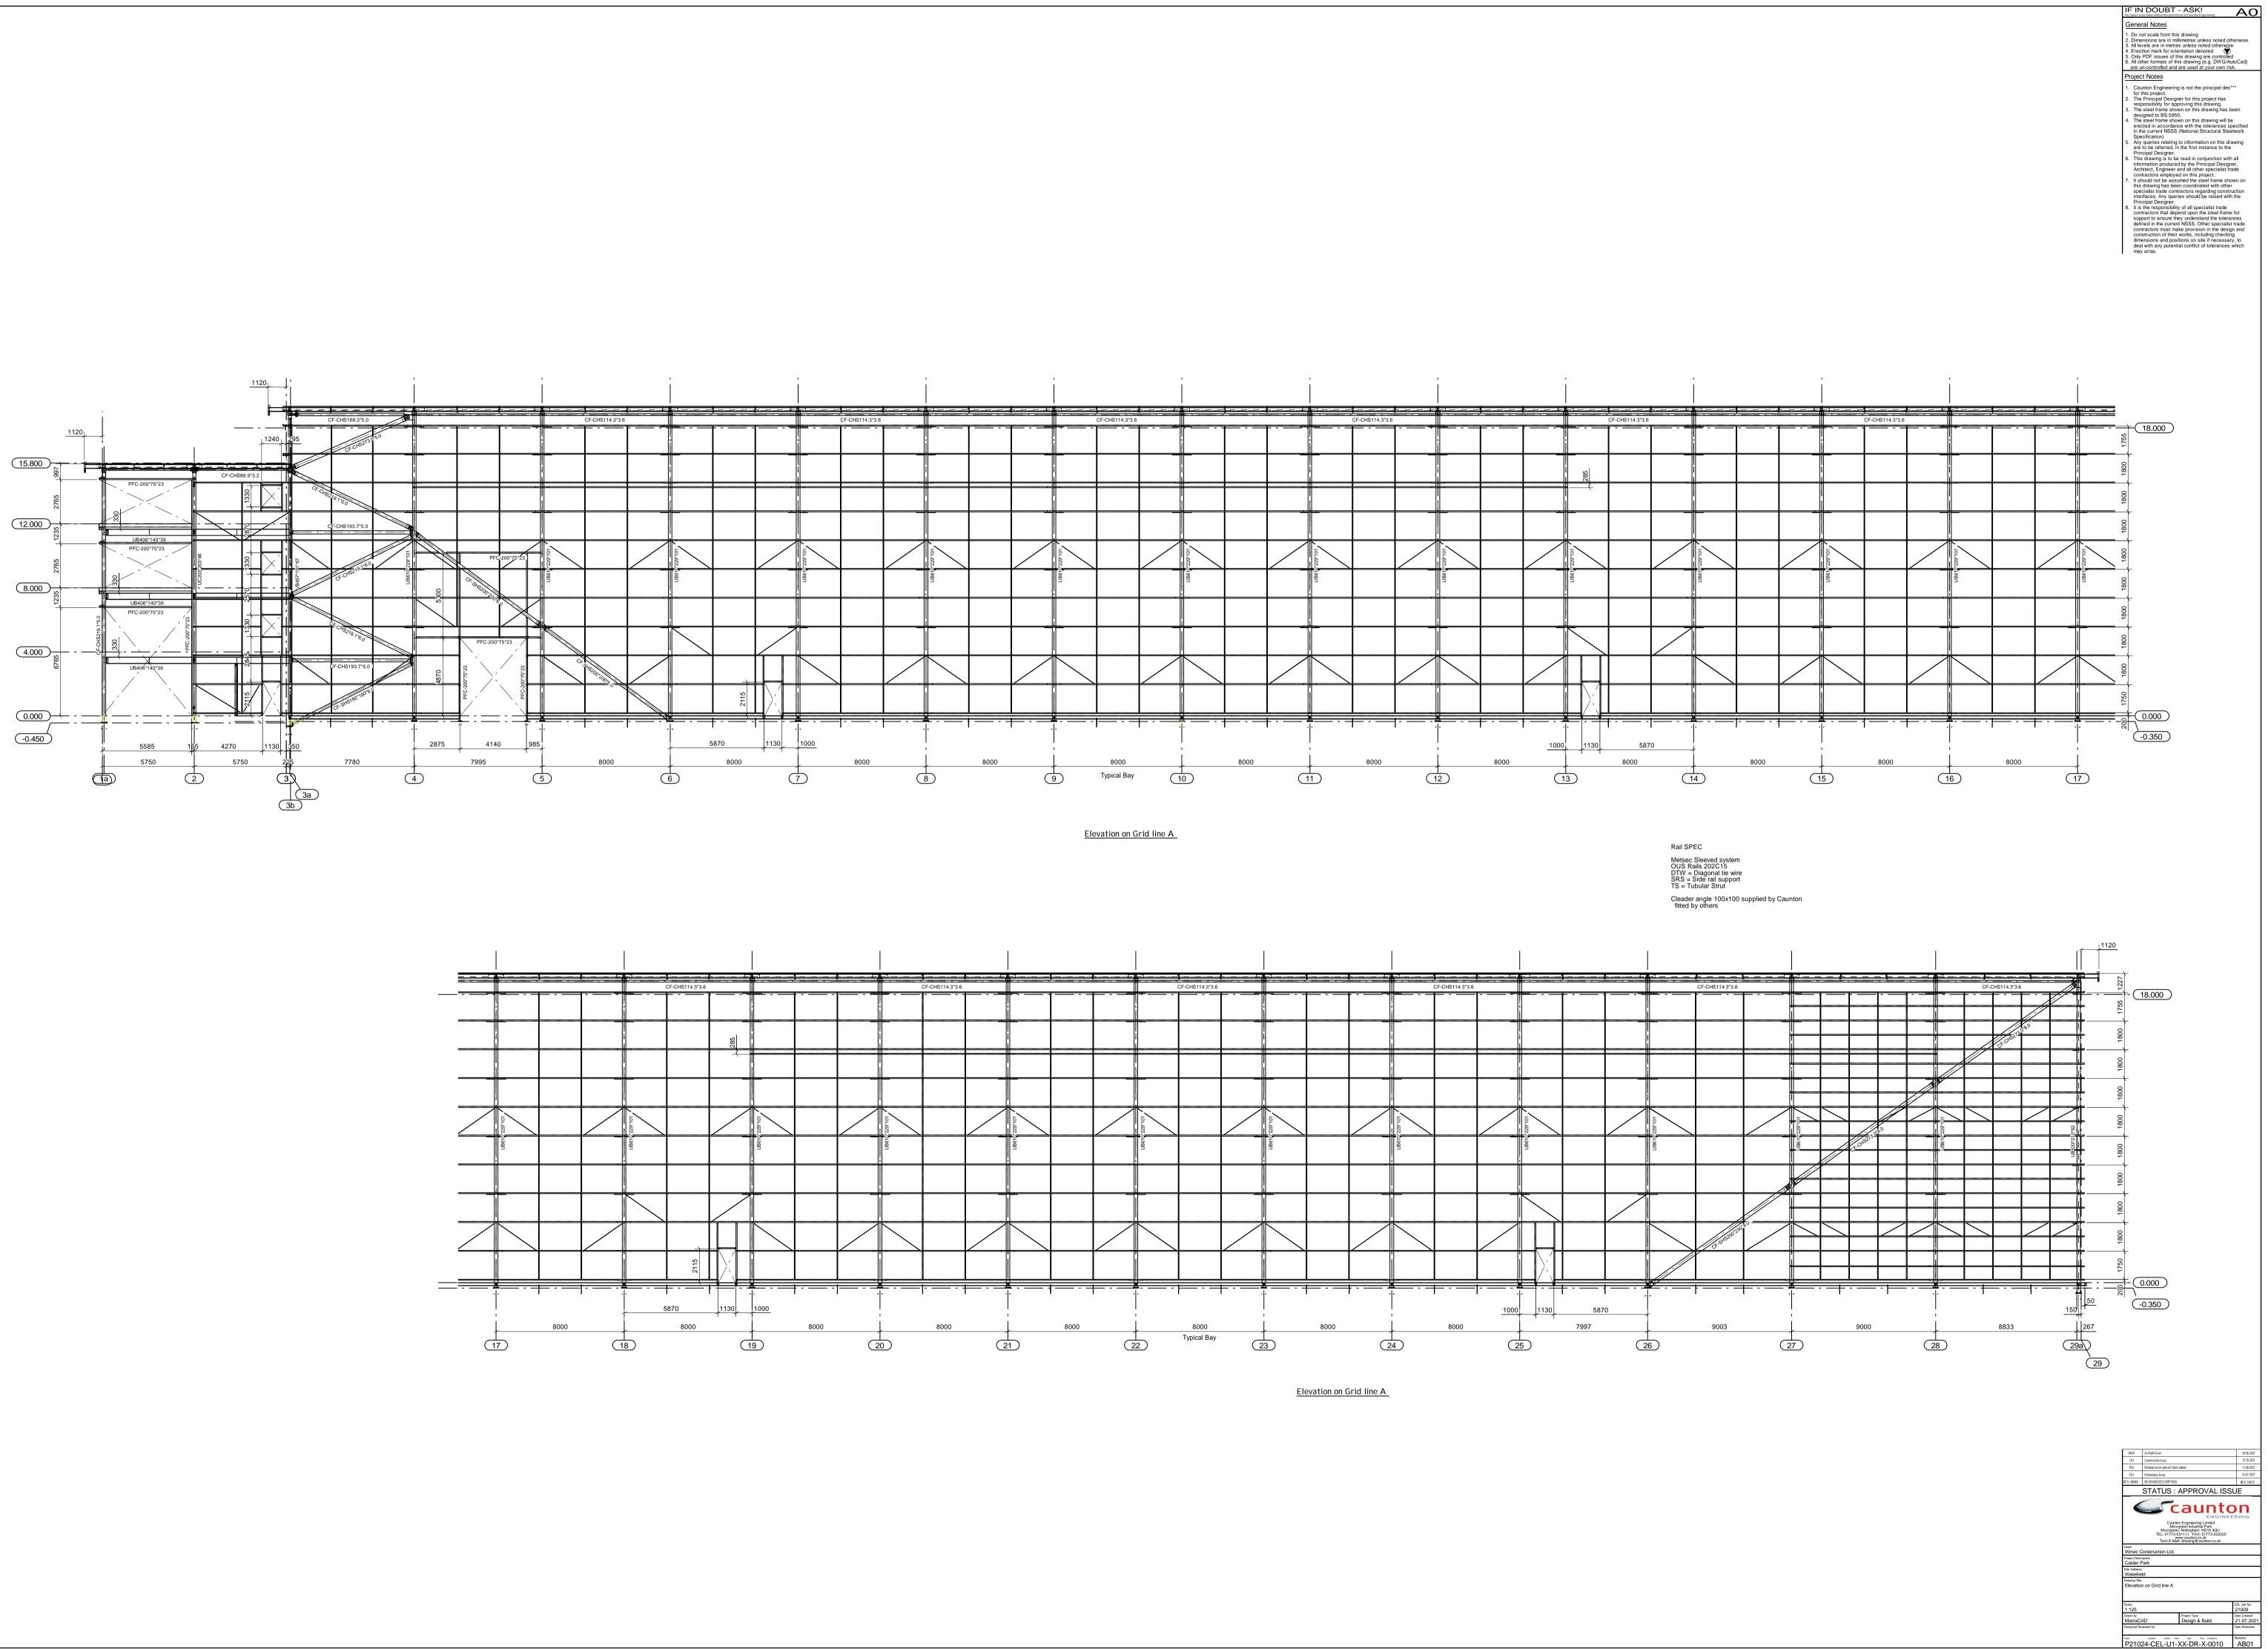


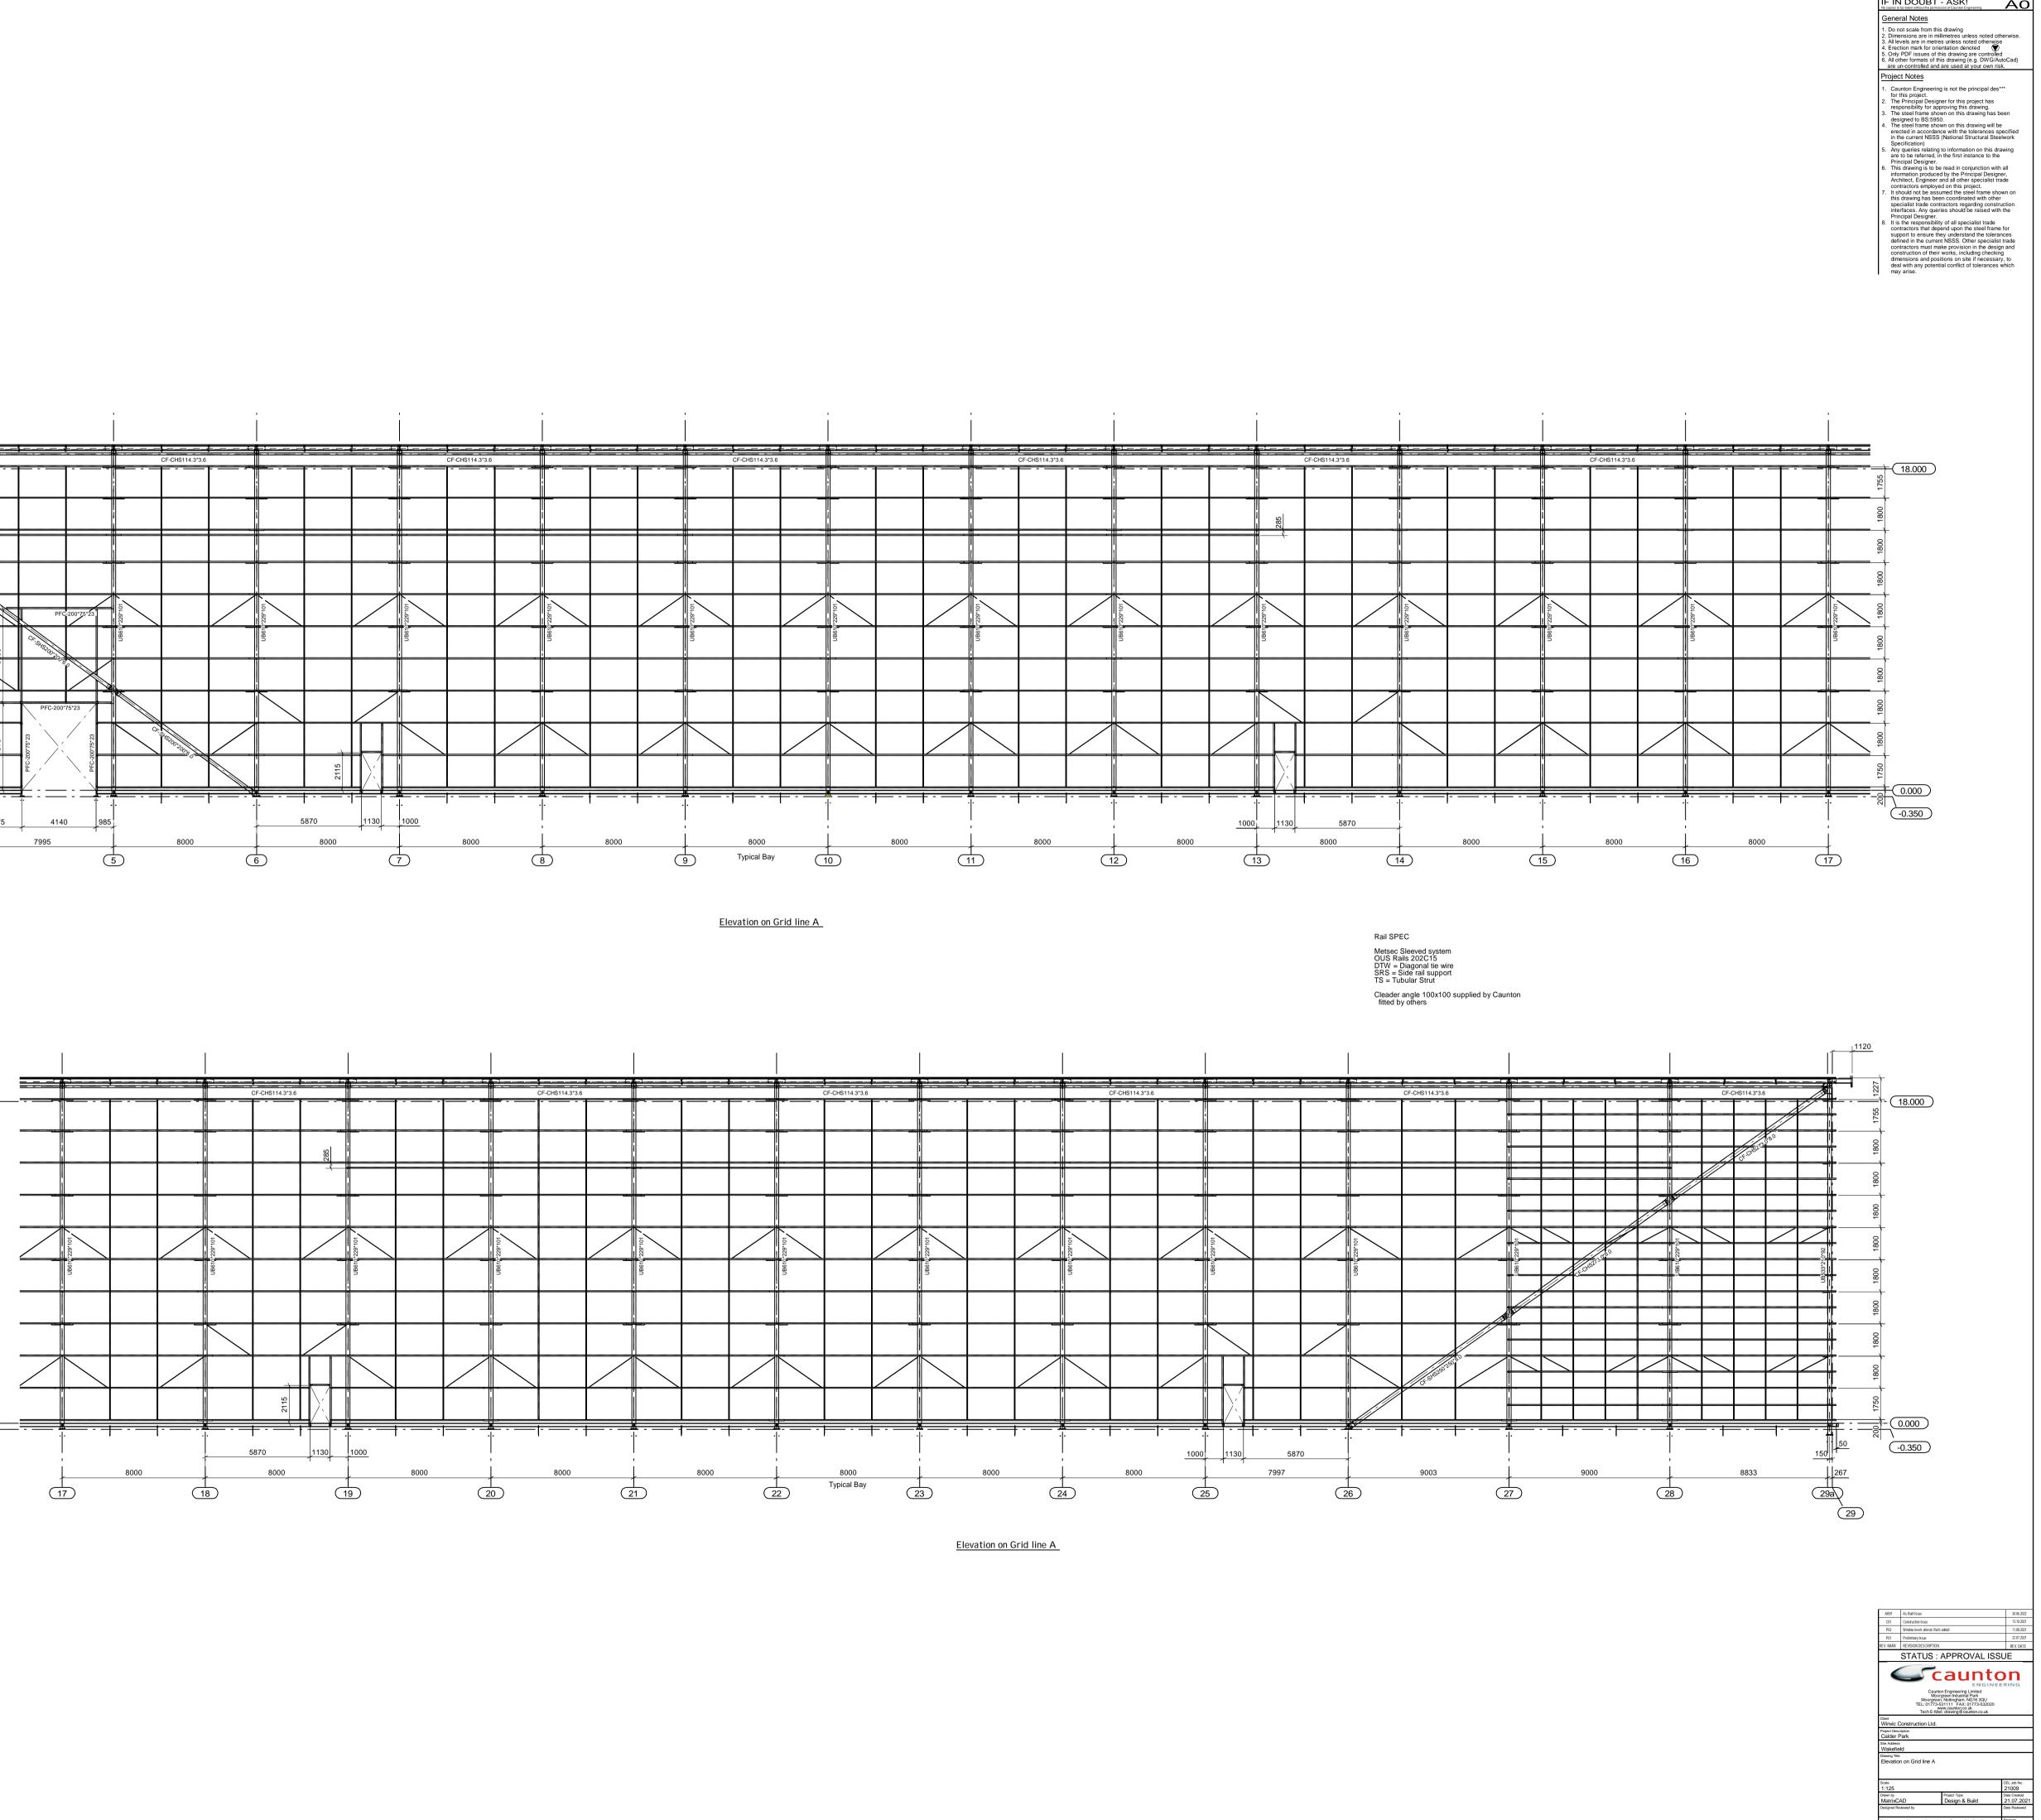


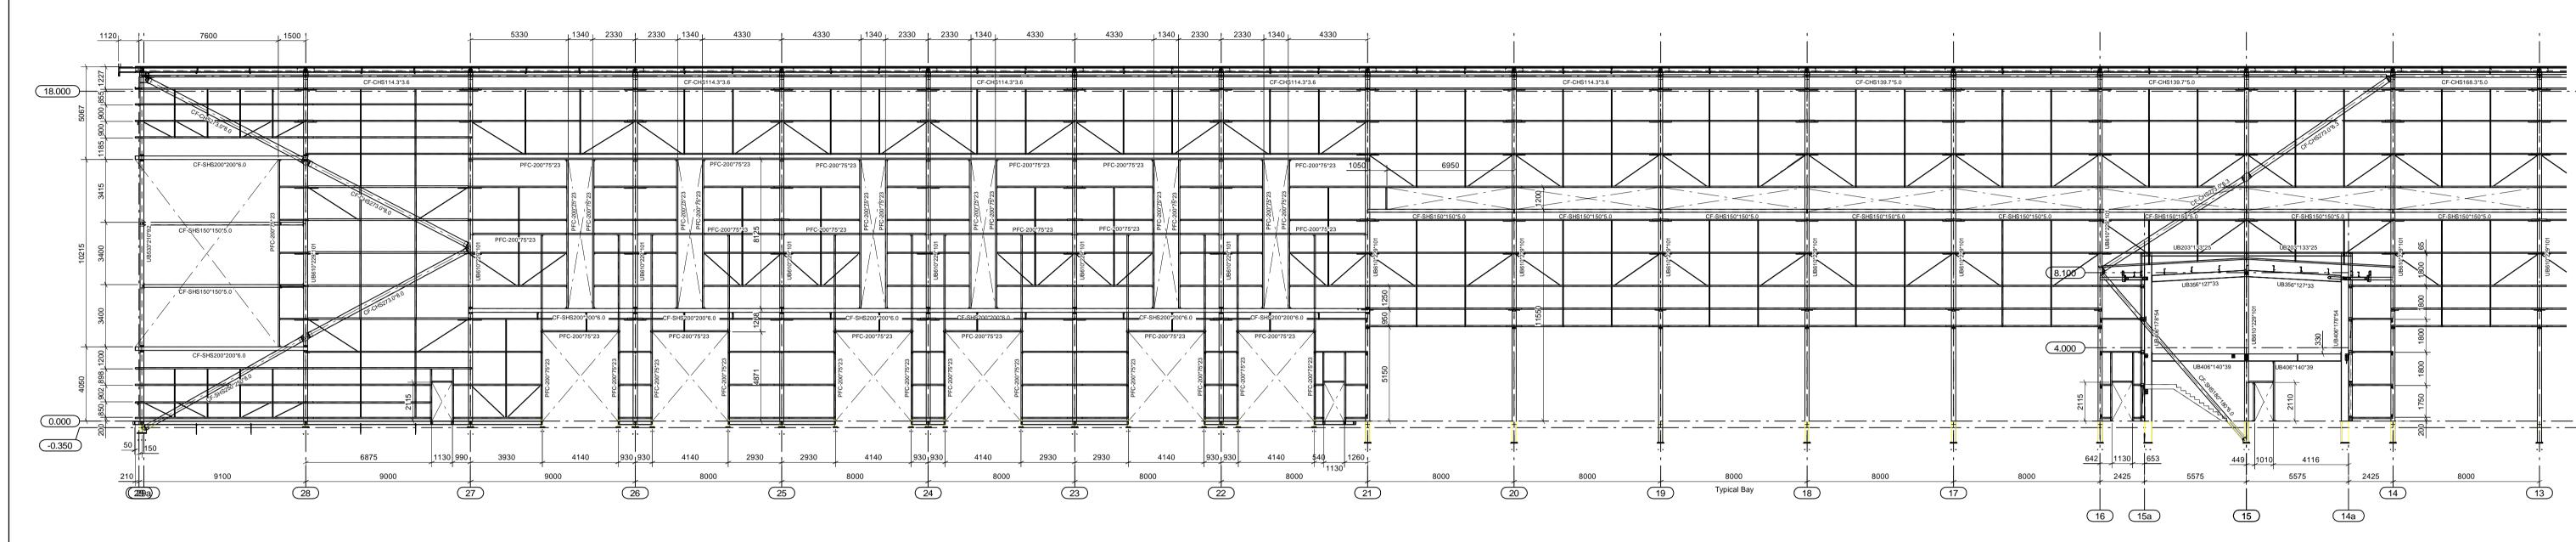

Rail SPEC Metsec Sleeved system OUS Rails 202C15 DTW = Diagonal tie wire SRS = Side rail support TS = Tubular Strut Cleader angle 100x100 supplied by Caunton fitted by others



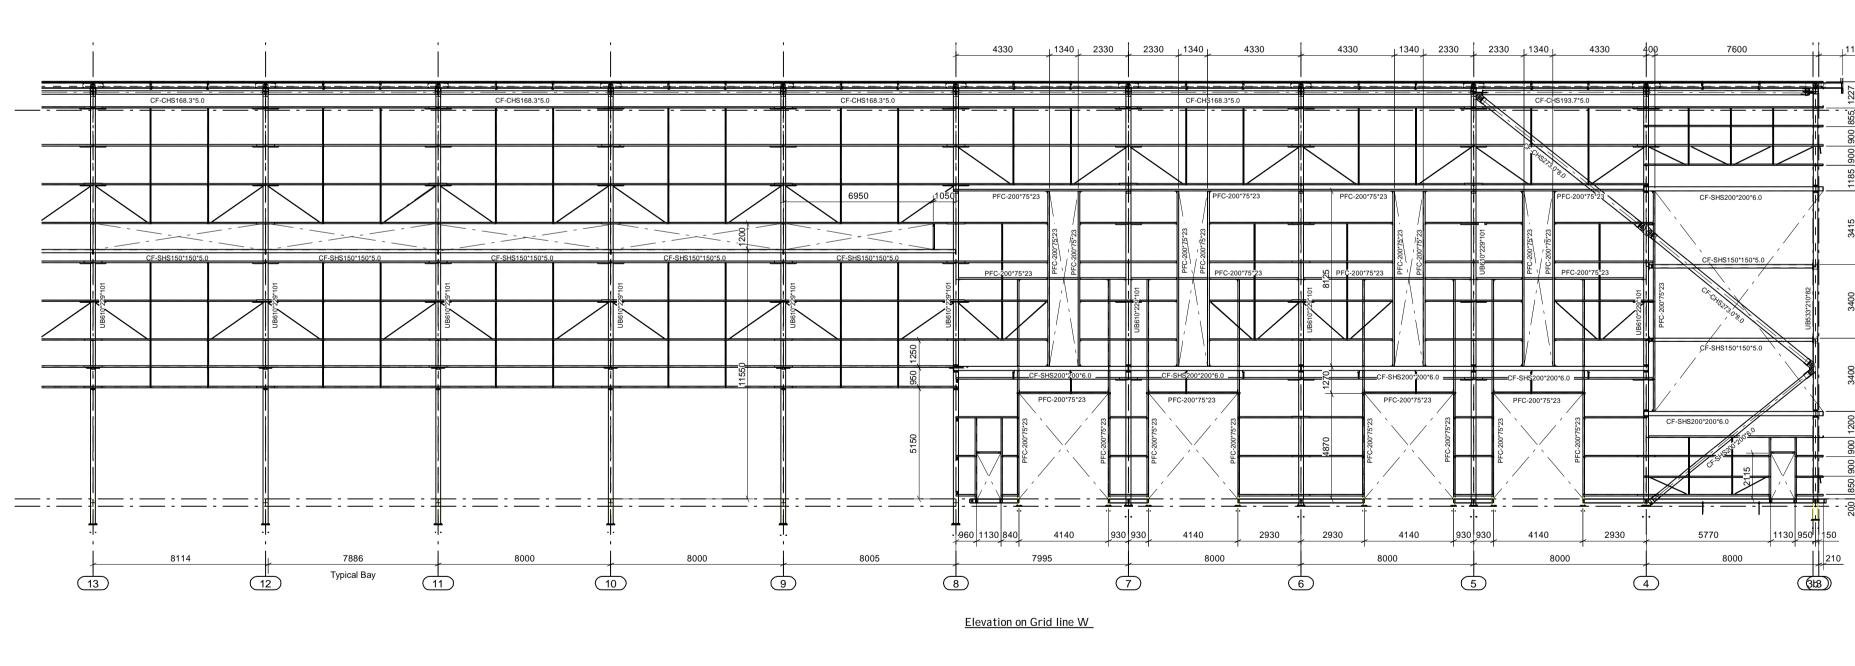

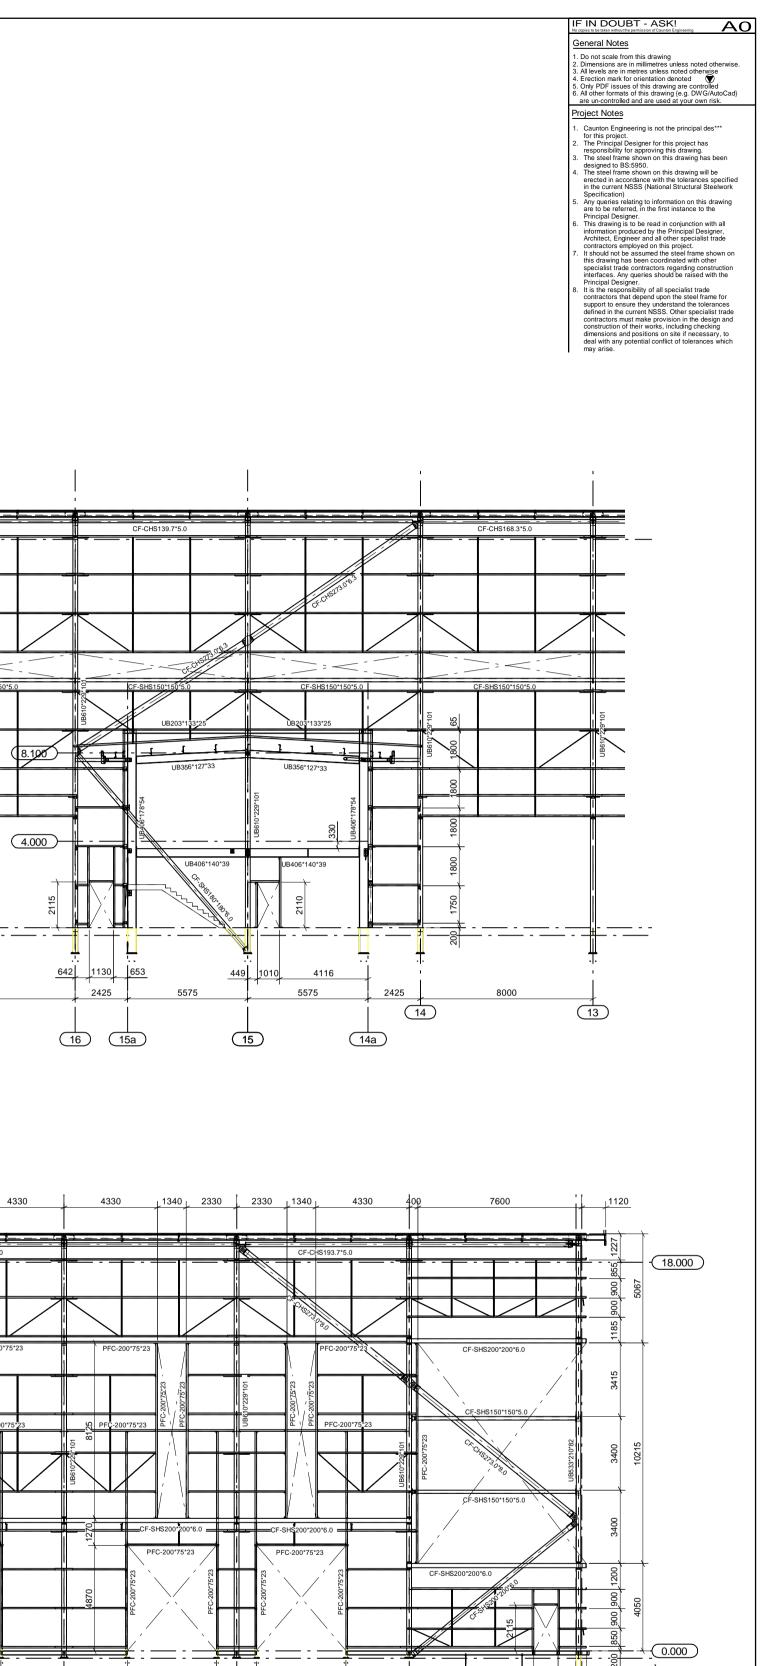

4140 930 930

5

2930

6

8000

	As-Built Issue		30.06.2022			
C01	Construction Issue		13.10.2021			
P02	Window levels altered		11.08.2021			
P01	Preliminary Issue		22.07.2021			
REV. MARK	REVISION DESCRIPTION		REV. DATE			
Carrier Engineering Limited Moorgeen Charlenge Concerneering Carrier Moorgeen Charlenge Concerneering Moorgeen Charlenge Concerneering Carrier Witch Construction Lot Calder Pank Sie Addees Wakefiel Dewag Tie Elevation on Grid line W						
			CEL Job No. 21009			

-0.350

5770

8000

1130 950 150

210


(SBS)

2930

(4)


4140

8000

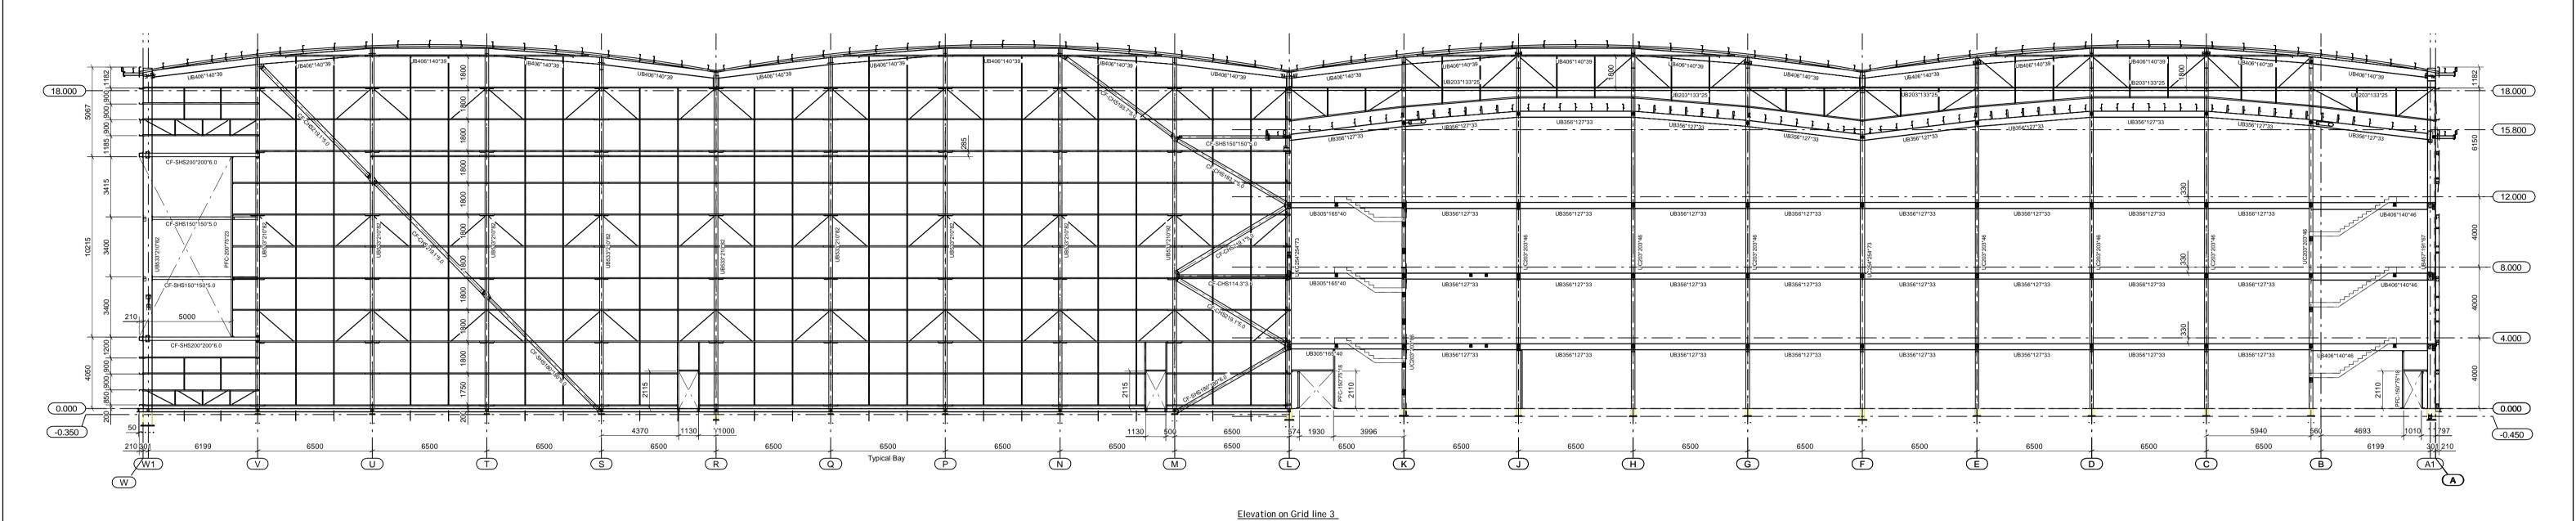


Rail SPEC Metsec Sleeved system OUS Rails 202C15 DTW = Diagonal tie wire SRS = Side rail support TS = Tubular Strut Cleader angle 100x100 supplied by Caunton

Cleader angle 100x100 supplied by Caunton fitted by others

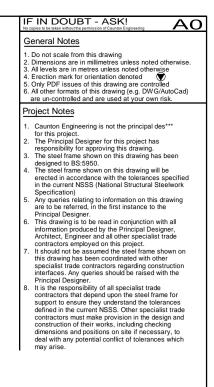

10.01	1.0.0							
AB01	As-Built Issue		30.06.2022					
C01								
P02	Window levels altered. Rails added							
P01	Preliminary Issue		22.07.2021					
REV. MARK	REVISION DESCRIPTION		REV. DATE					
<		approval						
Client	Moory Moorgreen TEL: 01773-5 W Tech E-Mai	n Engineering Limited green Industrial Park , Nottingham. NG16 3QU 31111 FAX: 01773-5320: ww.caunton.co.uk I: drawing@caunton.co.uk	20					
Project Des Calder								
Site Address Wakefie	ld							
Drawing Title Elevatio	n on Grid line 3							
Scale 1:125			CEL Job No. 21009					
Drawn by MatrixC		Project Type Design & Build	Date Created 21.07.202					
Designed R	weeked by		Date Reviewed					
	Commony Vitere Last		Revision					

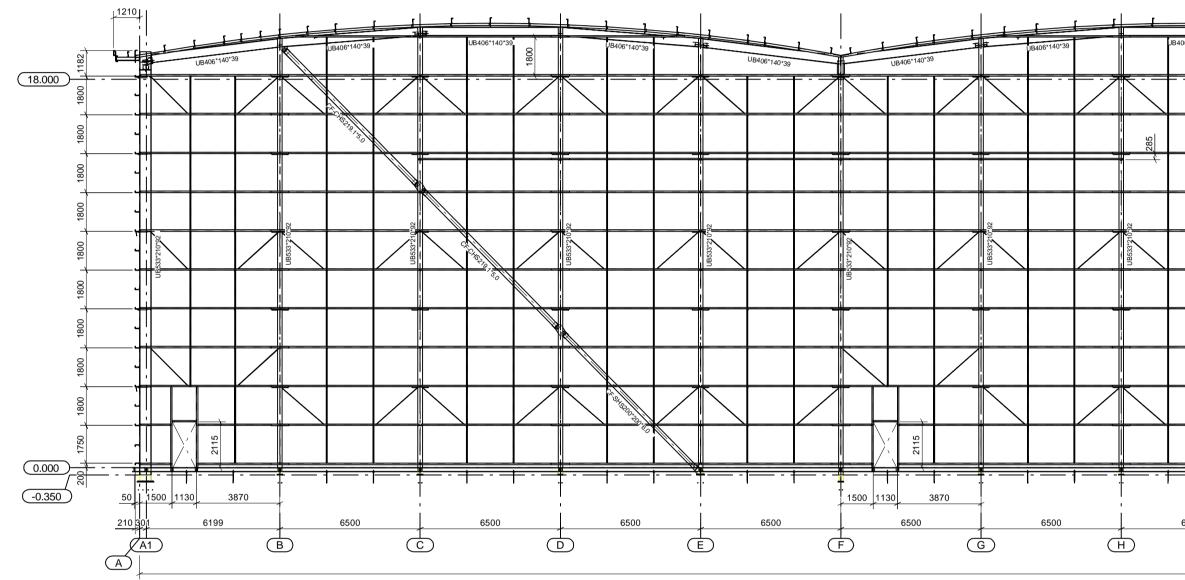


L_	JB406*140*39	]				l	1,			1				*						1	L 1			<b>1</b>	<b>L</b>
	JB406*140*39	1800		JB406*140*39			JB406*140*39			UB406*140*39		UB406*140*39			JB406*140*39	1800		B406*140*39 _	, ,		JB406*140*39			UB406*140*3	9
$\overline{\ }$																									
2004																									
£																		====		= =	= =	: : ===	= = ===	= == =	
			92			26					92			01			01			92					
			UB533*210			UB533*210*		$\square$	533*210*92		UB533*210			UB533*210*			UB533*210*			UB533*210*			293*210*92		
									UB -														- NB		
																				, T					
			$\square$										1		Y   j V										
																					2115	X			
- †		<u> </u>			t	· · · ·	<b>†</b> 1870	1130	 500	<u> </u>	 	†	t :	-		<u> </u>		<u> </u>			0 1	130_1500		<b> </b>	F
	6500	Ć		6500			6500			6500	 	6500 Typical Ba	V C		6500			6500			6500		<u></u>	6500	
			J			k)		-			Ň	i ypioai Da	, (I										R		

Elevation on Grid line 29


Rail SPEC


Metsec Sleeved system OUS Rails 202C15 DTW = Diagonal tie wire SRS = Side rail support TS = Tubular Strut


Cleader angle 100x100 supplied by Caunton fitted by others

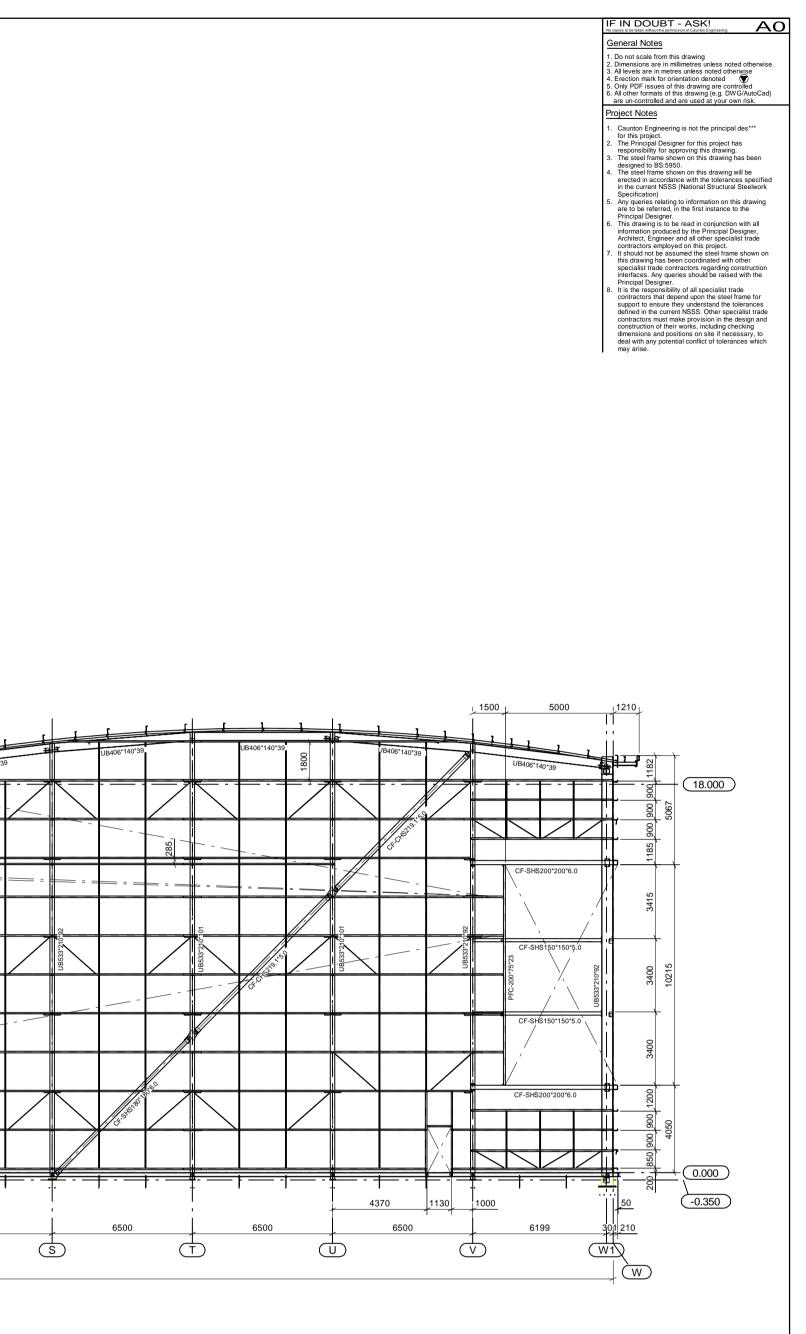


AB01	As-Built Issue		30.06.2022			
C01	Construction Issue		13.10.2021			
P02	Window levels altered. Rails	added	11.08.2021			
P01	22.07.2021					
REV. MARK	REVISION DESCRIPTION		REV. DATE			
		APPROVAL I				
	Concentration Engineering Linited Moorgeen Houstail Park Moorgeen Notingham. Neif SOU Response TEL: 0777-3531111 FAX: 01775-353020 TEL: 0777-3531111 FAX: 01775-353020 TEL: 0777-3531111 FAX: 01775-353020 TEL: 0777-3531111 FAX: 01775-353020					
Client Winvic Project Des Calder						
Site Addres Wakefi						
Drawing Title Elevation on Grid line 29						
Elevali						
Scale 1:125			CEL Job No. 21009			
Scale	CAD	Project Type Design & Build	21009 Date Created			
Scale 1:125 Drawn by			21009			

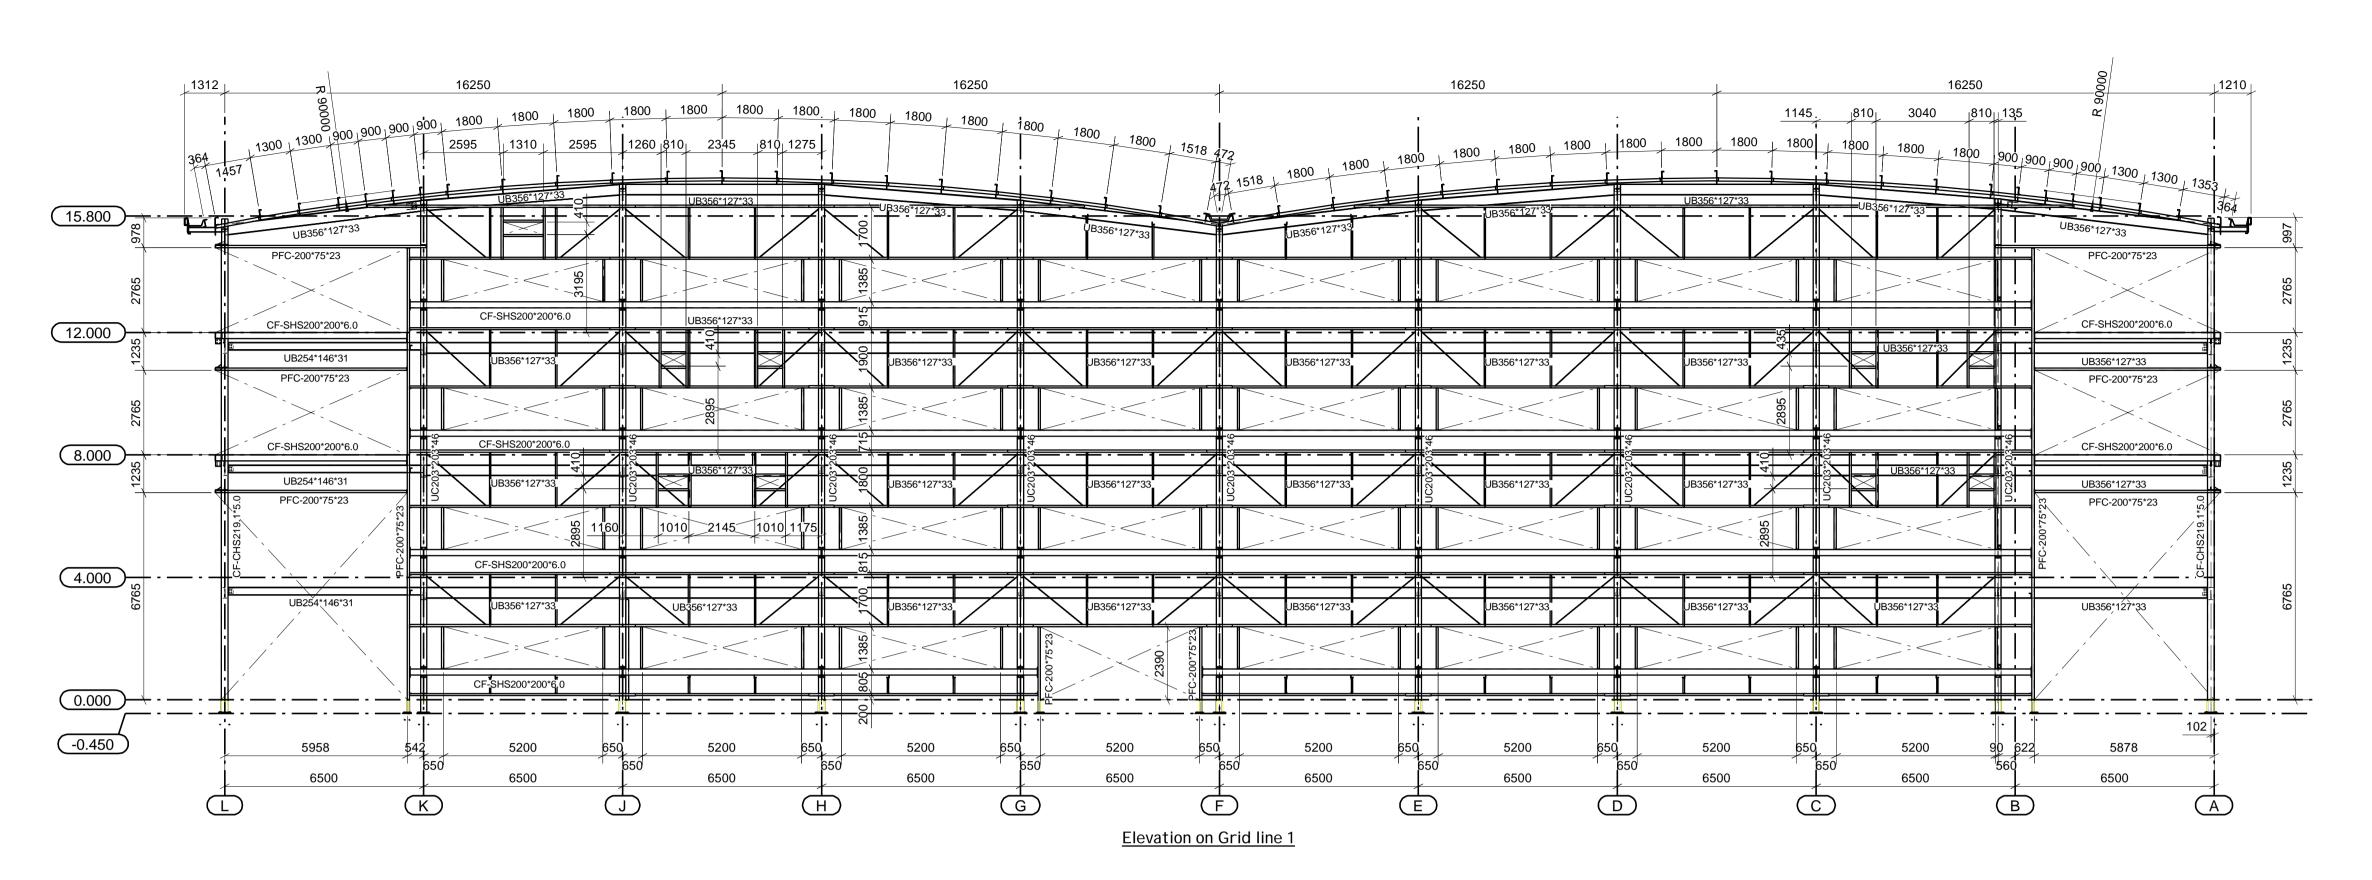

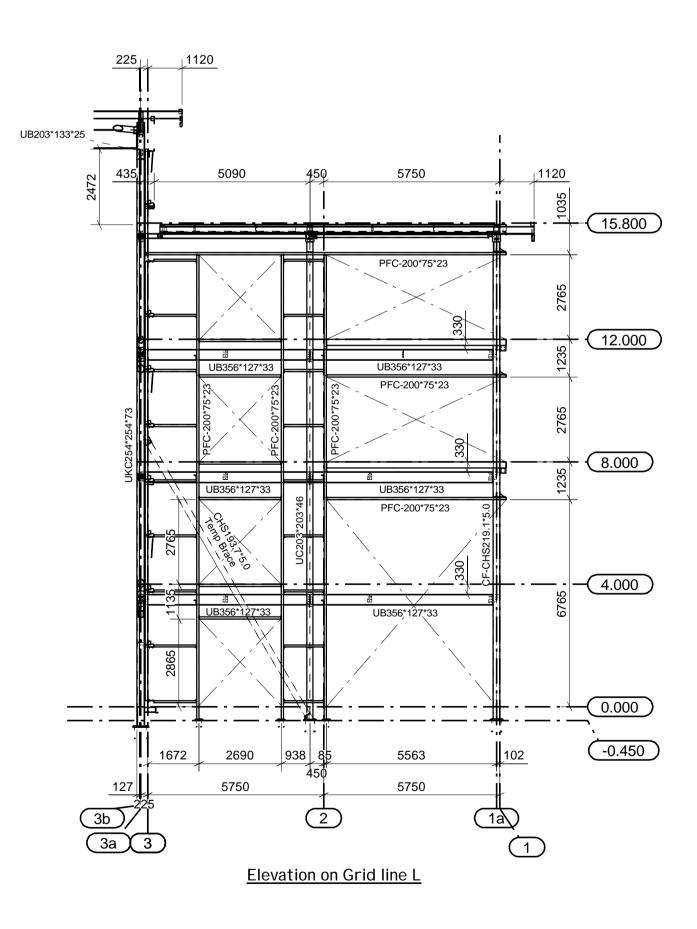

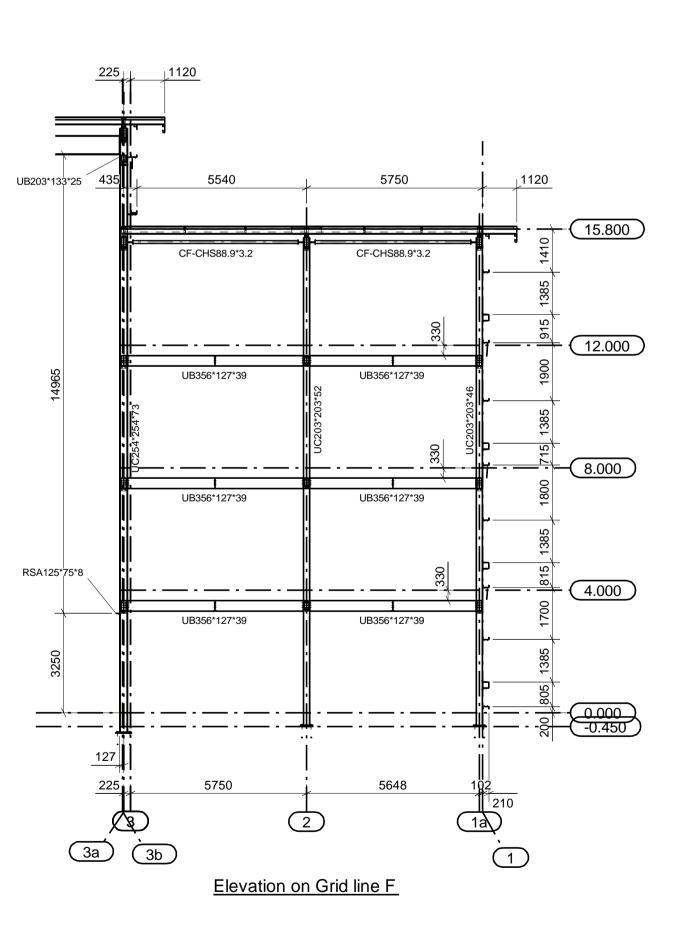

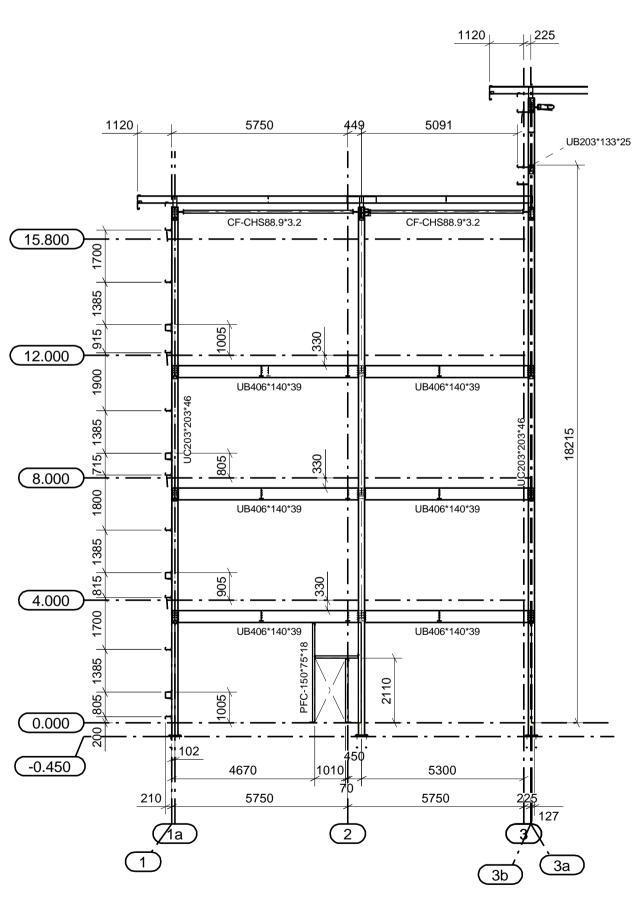

Elevation on Grid line J







- Do not scale from this drawing
   Dimensions are in millimetres unless noted otherwise.
   All levels are in metres unless noted otherwise
   Erection mark for orientation denoted
   Only PDF issues of this drawing are controlled
   All other formats of this drawing {e.g. DWG/AutoCad} are un-controlled and are used at your own risk.

A1

Project Notes


- Caunton Engineering is not the principal des\*\*\* for this project.
   The Principal Designer for this project has responsibility for approving this drawing.
   The steel frame shown on this drawing has been designed to BS:5950.
   The steel frame shown on this drawing will be created in accordance with the tolerances specifier.
- erected in accordance with the tolerances specified in the current NSSS (National Structural Steelwork
- Specification)
  Any queries relating to information on this drawing are to be referred, in the first instance to the
- are to be referred, in the first instance to the Principal Designer.
  6. This drawing is to be read in conjunction with all information produced by the Principal Designer, Architect, Engineer and all other specialist trade contractors employed on this project.
  7. It should not be assumed the steel frame shown on this drawing has been covariated with other.
- It should not be assumed the steel frame shown on this drawing has been coordinated with other specialist trade contractors regarding construction interfaces. Any queries should be raised with the Principal Designer.
   It is the responsibility of all specialist trade contractors that depend upon the steel frame for support to ensure they understand the tolerances defined in the current NSSS. Other specialist trade contractors must make provision in the design and construction of their works. including checking construction of their works, including checking dimensions and positions on site if necessary, to deal with any potential conflict of tolerances which may arise.

Rail SPEC

Metsec Sleeved system OUS Rails 202C15 DTW = Diagonal tie wire SRS = Side rail support TS = Tubular Strut

Cleader angle 100x100 supplied by Caunton fitted by others

AB01	As-Built Issue		30.06.2022							
C03	Louver trimmers added		04.03.2022							
C02	Window cill level altered 01.11.2021									
C01	Construction Issue 13.10.2021									
P02	Window levels altered	Window levels altered 11.08.2021								
P01	Preliminary Issue		26.07.2021							
REV. MARK	REVISION DESCRIPTION	l	REV. DATE							
_		APPROVAL ISSU								
Caunton Engineering Limited Moorgreen Industrial Park Moorgreen, Nottingham. NG16 3QU IEE: 10773-531111 FAX: 01773-532020 Www.caunton.co.uk Tech E-Mail: drawing@caunton.co.uk										
Client										
Project Desc	construction Ltd.									
Calder P										
Site Address Wakefie	ld									
Drawing Title Main Office Elevations										
Scale 1:125			CEL Job No. 21009							
Drawn by MatrixCA	٩D	Project Type Design & Build	Date Created 22.07.2021							
Designed Re	eviewed by		Date Reviewed							
Project P2102	24-CEL-U1-	XX-DR-X-0014	Revision AB01							

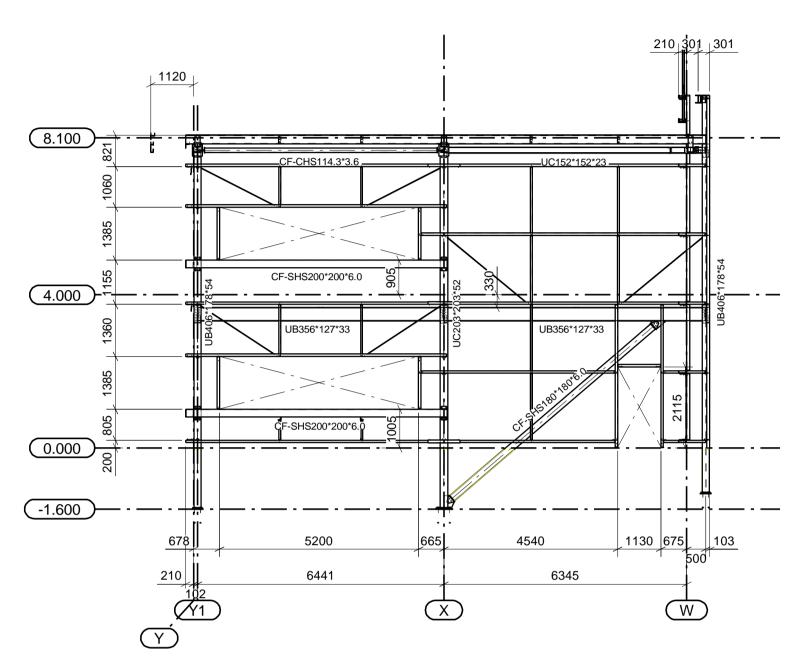



Elevation on Grid line 14a

Rail SPEC


Metsec Sleeved system OUS Rails 202C15 DTW = Diagonal tie wire SRS = Side rail support TS = Tubular Strut

Cleader angle 100x100 supplied by Caunton fitted by others

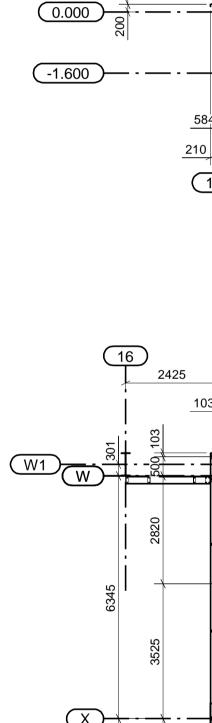


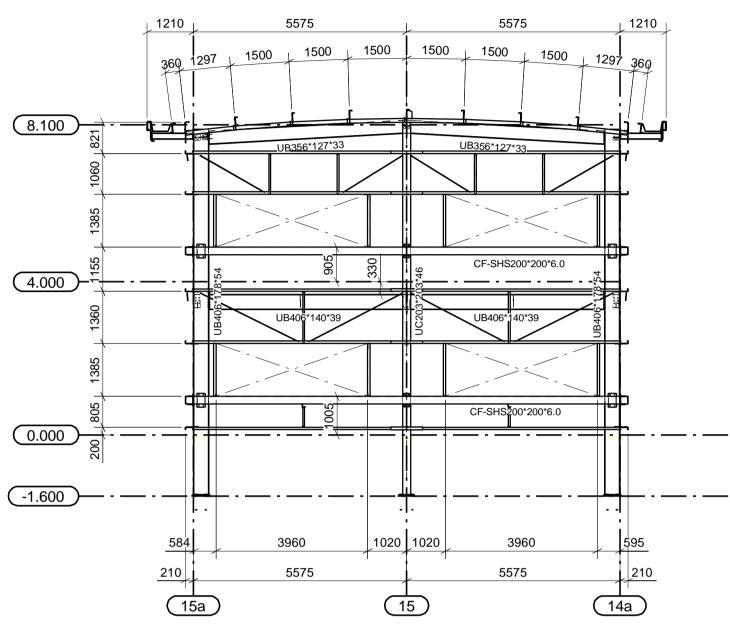


Elevation on Grid line Y

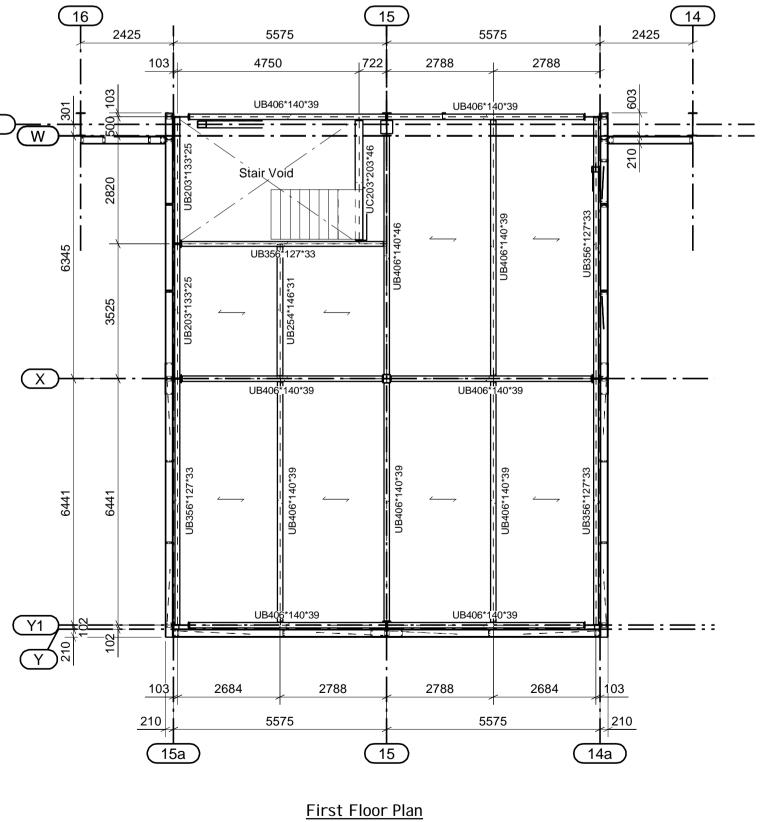

Top of Steel 3.650m

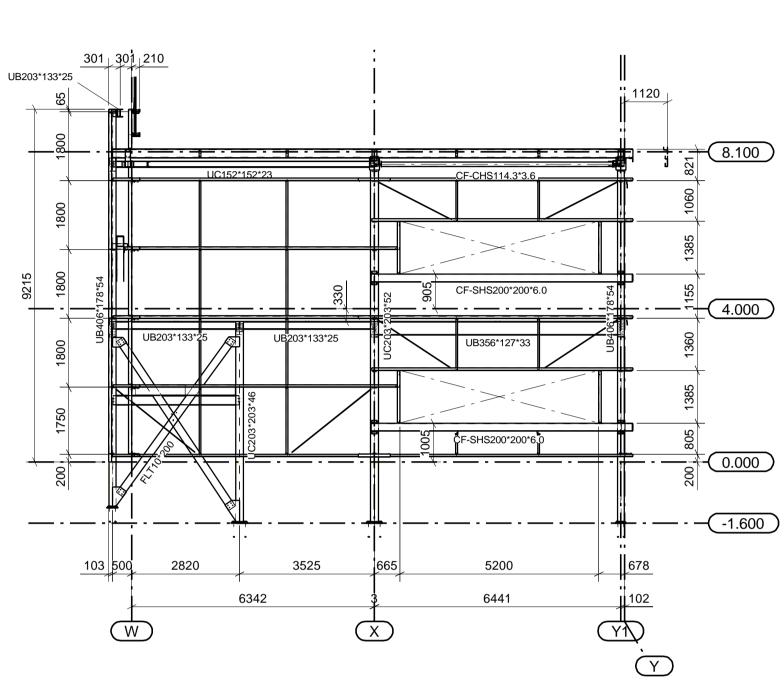

Elevation on Grid line 15a

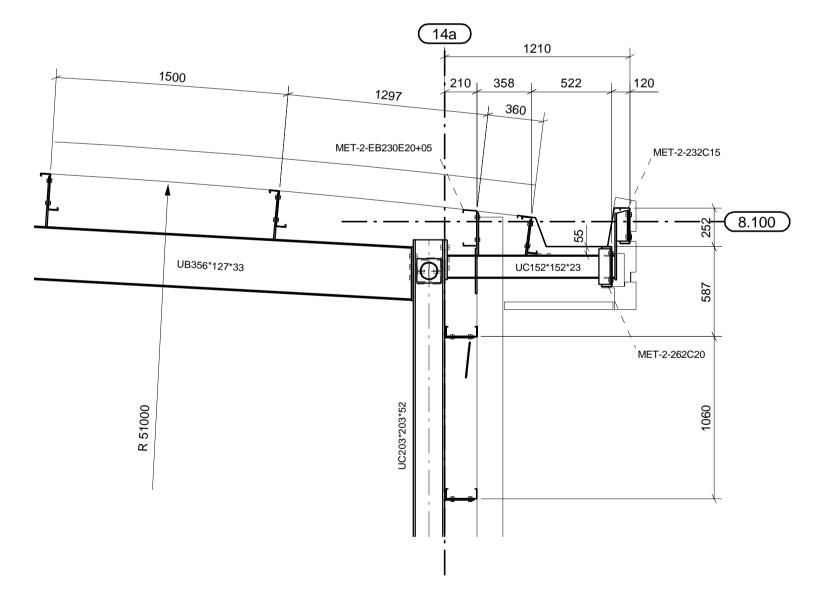




Elevation on Grid line 1

	FIN DOUBT - ASK! A1
G	eneral Notes
2. 3. 4. 5. 6.	Do not scale from this drawing Dimensions are in millimetres unless noted otherwise. All levels are in metres unless noted otherwise Erection mark for orientation denoted Only PDF issues of this drawing are controlled All other formats of this drawing {e.g. DWG/AutoCad} are un-controlled and are used at your own risk.
Pr	oject Notes
1.	Caunton Engineering is not the principal des***
2. 3.	for this project. The Principal Designer for this project has responsibility for approving this drawing. The steel frame shown on this drawing has been
4.	designed to BS:5950. The steel frame shown on this drawing will be erected in accordance with the tolerances specified
5.	in the current NSSS (National Structural Steelwork Specification) Any queries relating to information on this drawing are to be referred, in the first instance to the
6.	Principal Designer. This drawing is to be read in conjunction with all information produced by the Principal Designer,
7.	Architect, Engineer and all other specialist trade contractors employed on this project. It should not be assumed the steel frame shown on this drawing has been coordinated with other specialist trade contractors regarding construction interfaces. Any queries should be raised with the
8.	Principal Designer. It is the responsibility of all specialist trade contractors that depend upon the steel frame for support to ensure they understand the tolerances defined in the current NSSS. Other specialist trade contractors must make provision in the design and construction of their works, including checking dimensions and positions on site if necessary, to deal with any potential conflict of tolerances which
De	may arise.
1. 2. 3. 4. 5. 6.	Metal decking to be MD60 0.9mm. Grade S350 UNO Decking to be double/single span U.N.O. Concrete grade to be S30. 150mm thick. Shear studs are 19mm diameter in accordance with EN ISO 13198 Fire resistance period 60 minutes to suit project. Min mesh A252 cover 40mm from top of slab. Please note the use of flying ends may be
7.	required to achieve the minimum concrete cover. Caunton Engineering are responsible for the design of the metal decking in the temporary and permanent conditions. We will also advise the minimum concrete strength, depth and reinforcement required for our composite beam design and to achieve the minimum fire resistance period. The responsibility for the design of the slab including reinforcement requirements under concentrated loads, at openings or edges, and for anti-crack requirement is to be with others. All slab and reinforcement drawings and schedules, including sitework and day joints, are to be by others.
8.	The supply, delivery and installation of reinforcement
9.	and casting of the slab is to be by others. The design responsibility of the floor as a
10.	diaphragm is to be with others. The design of the deck / steel frame does not include for flood pouring of concrete. Concrete is to be poured to a constant depth above beam top flanges to a tolerance of -0/+10mm. We recommend that the slab is cast in accordance with the guideline set out in the SCI publication P300 "Composite Slabs and beams using steel decking: Best
11.	practice for design and construction". Depending on the quality of the slab pour we anticipate a flatness tolerance of SR3 in accordance with BS:8204. (Max 10mm gap below a 2m

- anticipate a flatness tolerance of SR3 in accordance with BS:8204. (Max 10mm gap below a 2m straight edge).
  12. Number in brackets = min number of studs
  13. Stud requirements on edge beams See Drawing
  14. If no studs noted provide 1 stud in alternative troughs or 600mm centres.
  15. Any slab overhang past flange or support beam to be agreed with Caunton Engineering design department.
  16. Composite edge beams to have shear studs located no closer than 6d (d = stud diameter) from the free edge of the slab.




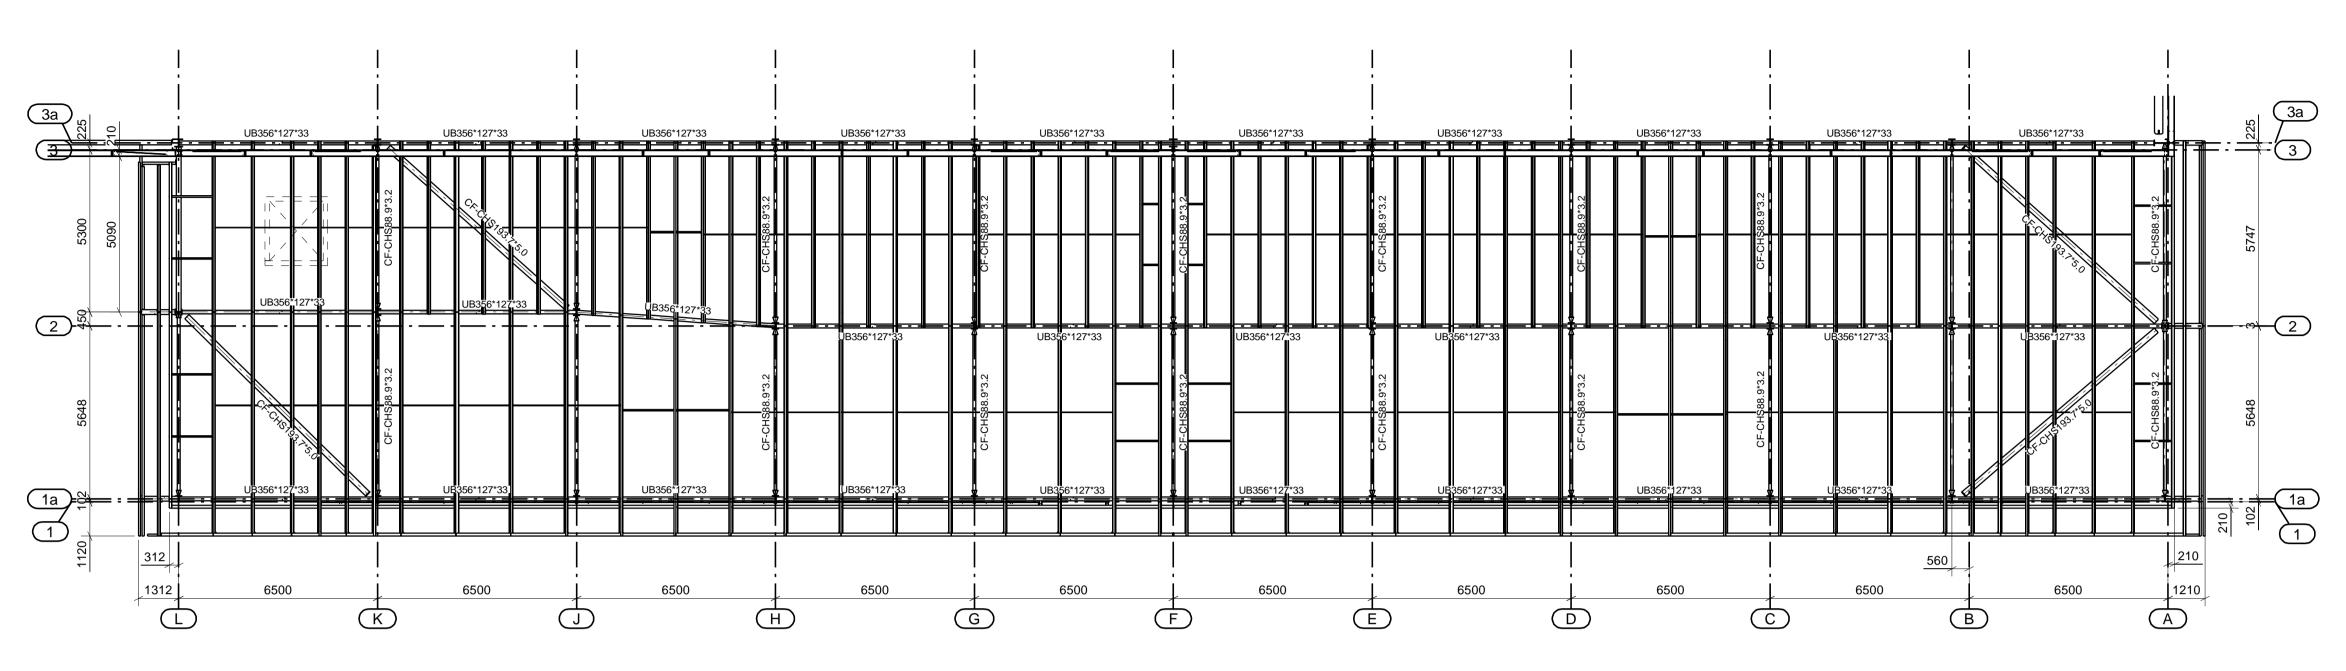

PURLIN SPEC

Metsec Sleved system OUS Purlins Metsec 232Z15 PT = Purlin tie DPB = Diagonal pulin brace EB = Eaves brace SRS = Side rail support AS = Apex Strut

Cleader angle 100x100 supplied by Caunton fitted by others

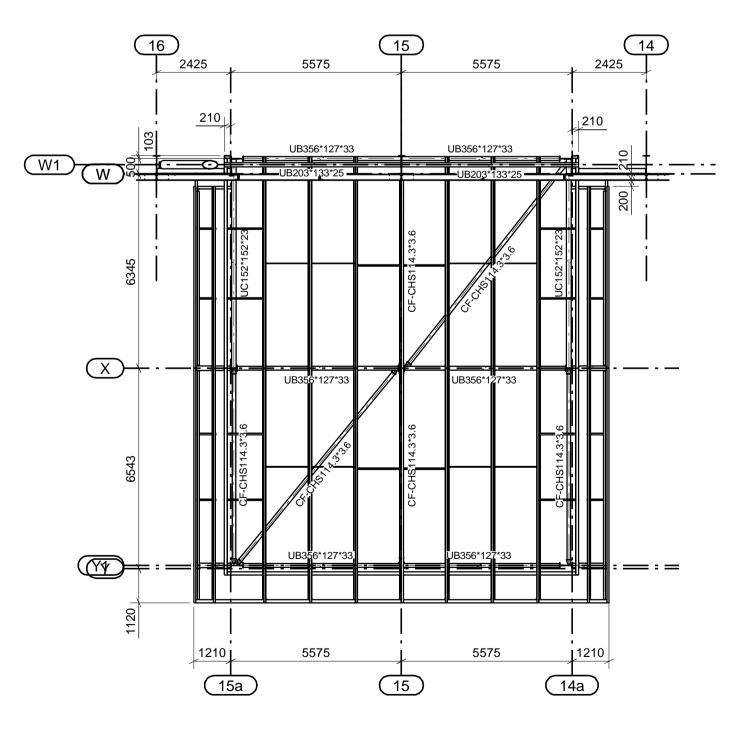

Hub Office Roof Plan

Office Roof Plan

UPEB = Under purlin eaves brace

#### IF IN DOUBT - ASK!


## General Notes


- Do not scale from this drawing
   Dimensions are in millimetres unless noted otherwise.
   All levels are in metres unless noted otherwise
   Erection mark for orientation denoted
   Only PDF issues of this drawing are controlled
   All other formats of this drawing {e.g. DWG/AutoCad} are un-controlled and are used at your own risk. Project Notes


- Caunton Engineering is not the principal des\*\*\*
  for this project.
   The Principal Designer for this project has
  responsibility for approving this drawing.
   The steel frame shown on this drawing has been
  designed to BS:5950.
   The steel frame shown on this drawing will be
  erected in accordance with the tolerances specified
  in the current NSSS (National Structural Steelwork
  Specification)
   Any queries relating to information on this drawing

- Specification)
  Any queries relating to information on this drawing are to be referred, in the first instance to the Principal Designer.
  This drawing is to be read in conjunction with all information produced by the Principal Designer, Architect, Engineer and all other specialist trade contractors employed on this project.
  It should not be assumed the steel frame shown on this drawing has been coordinated with other specialist trade contractors regarding construction interfaces. Any queries should be raised with the Principal Designer.
  It is the responsibility of all specialist trade contractors that depend upon the steel frame for support to ensure they understand the tolerances defined in the current NSSS. Other specialist trade contractors must make provision in the design and construction of their works, including checking construction of their works, including checking dimensions and positions on site if necessary, to deal with any potential conflict of tolerances which may arise.

AB01	As-Built Issue		30.06.2022			
C01		13.10.2021				
P02	Purlins added. Roof Bracing	11.08.2021				
P01	Preliminary Issue		26.07.2021			
REV. MARK	REVISION DESCRIPTION	N	REV. DATE			
	STATUS : A	APPROVAL ISSU	E			
Caunton Engineering Limited Moorgreen Industrial Park Moorgreen, Nottingham. NG16 3QU TEL: 01773-531101 FAX: 01773-532020 Www.caunton.co.uk Tech-Mait: drawing@eaunton.co.uk						
Client						
	onstruction Ltd.					
Project Desc Calder P						
Site Address Wakefie	ld					
Drawing Title	· •					
Office Roof Plans						
Scale 1:125			CEL Job No. 21009			
Drawn by MatrixCA	٨D		Date Created 23.07.2021			
Designed Re	viewed by	[	Date Reviewed			
Project P2102	Company Volume Level	Type Role Drawing No. •XX-DR-X-0016	Revision AB01			

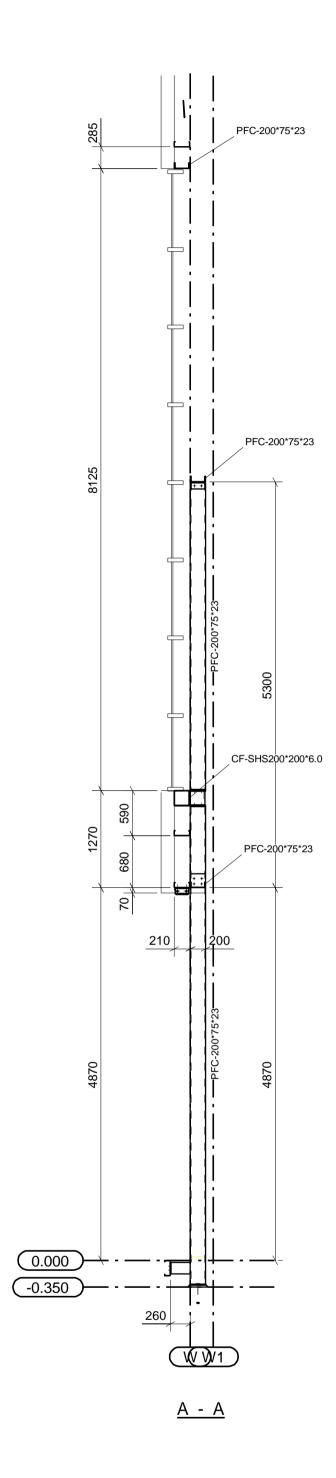

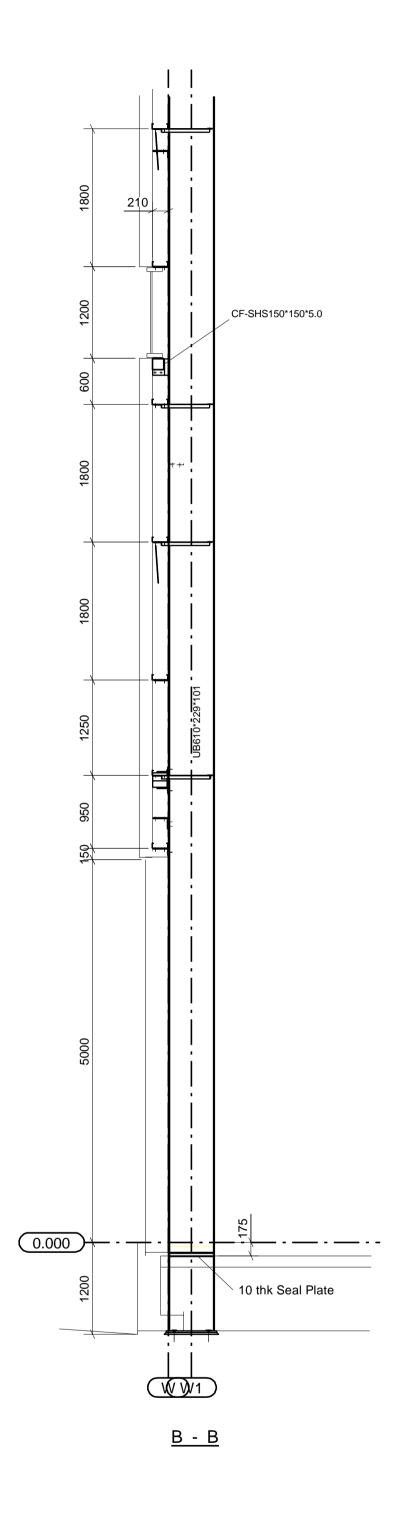

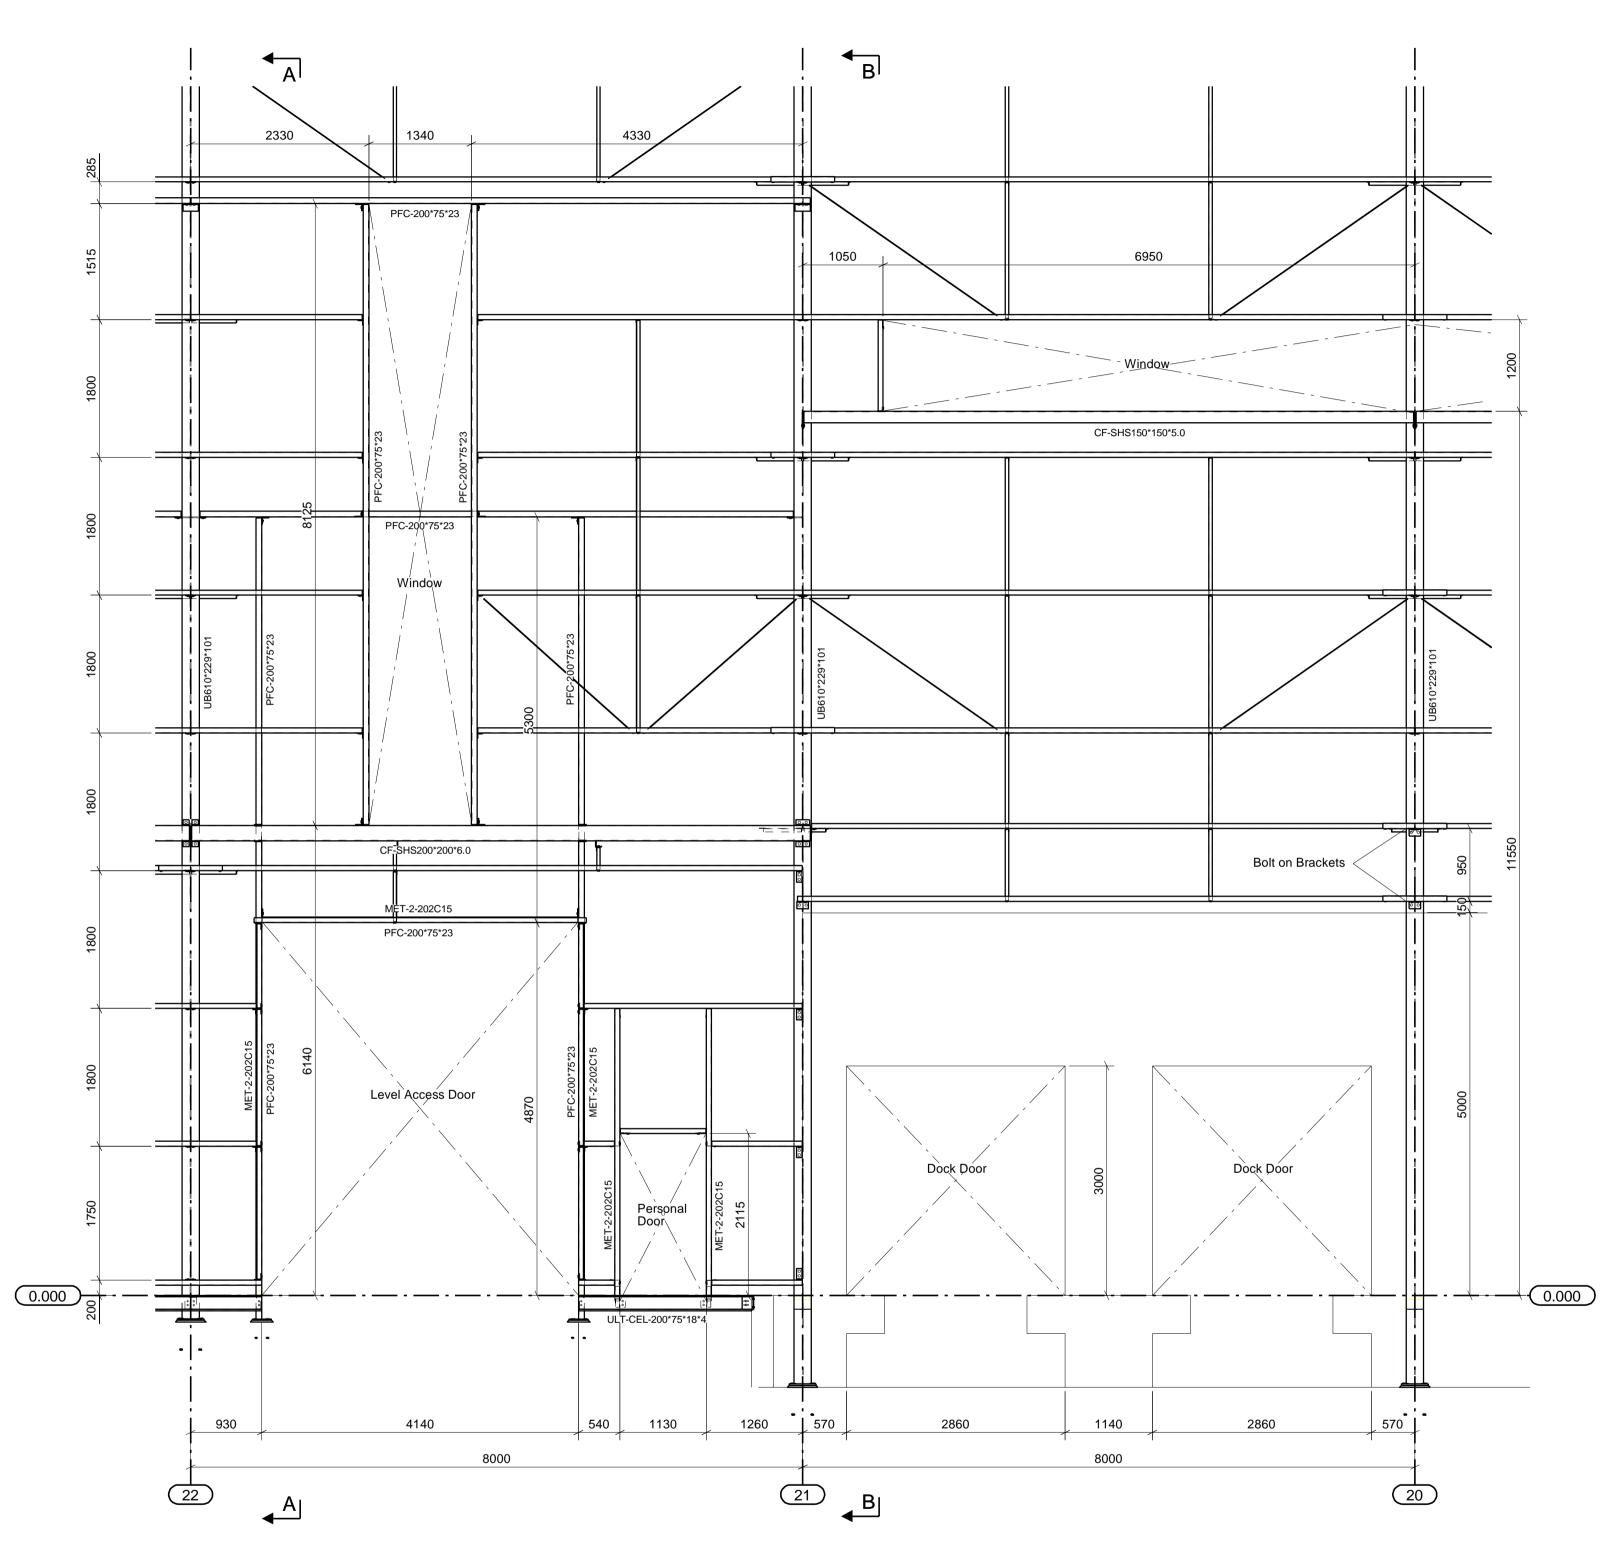

Elevation on Grid line W


## IF IN DOUBT - ASK!


### General Notes


- Do not scale from this drawing
   Dimensions are in millimetres unless noted otherwise.
   All levels are in metres unless noted otherwise
   Erection mark for orientation denoted
   Only PDF issues of this drawing are controlled
   All other formats of this drawing {e.g. DWG/AutoCad} are un-controlled and are used at your own risk. Project Notes


- Project Notes
   Caunton Engineering is not the principal des\*\*\* for this project.
   The Principal Designer for this project has responsibility for approving this drawing.
   The steel frame shown on this drawing has been designed to BS:5950.
   The steel frame shown on this drawing will be erected in accordance with the tolerances specified in the current NSSS (National Structural Steelwork Specification)
   Any queries relating to information on this drawing are to be referred, in the first instance to the Principal Designer.
   This drawing is to be read in conjunction with all information produced by the Principal Designer, Architect, Engineer and all other specialist trade contractors employed on this project.
   It should not be assumed the steel frame shown on this drawing has been coordinated with other specialist trade contractors regarding construction interfaces. Any queries should be raised with the Principal Designer.
   It is the responsibility of all specialist trade contractors that depend upon the steel frame for support to ensure they understand the tolerances defined in the current NSSS. Other specialist trade constructor of their works, including checking dimensions and positions on site if necessary, to deal with any potential conflict of tolerances which may arise.


AB01	As-Built Issue		30.06.2022				
C01	Construction Issue		13.10.2021				
P02	Window levels altered		11.08.2021				
P01	Preliminary Issue	26.07.2021					
REV. MARK	REVISION DESCRIPTION	l	REV. DATE				
	STATUS : A	APPROVAL ISSU	E				
Caunton Engineering Limited Moorgreen Industrial Park Moorgreen, Nottingham. NG16 3QU TEL: 01773-531111 FAX: 01773-532020 www.caunton.co.uk Tech E-Mail: drawing@caunton.co.uk							
Winvic C	Construction Ltd.						
Project Desc Calder P							
Site Address Wakefie							
Drawing Title Door and Window Details							
Scale 1:50			CEL Job No. 21009				
Drawn by MatrixCA	AD.		Date Created 23.07.2021				
Designed Re	eviewed by		Date Reviewed				
Project P2102	roject Company Volume Level Type Role Drawing No. Revision P21024-CEL-U1-XX-DR-X-0017 AB01						

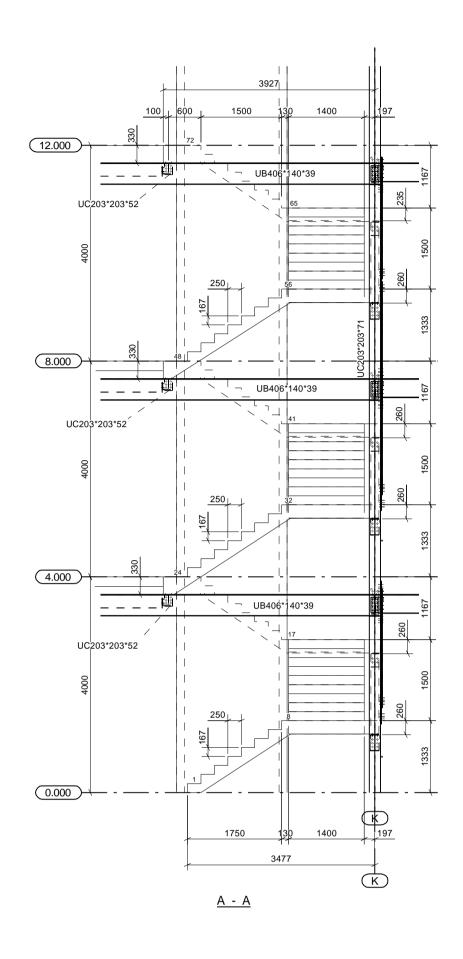

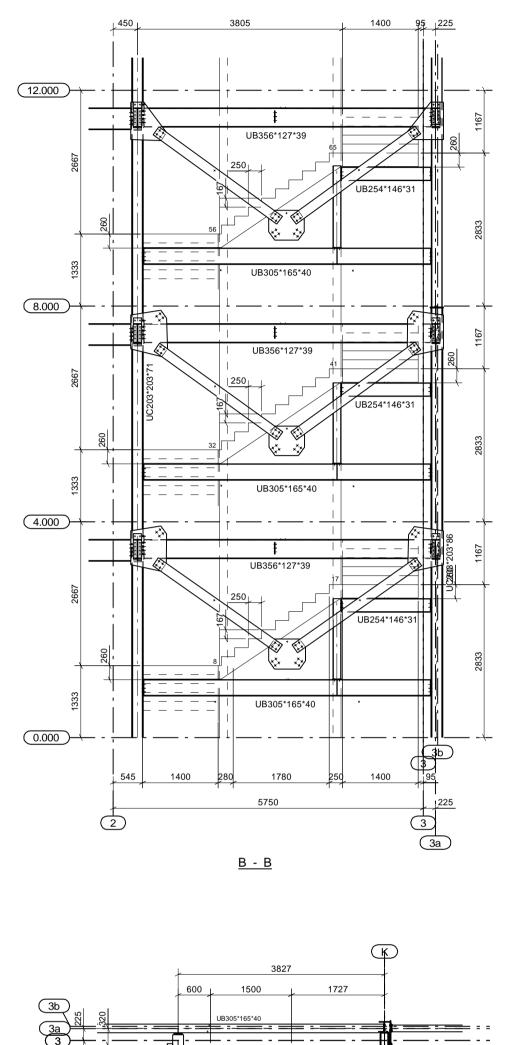


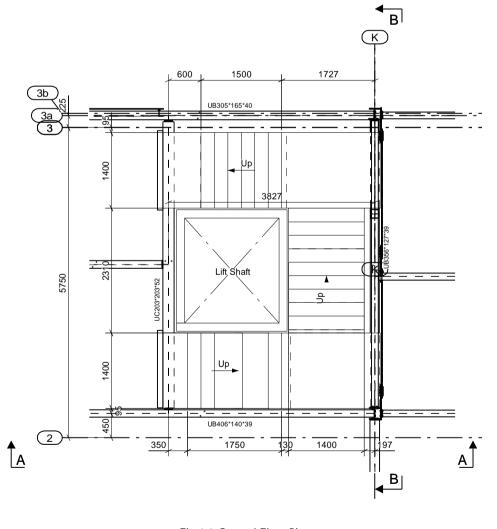


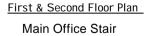


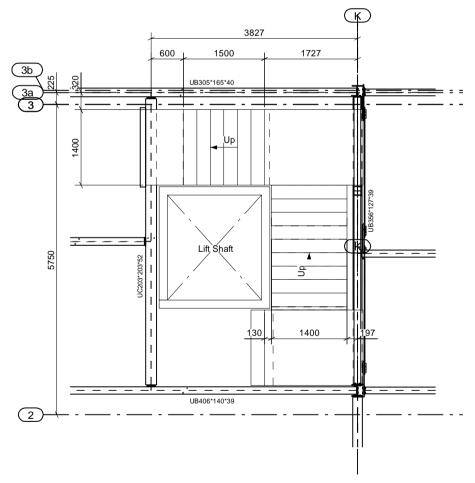


<u>Third Floor Plan</u> Main Office Stair

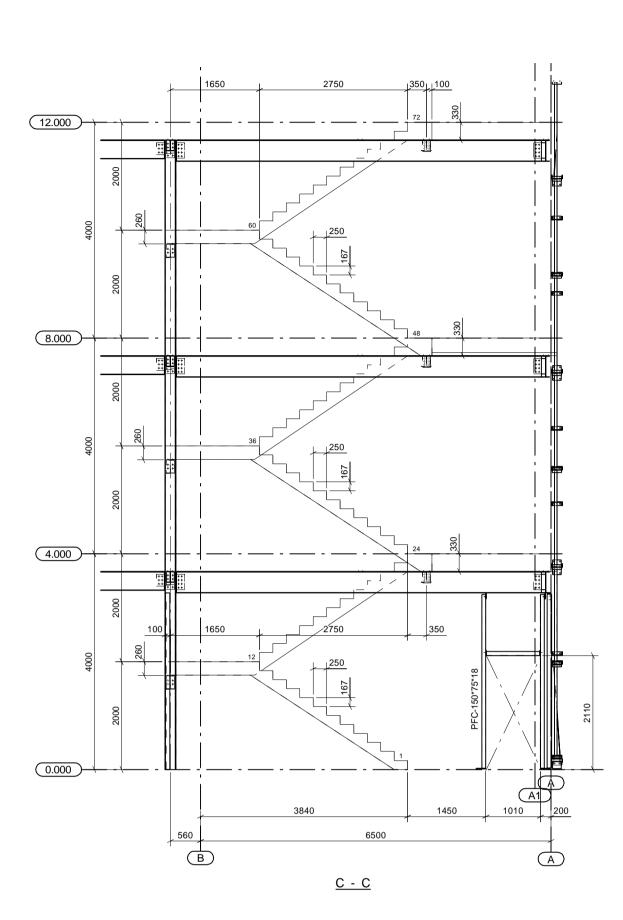

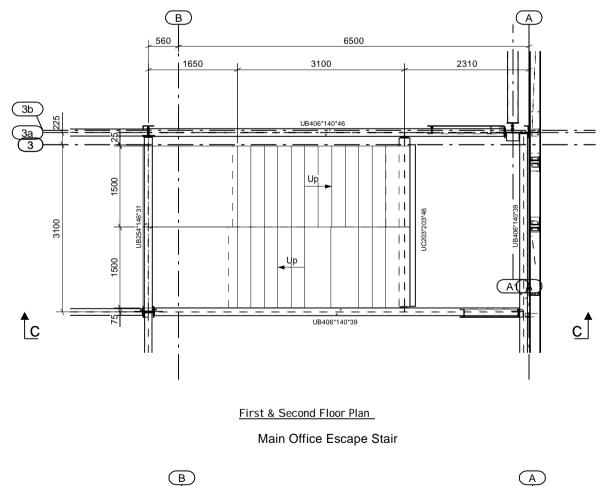

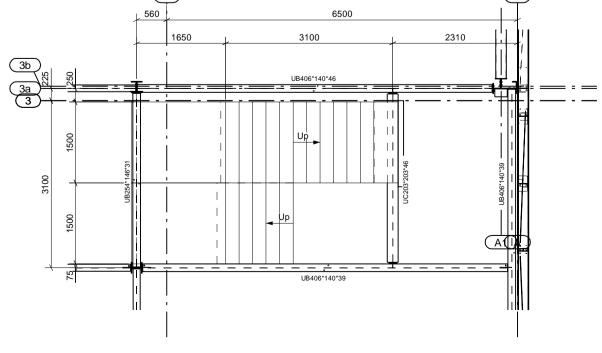

Third Floor Plan Main Office Escape Stair

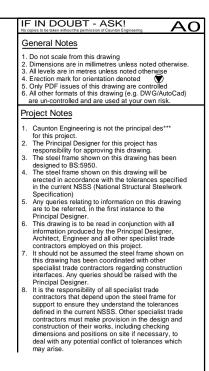


B01 As-Built Issue 1 Stair Flights altered Top of Steel level altered


STATUS : APPROVAL ISSUE

Caunton Engineering Limited Moorgreen Industrial Park Moorgreen, Nottingham, NG16 3QU TEL: 01773-531111 FAX: 01773-532020 www.cauton.co.uk Tech E-Mail: drawing@caunton.co.uk

Design & Build

21024-CEL-U1-XX-DR-X-0018 AB01

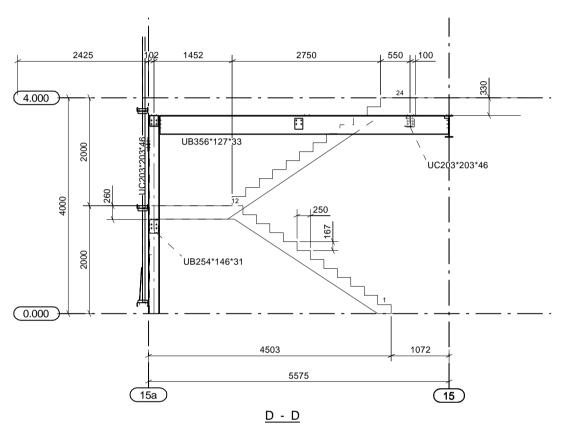

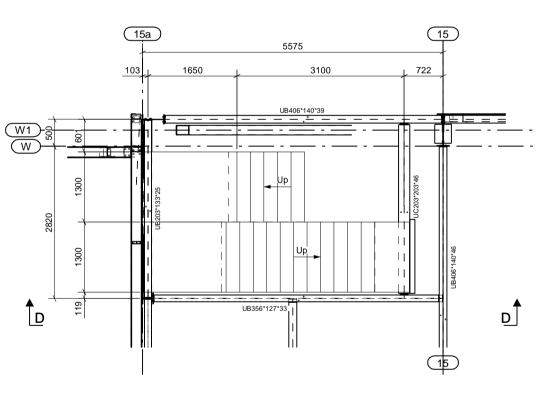

First Floor Plan Hub Office Stair