


P21-024 Calder Park

Drawing Register: MR Industrial

**Works Completed: Stainless
Staircase & Balustrades**


Drawing No.	Drawing Title	Rev
P21024-MRI-U1-DR-X-3001	General Views 1&2nd Floor Atrium Balustrade	AB-Z01
P21024-MRI-U1-ZZ-DR-X-1001	General Views Entrance Foyer Stair	AB-Z01
P21024-MRI-U1-ZZ-DR-X-4001	Fire Escape Stair Balustrade - Sections	AB-Z01
P21024-MRI-U1-ZZ-DR-X-4002	Fire Escape Stair Balustrade - Plan Views	AB-Z01
P21024-MRI-ZZ-ZZ-DR-X-6001	Hub Office Stair Balustrade - Sections	AB-Z01

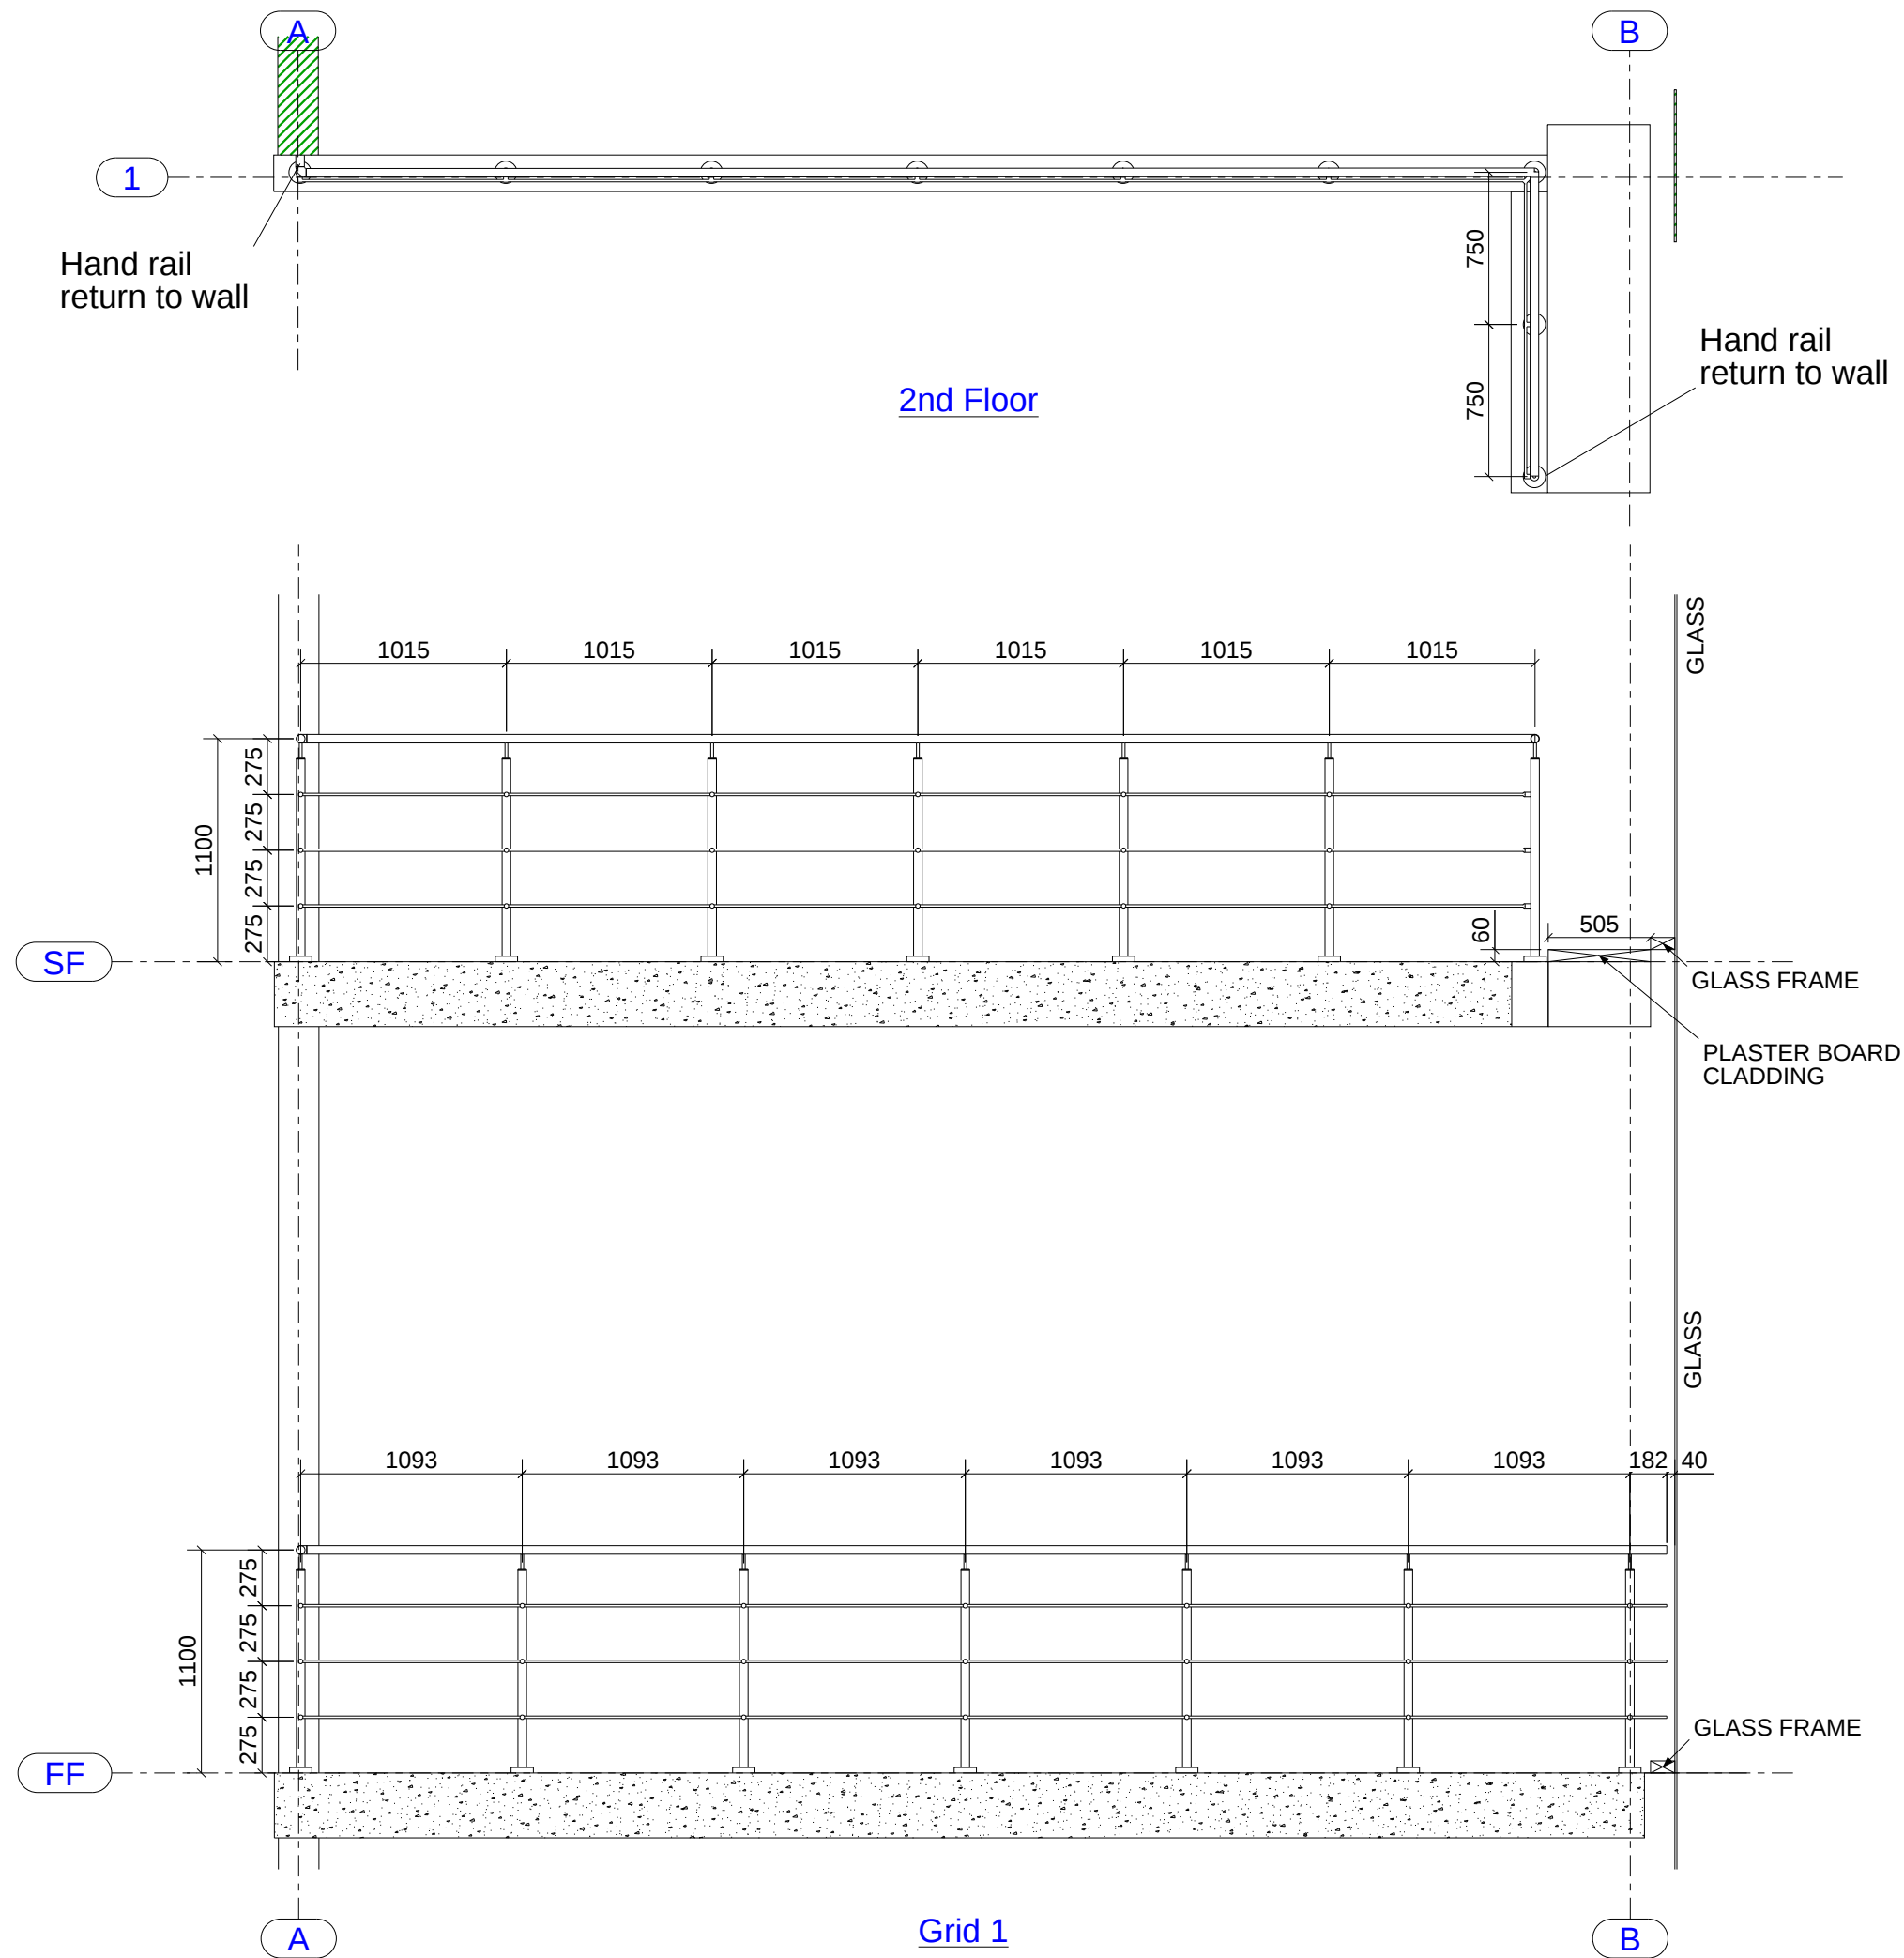


Specification:

Handrail - Ø42.4mm Stainless Steel
(AISI 304) Brushed FinishStanchions - Ø42.4mm Stainless Steel
(AISI 304) Brushed FinishInfill Bars - Ø12mm Stainless Steel
(AISI 304) Brushed Finish


Z01	As Built	NM	29.07.2022							
P03	1st floor post centres changed	NM	16.06.2022							
P02	2nd Floor return	NM	09.06.2022							
P01	For Approval/Comment	NM	01.06.2022							
REV MARK	DESCRIPTION	By	Date	By	Date					
		CREATED		CHECKED						
CLIENT: Winvic										
PROJECT: Calder Park										
										
DRAWING TITLE:		General Views								
CONTRACT:		1st & 2nd Floor Atrium Balustrade								
DRAWN BY:		NM	ISSUE DATE		01.06.2022					
CONTRACT NO:		1160-103	SCALE		1:35					
DRAWING NO:		P21024-MRI-U1-ZZ-DR-X-3001	REVISION No.		Z01					

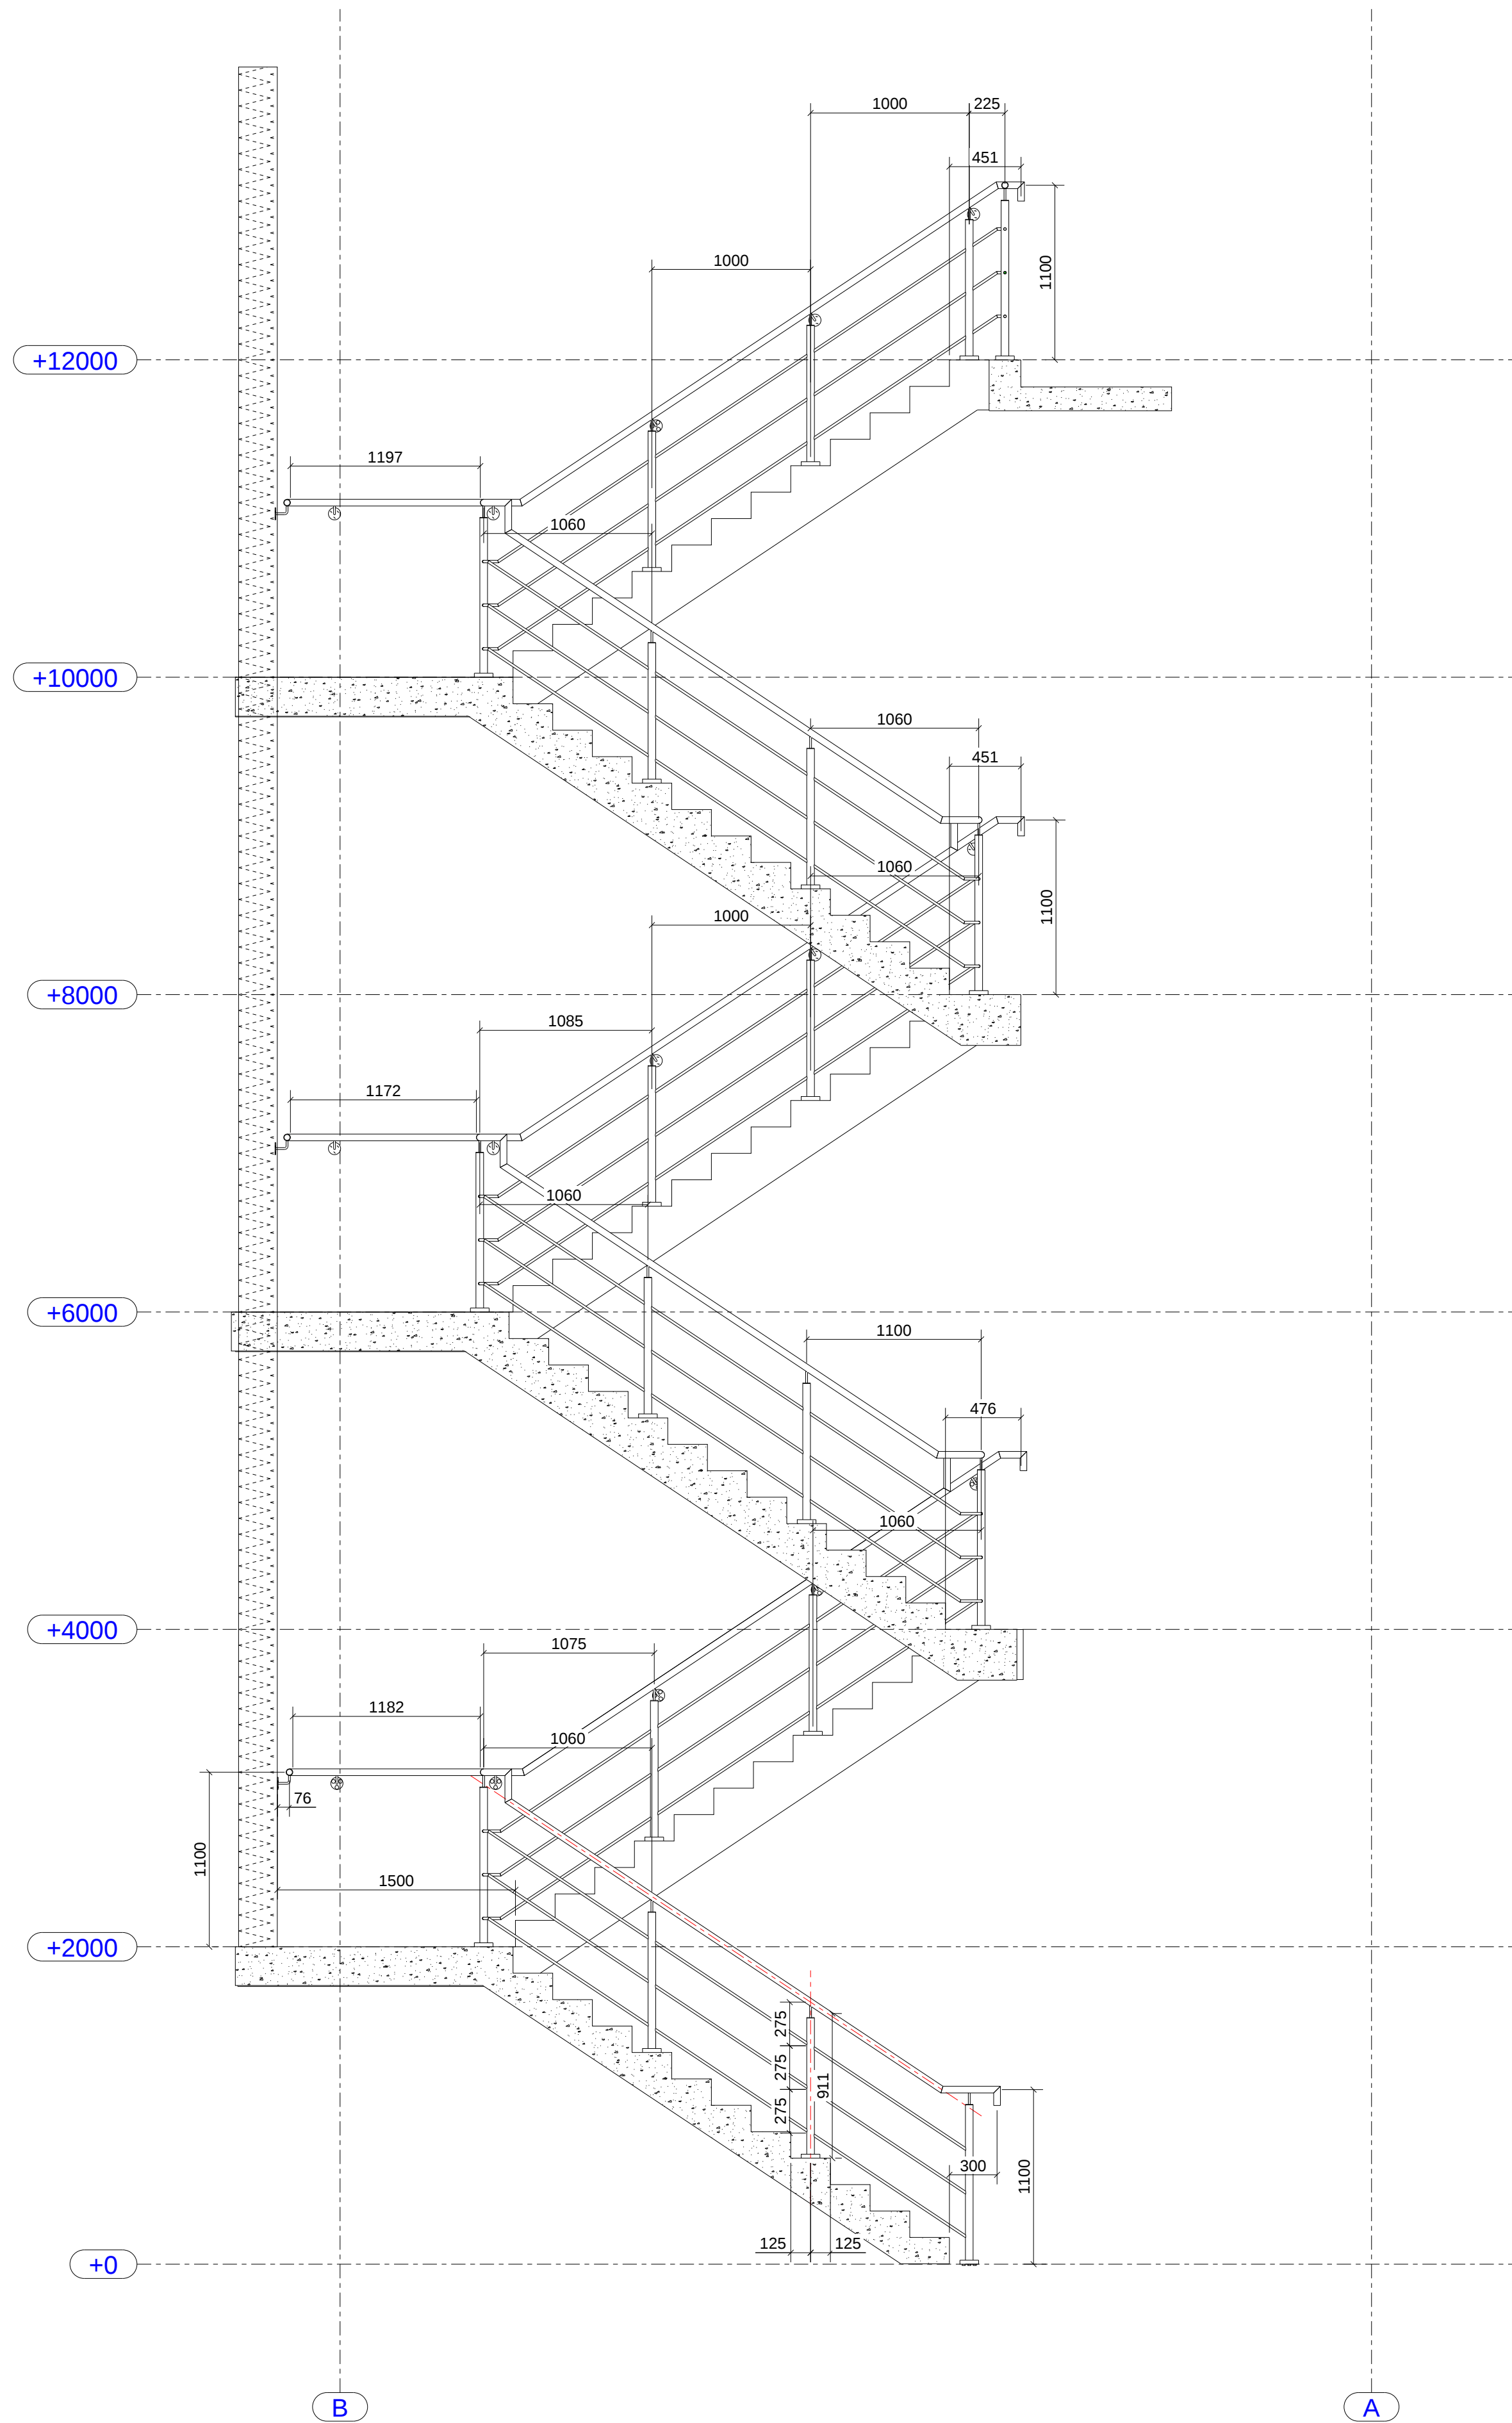

Section A - A

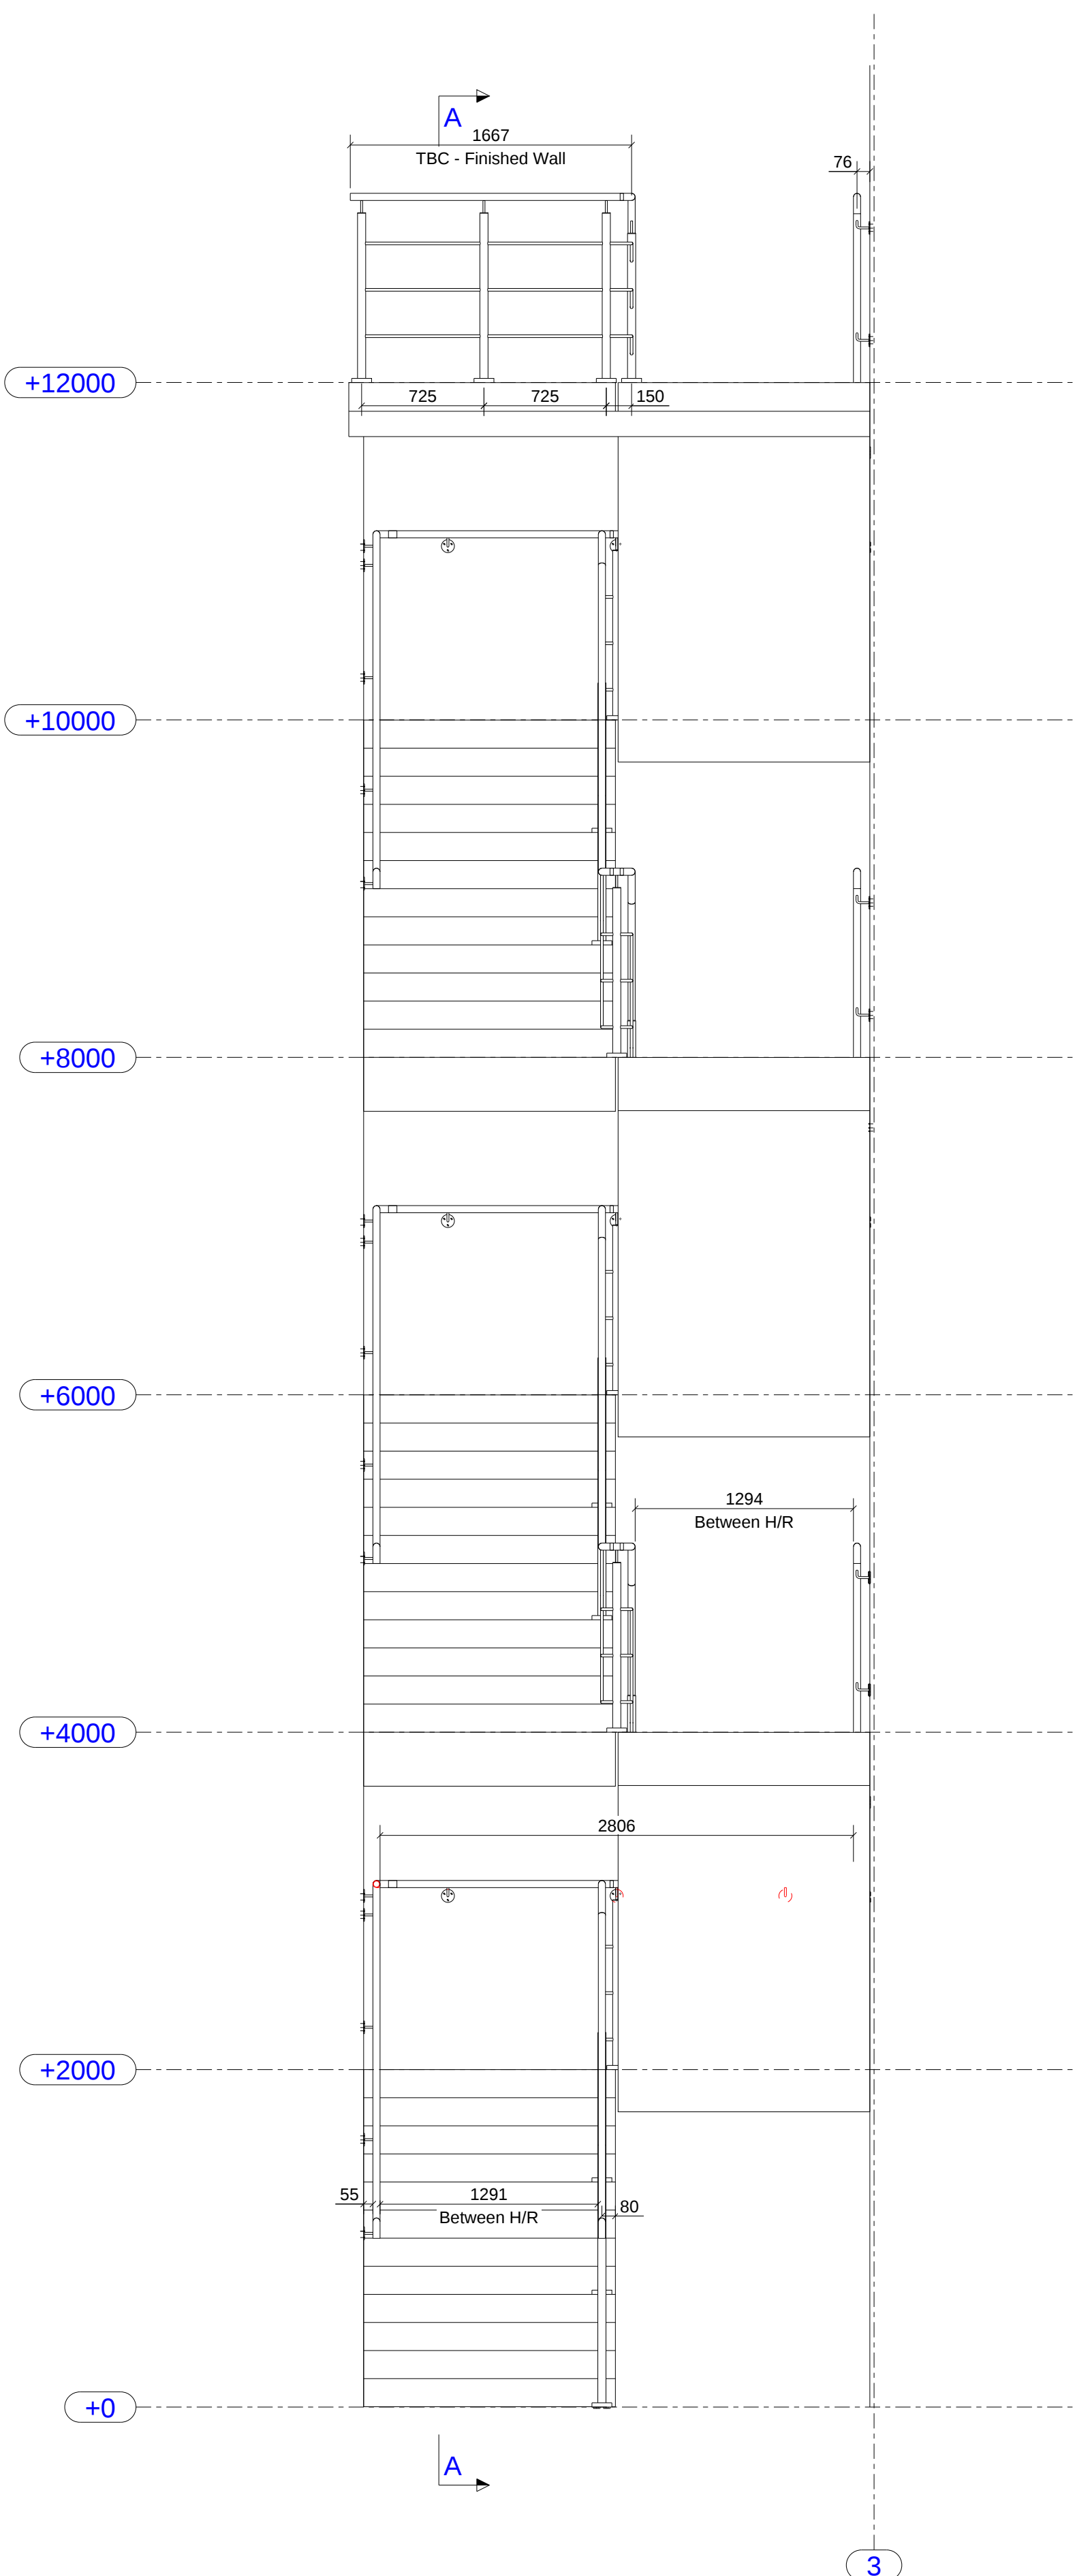


Grid A

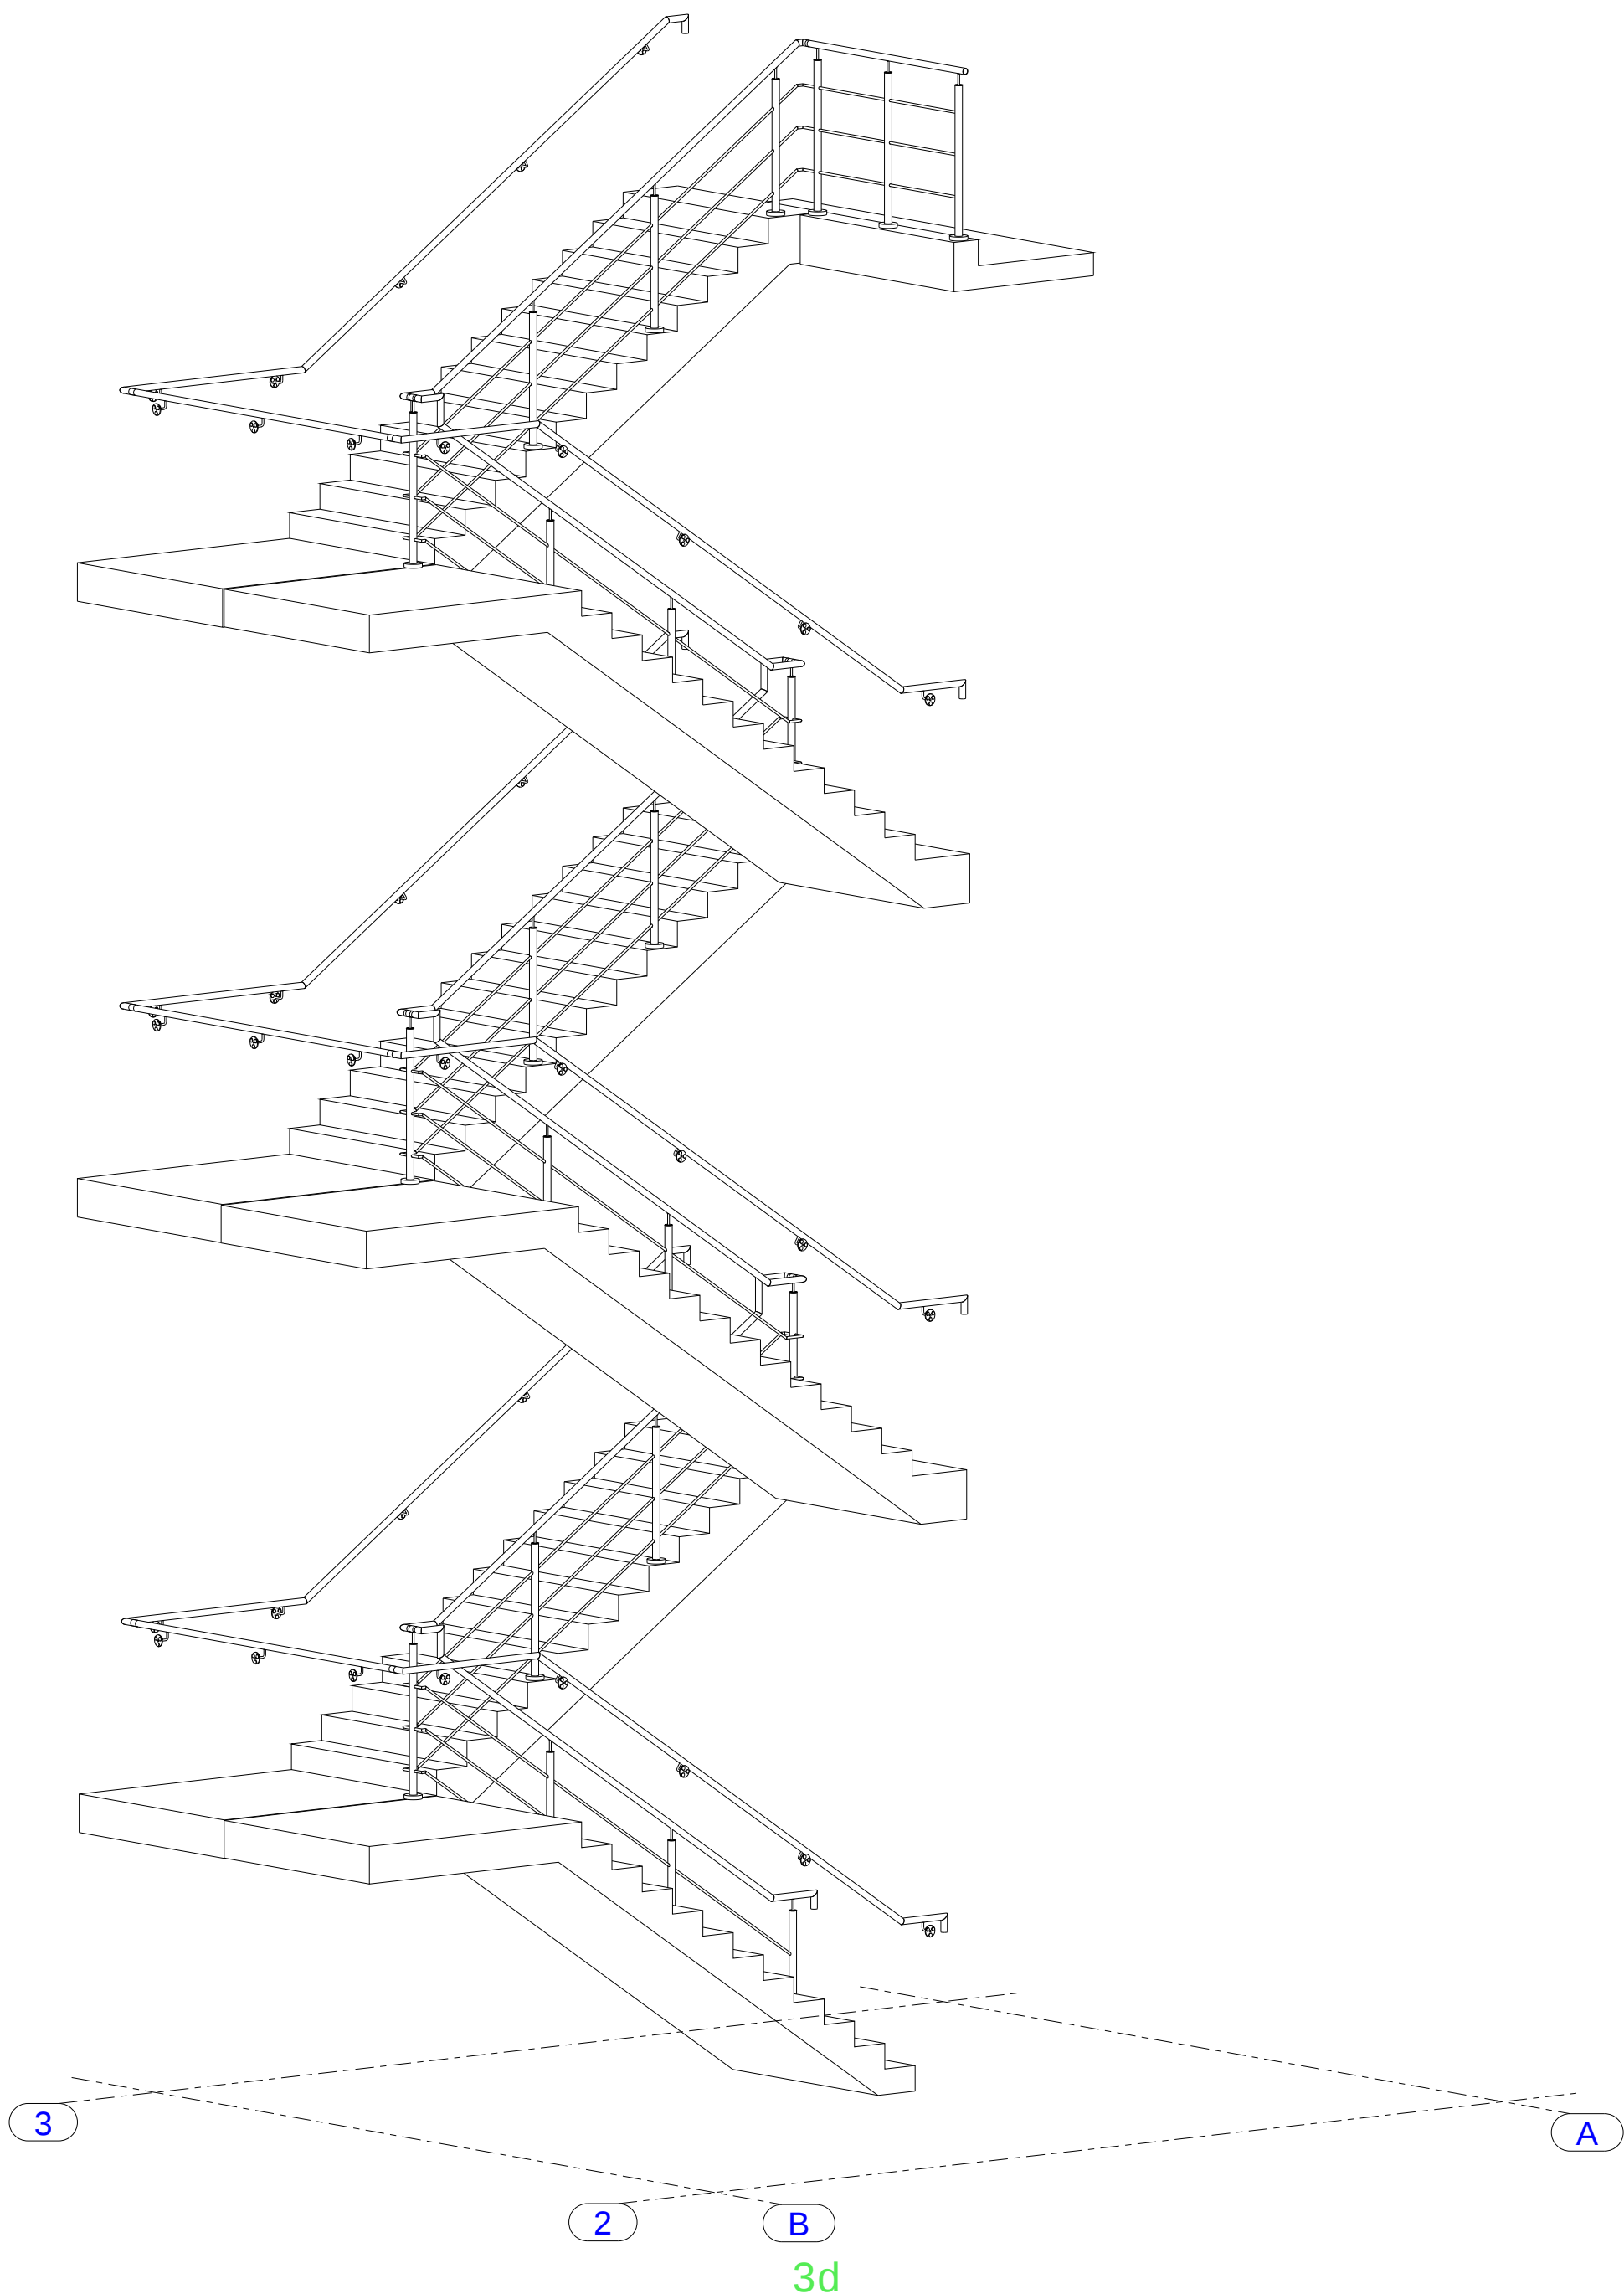


Specification:
Welded mild-steel Balustrade and handrails
powder coated in RAL 7016 (Anthracite Grey).
Handrail - Ø42.4mm
Stanchions - Ø48.3mm
Balustrade infill bars - Ø16mm

Z01	As Built	NM	29.07.2022		
C01	For Construction	NM	28.06.2022		
P01	For Approval/Comment	NM	11.05.2022		
REV. MARK.	DESCRIPTION	By	Date	By	Date
		CREATED		CHECKED	
CLIENT: Winvic					
PROJECT: Calder Park					
DRAWING TITLE: Sections					
CONTRACT: Fire Escape Stair Balustrade					
DRAWN BY: NM		ISSUE DATE 11.05.2022			
CONTRACT NO: 1160-104		SCALE 1:30 1:40			
DRAWING NO: P21024-MRI-U1-ZZ-DR-X-4001		REVISION No. Z01			




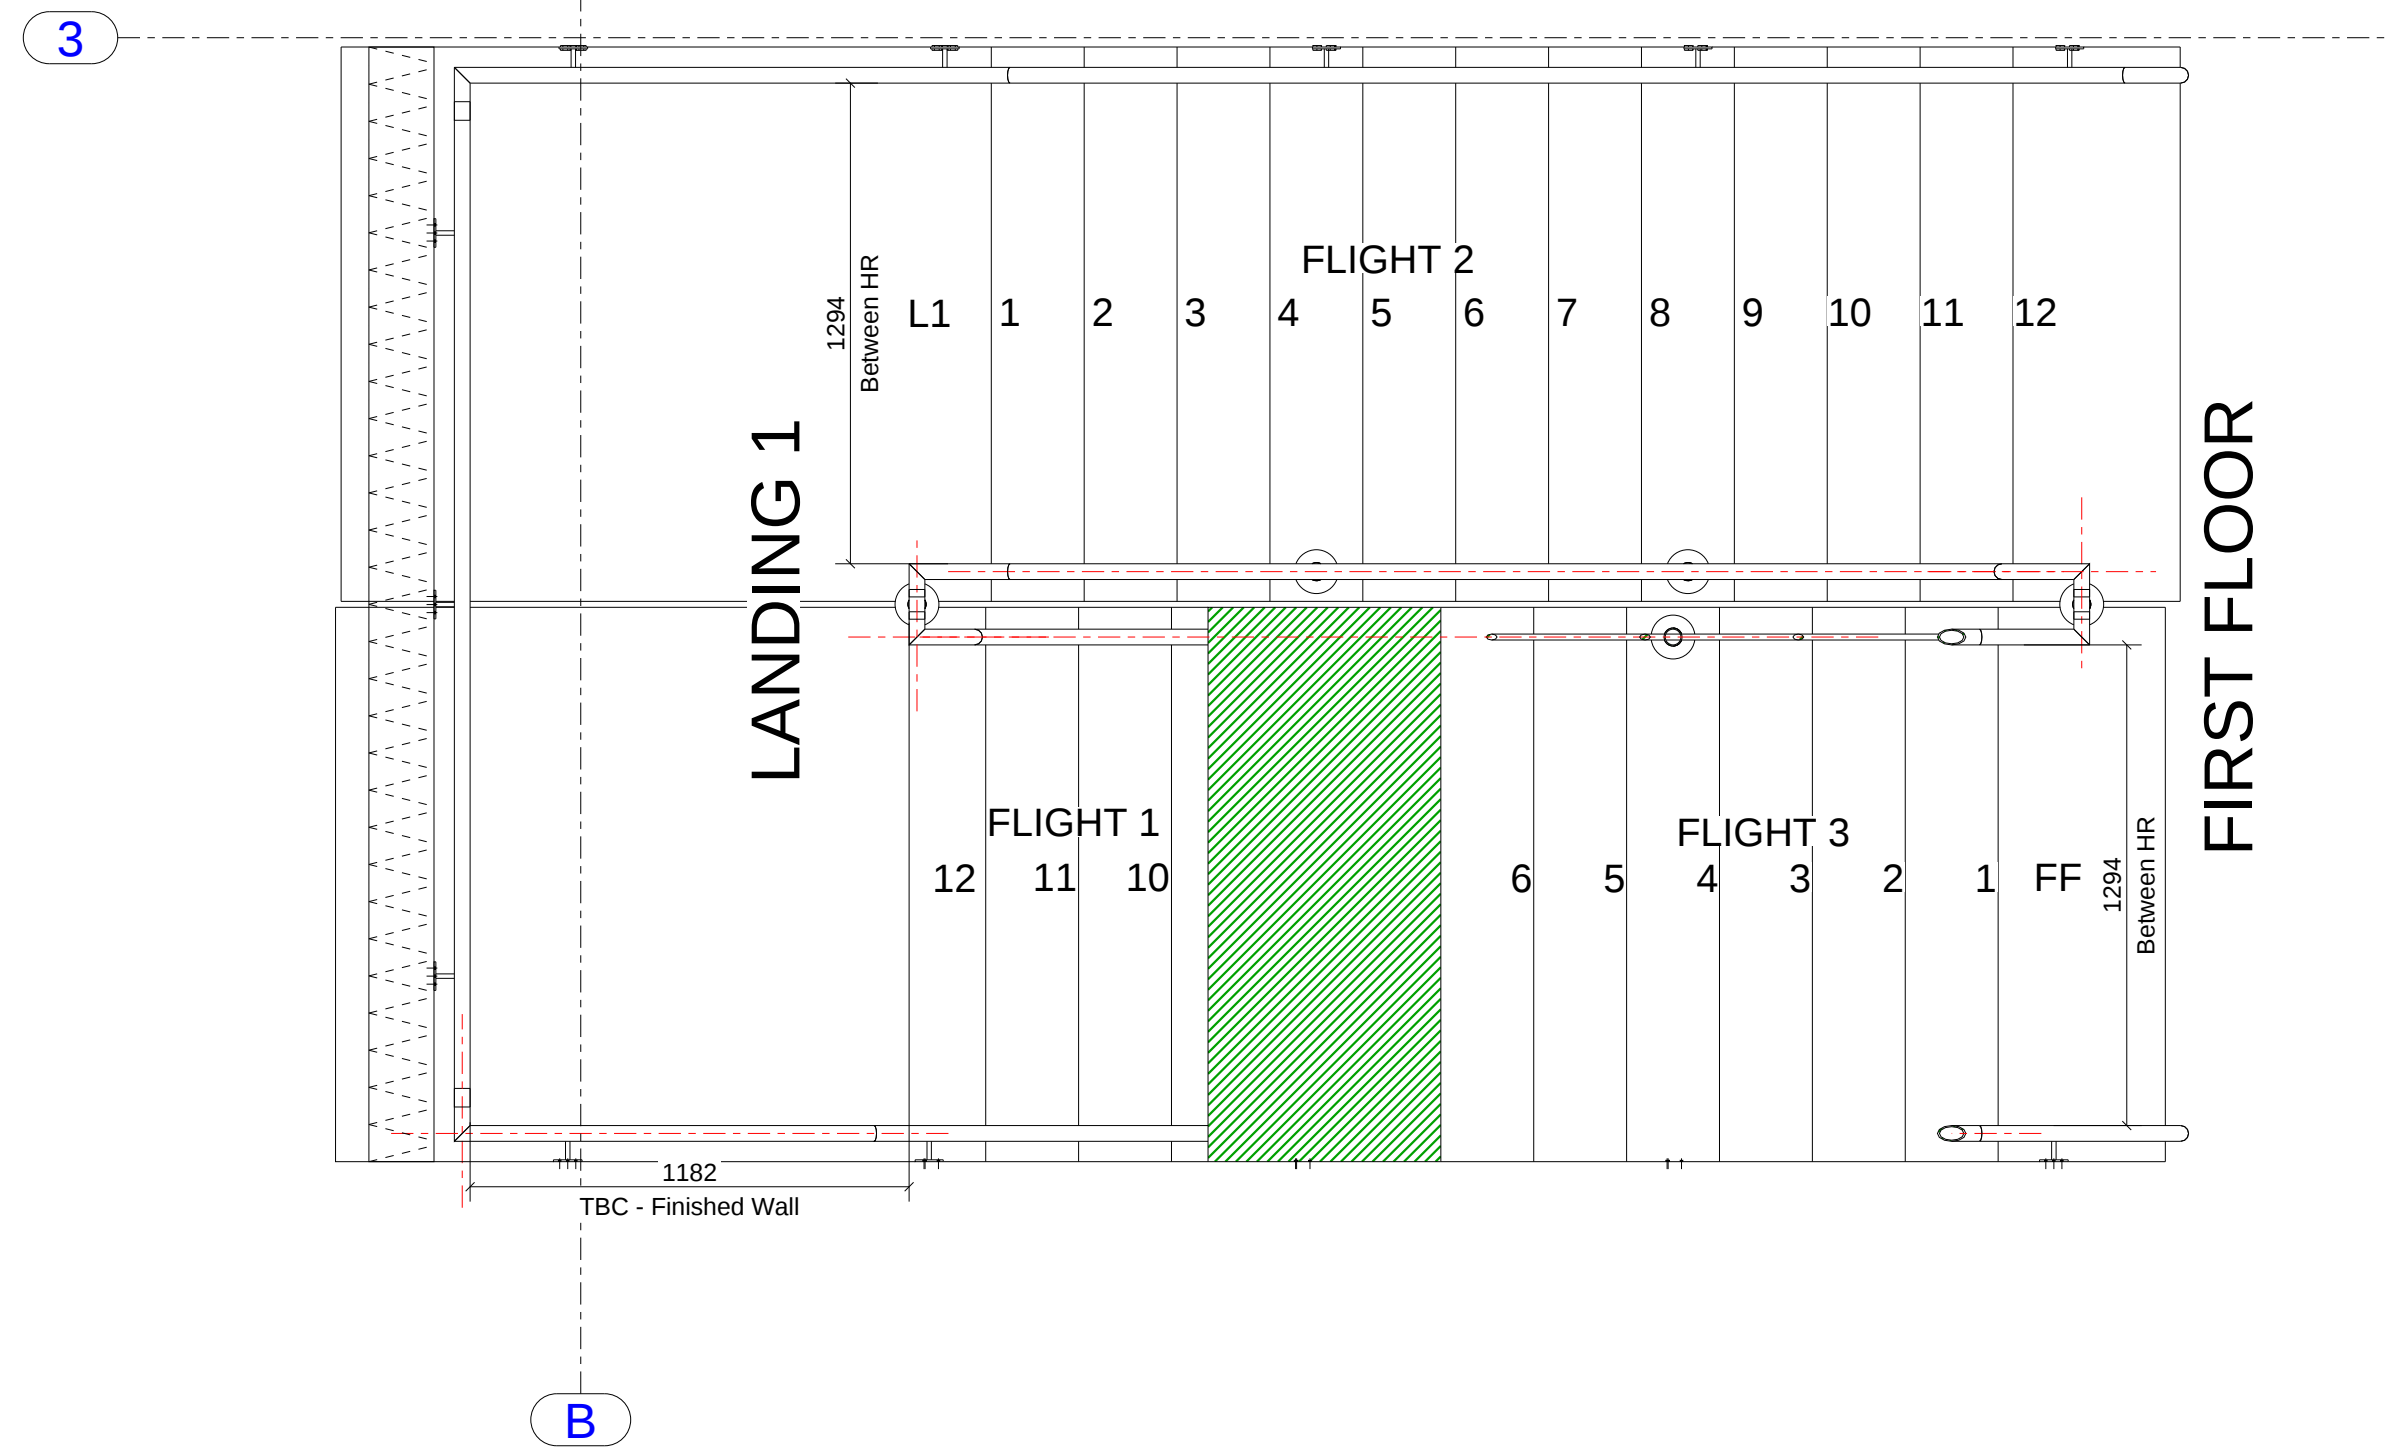


Plan +4000

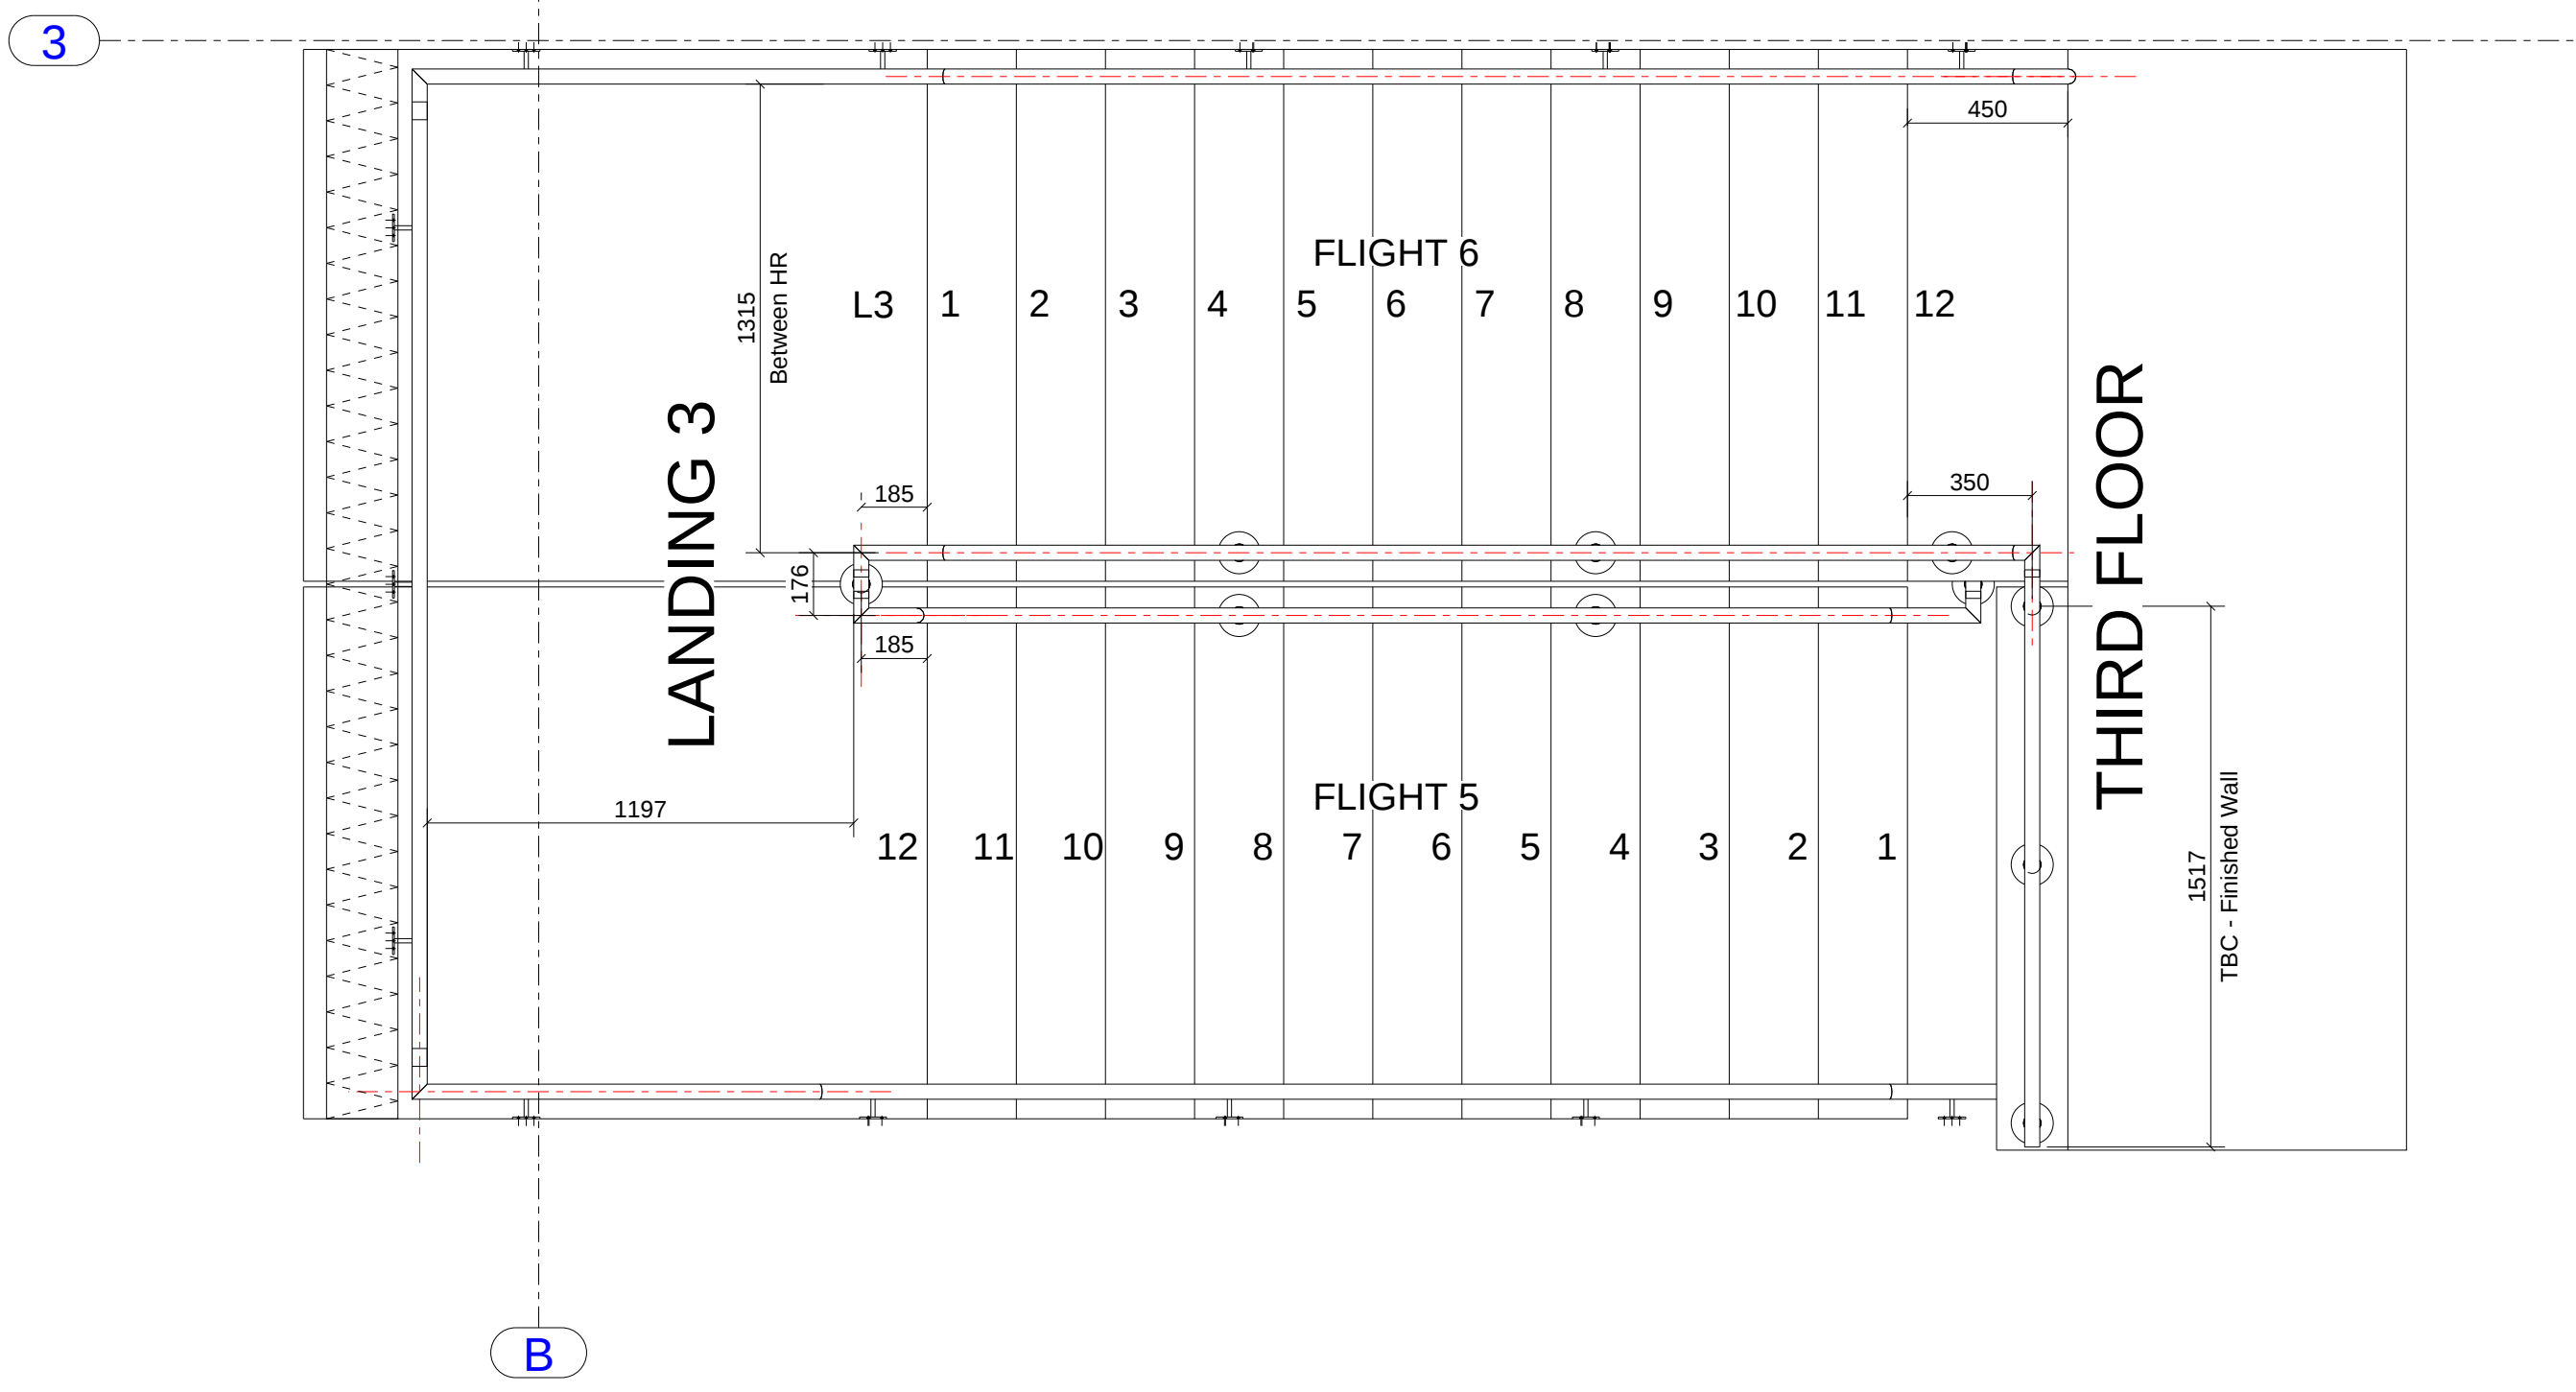

Plan +12000

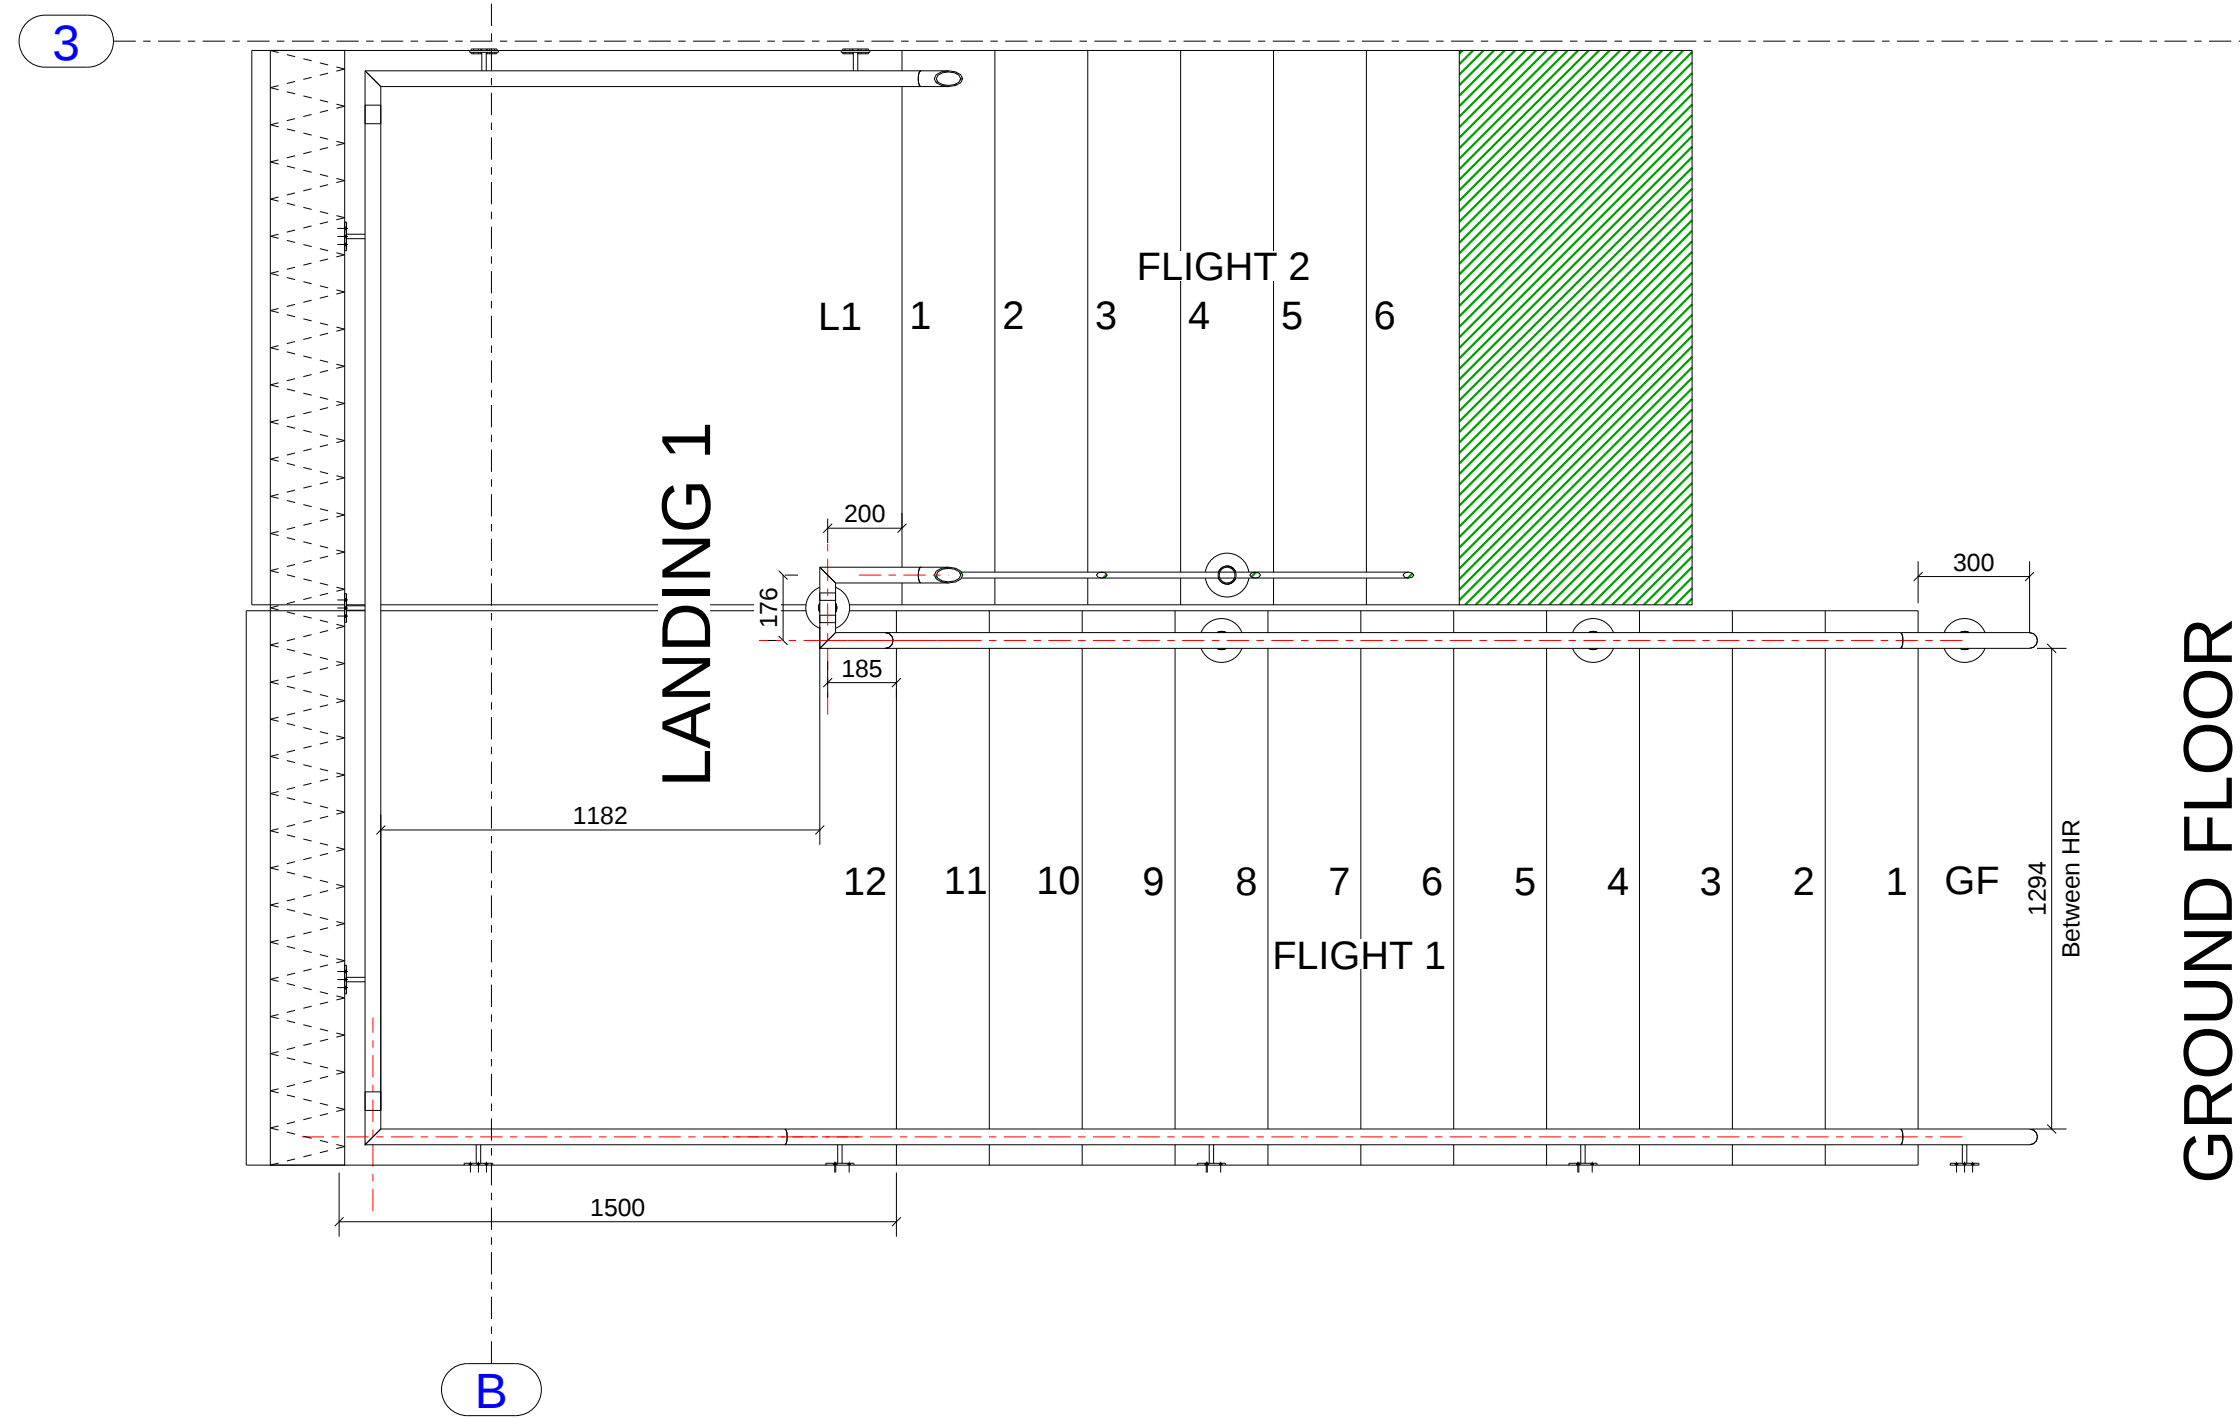


Plan +0

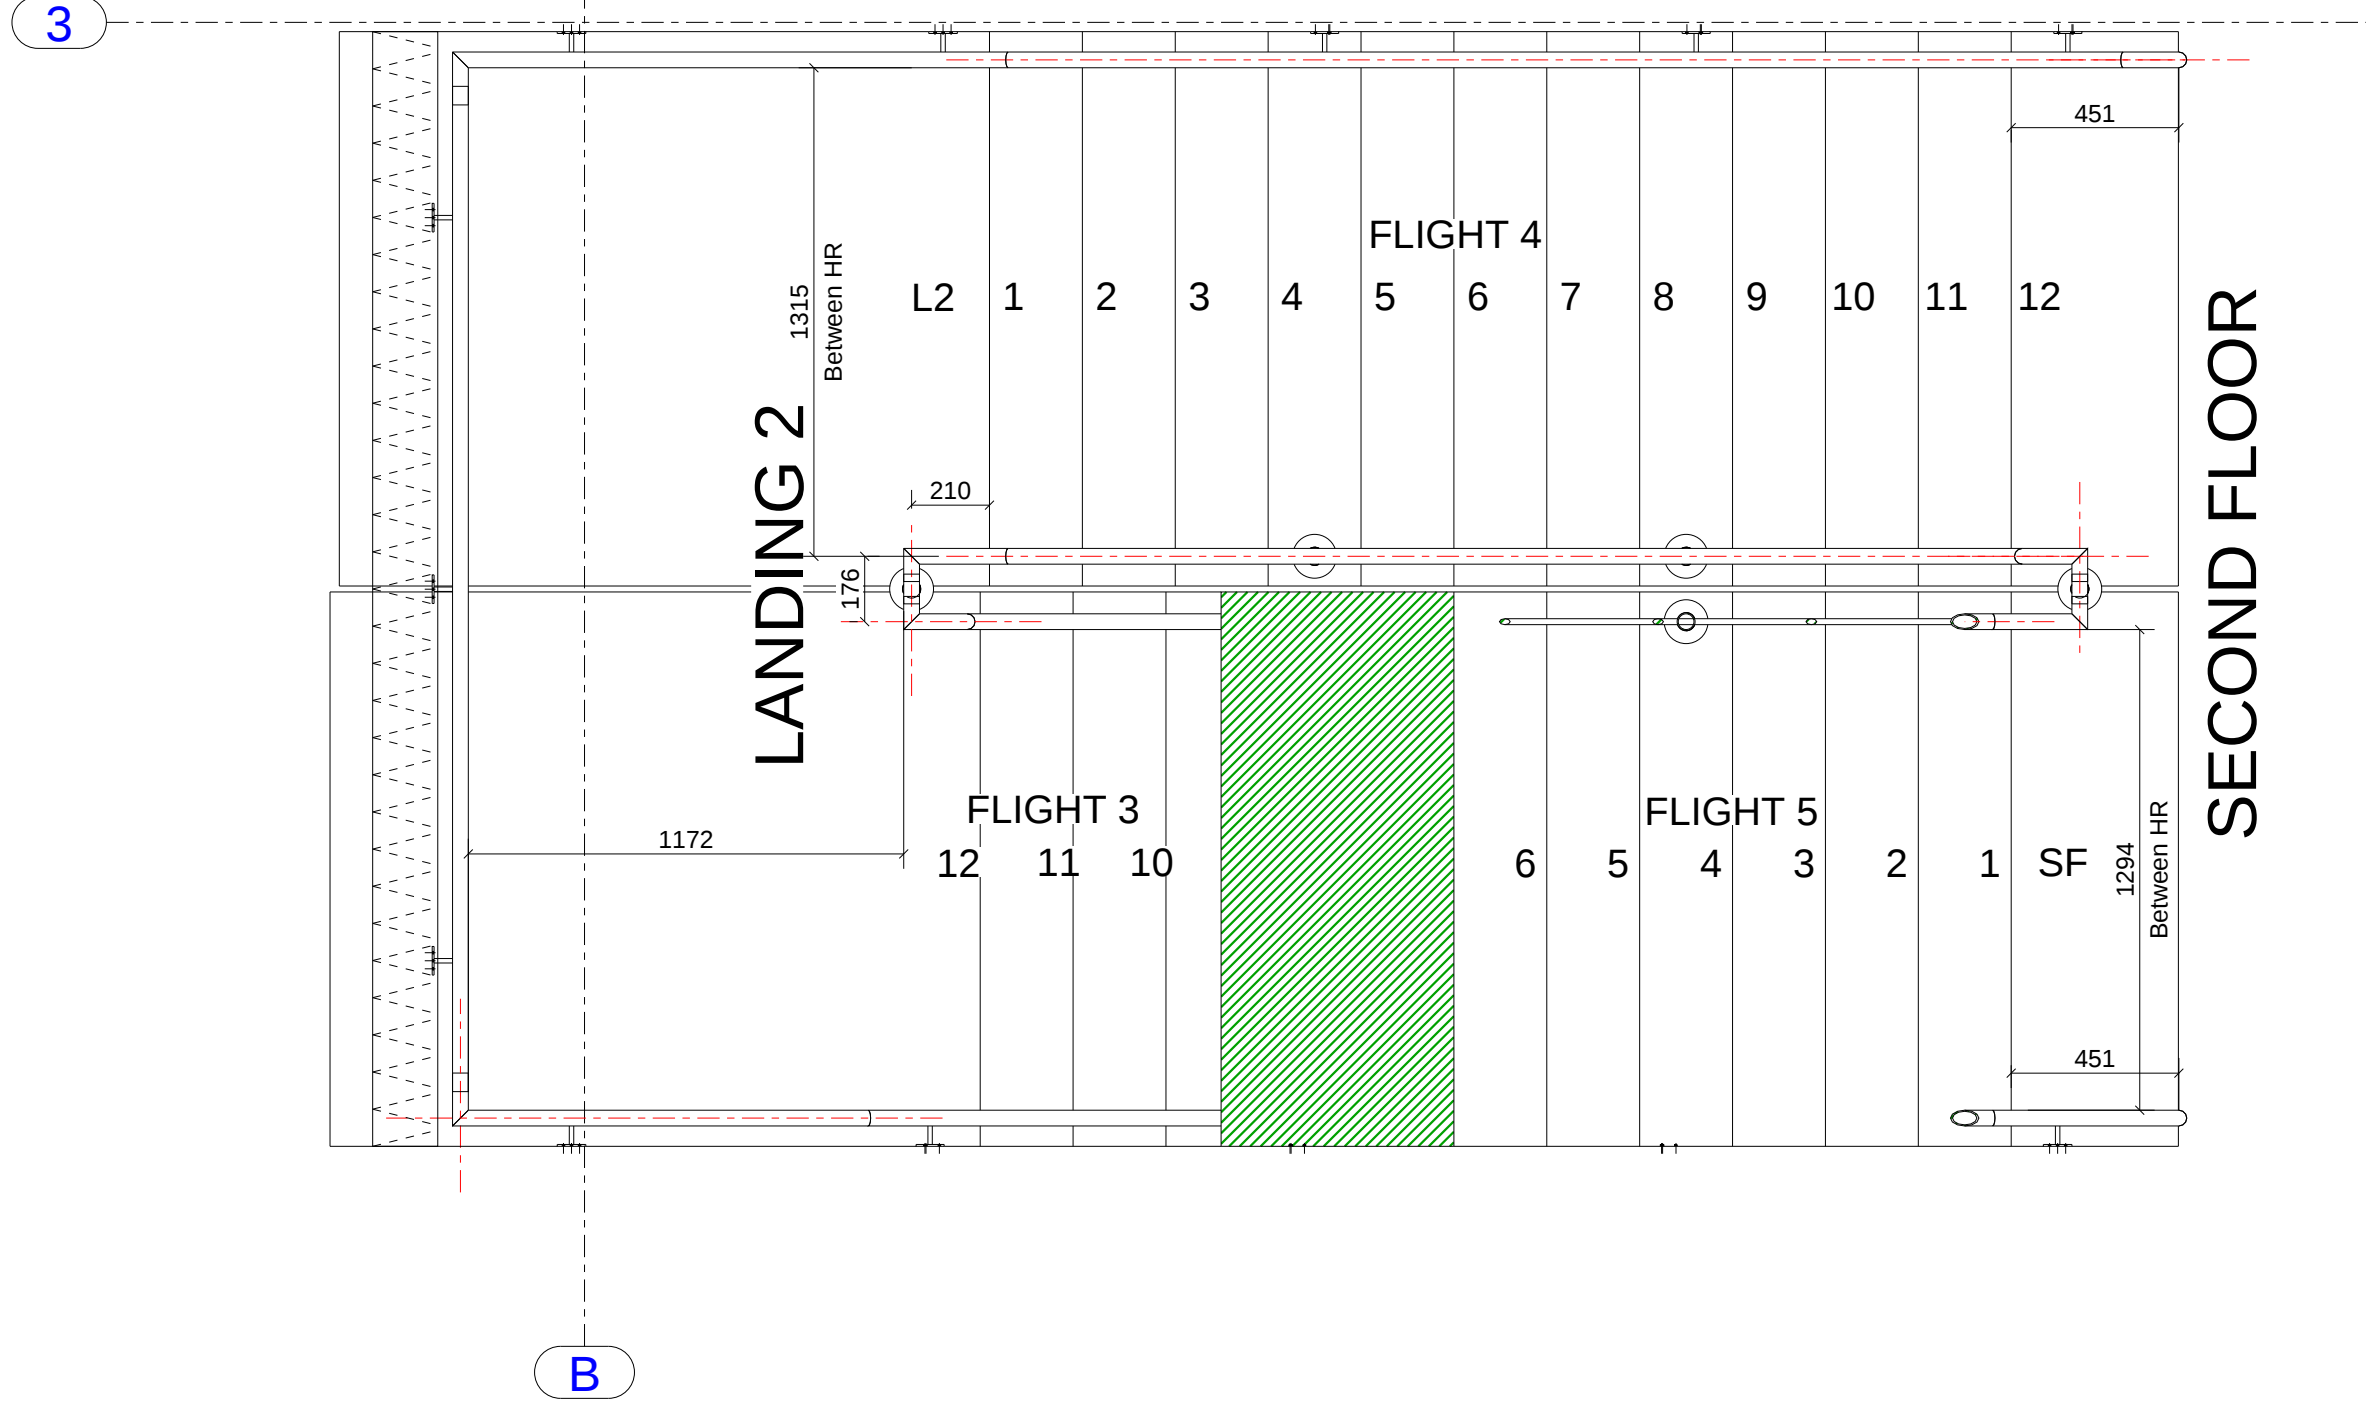


Plan +8000

Specification:
Welded mild-steel Balustrade and handrails
powder coated in RAL 7016 (Anthracite Grey).
Handrail - Ø42.4mm
Stanchions - Ø48.3mm
Balustrade infill bars - Ø16mm

REV MARK	DESCRIPTION	CREATED	CHECKED
Z01	As Built	NM	29.07.2022
C01	For Construction	NM	28.06.2022
P01	For Approval/Comment	NM	11.05.2022
CLIENT:	Winvic		
PROJECT:	Calder Park		
DRAWING TITLE:	Plan Views		
CONTRACT:	Fire Escape Stair Balustrade		
DRAWN BY:	NM	ISSUE DATE	11.05.2022
CONTRACT NO:	1160-104	SCALE	1:20 1:50
DRAWING NO:	P21024-MRI-U1-ZZ-DR-X-4002	REVISION No.	Z01

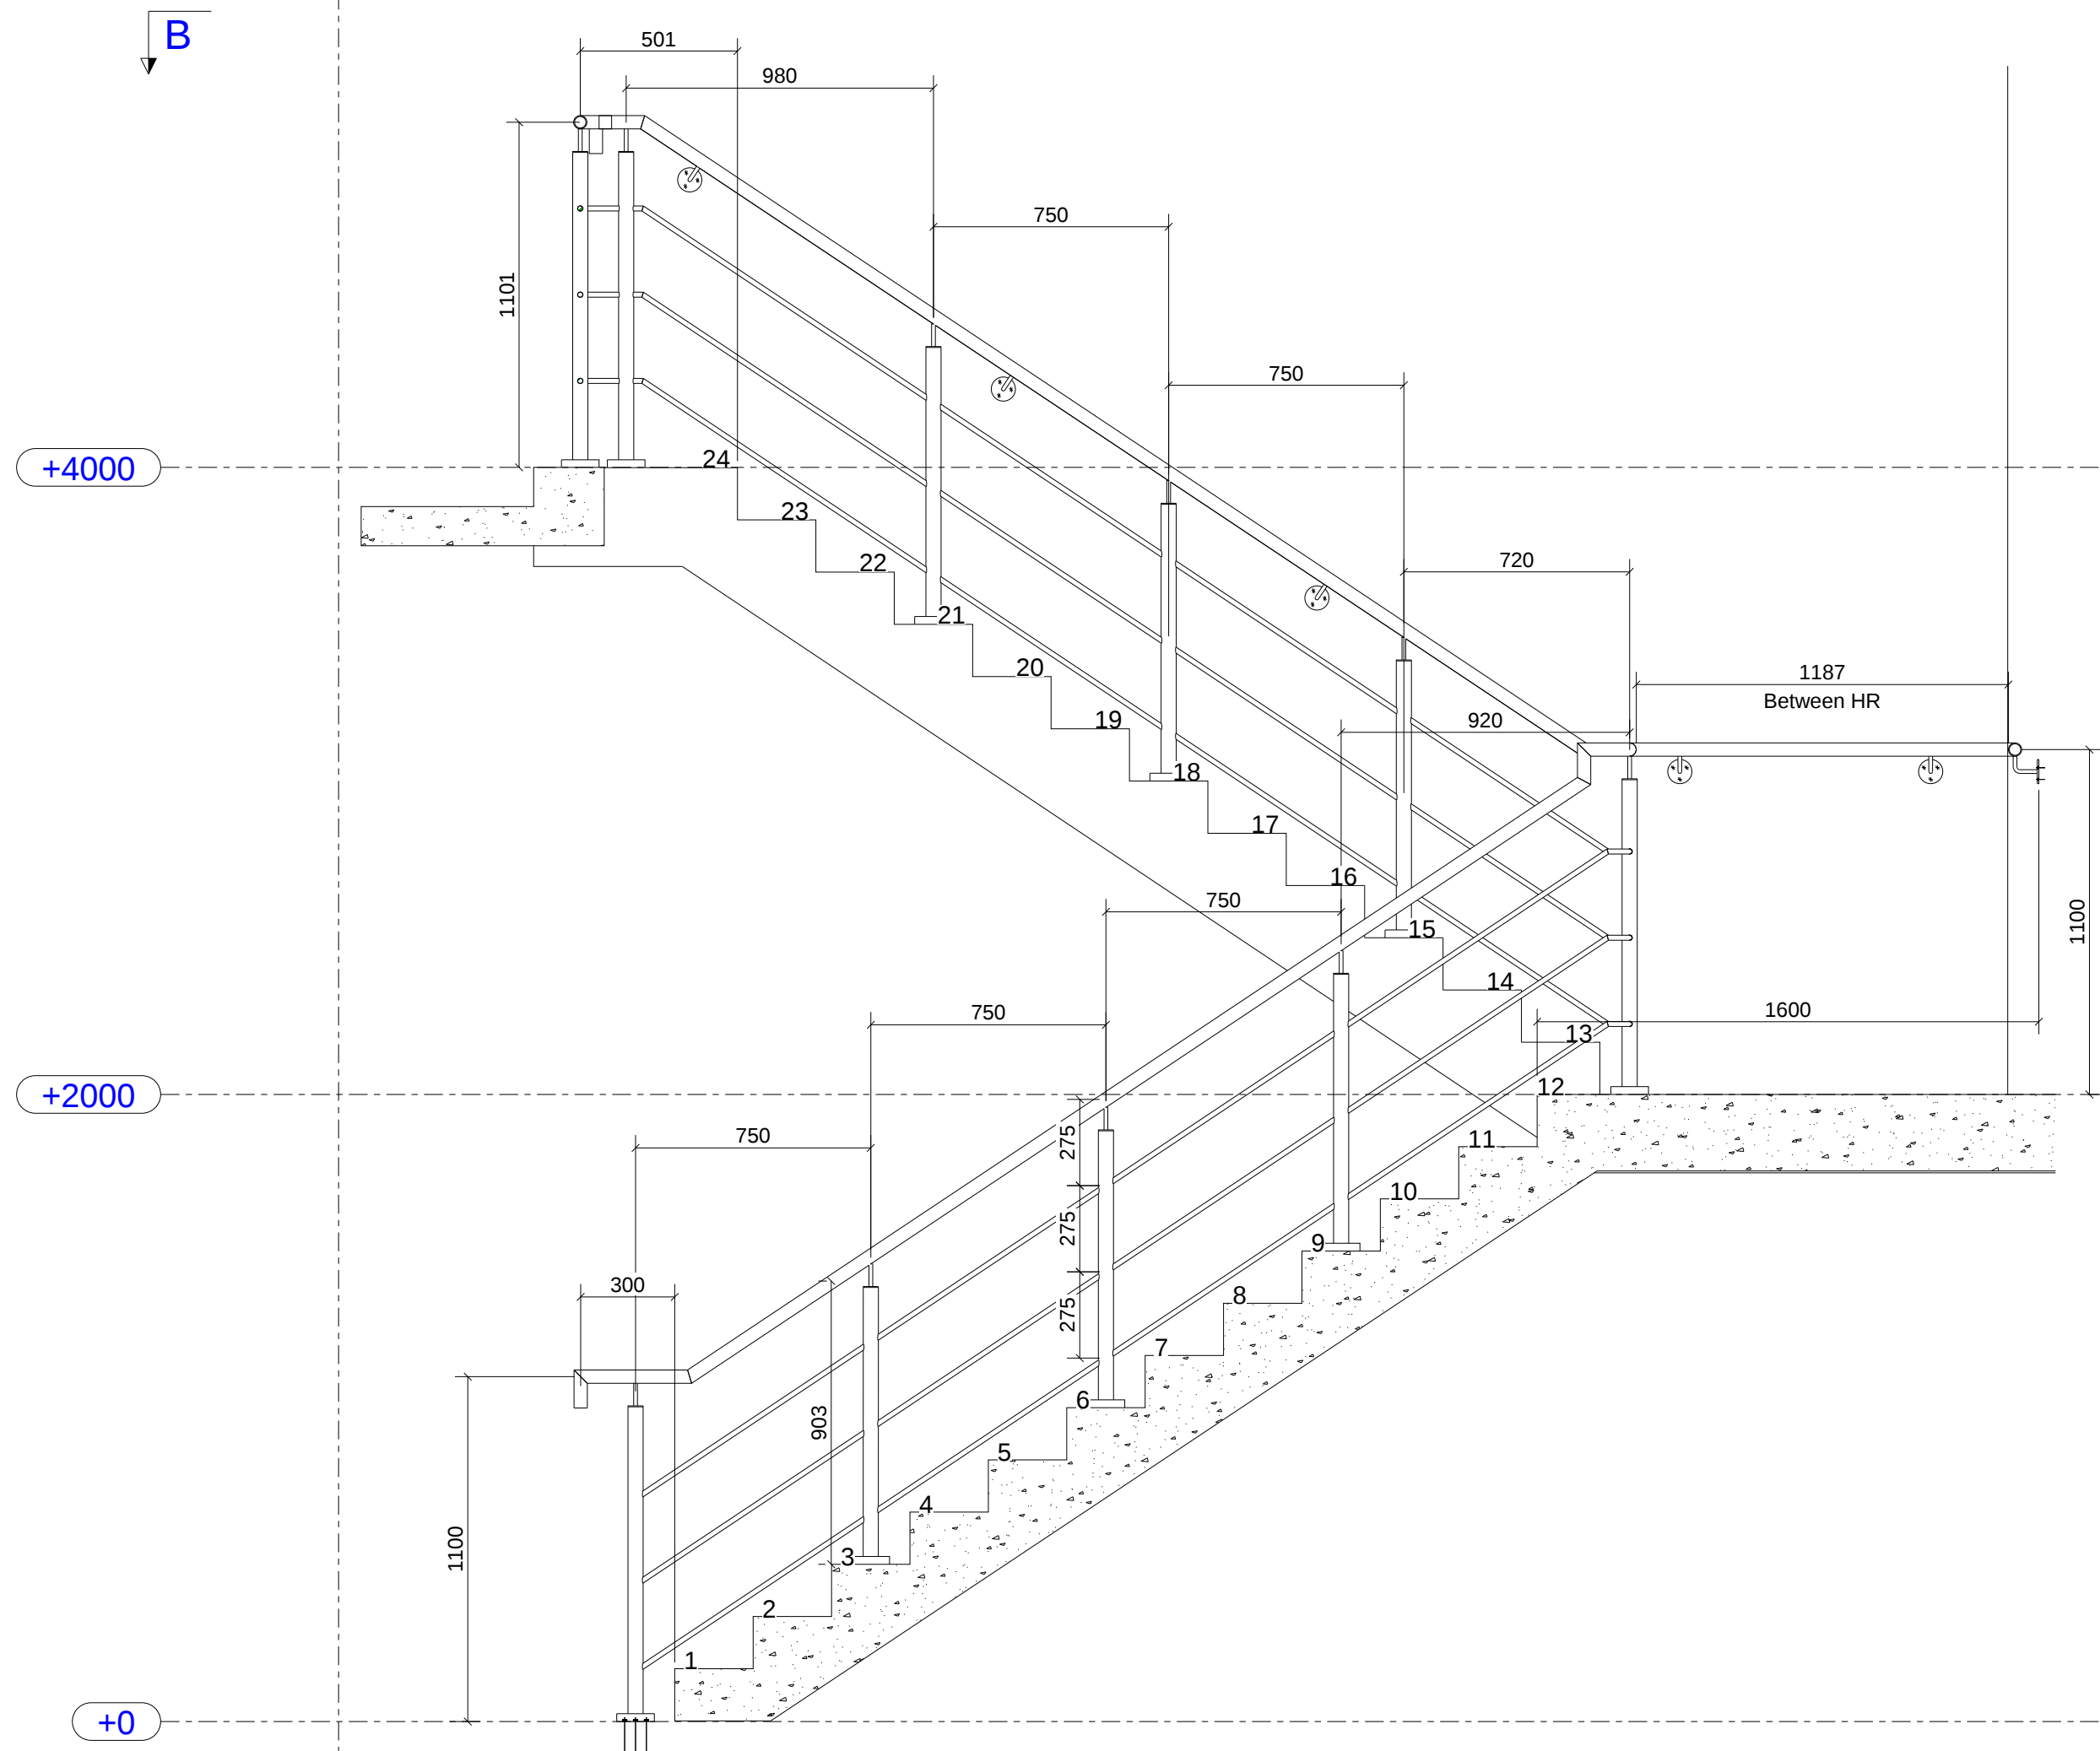


A - A

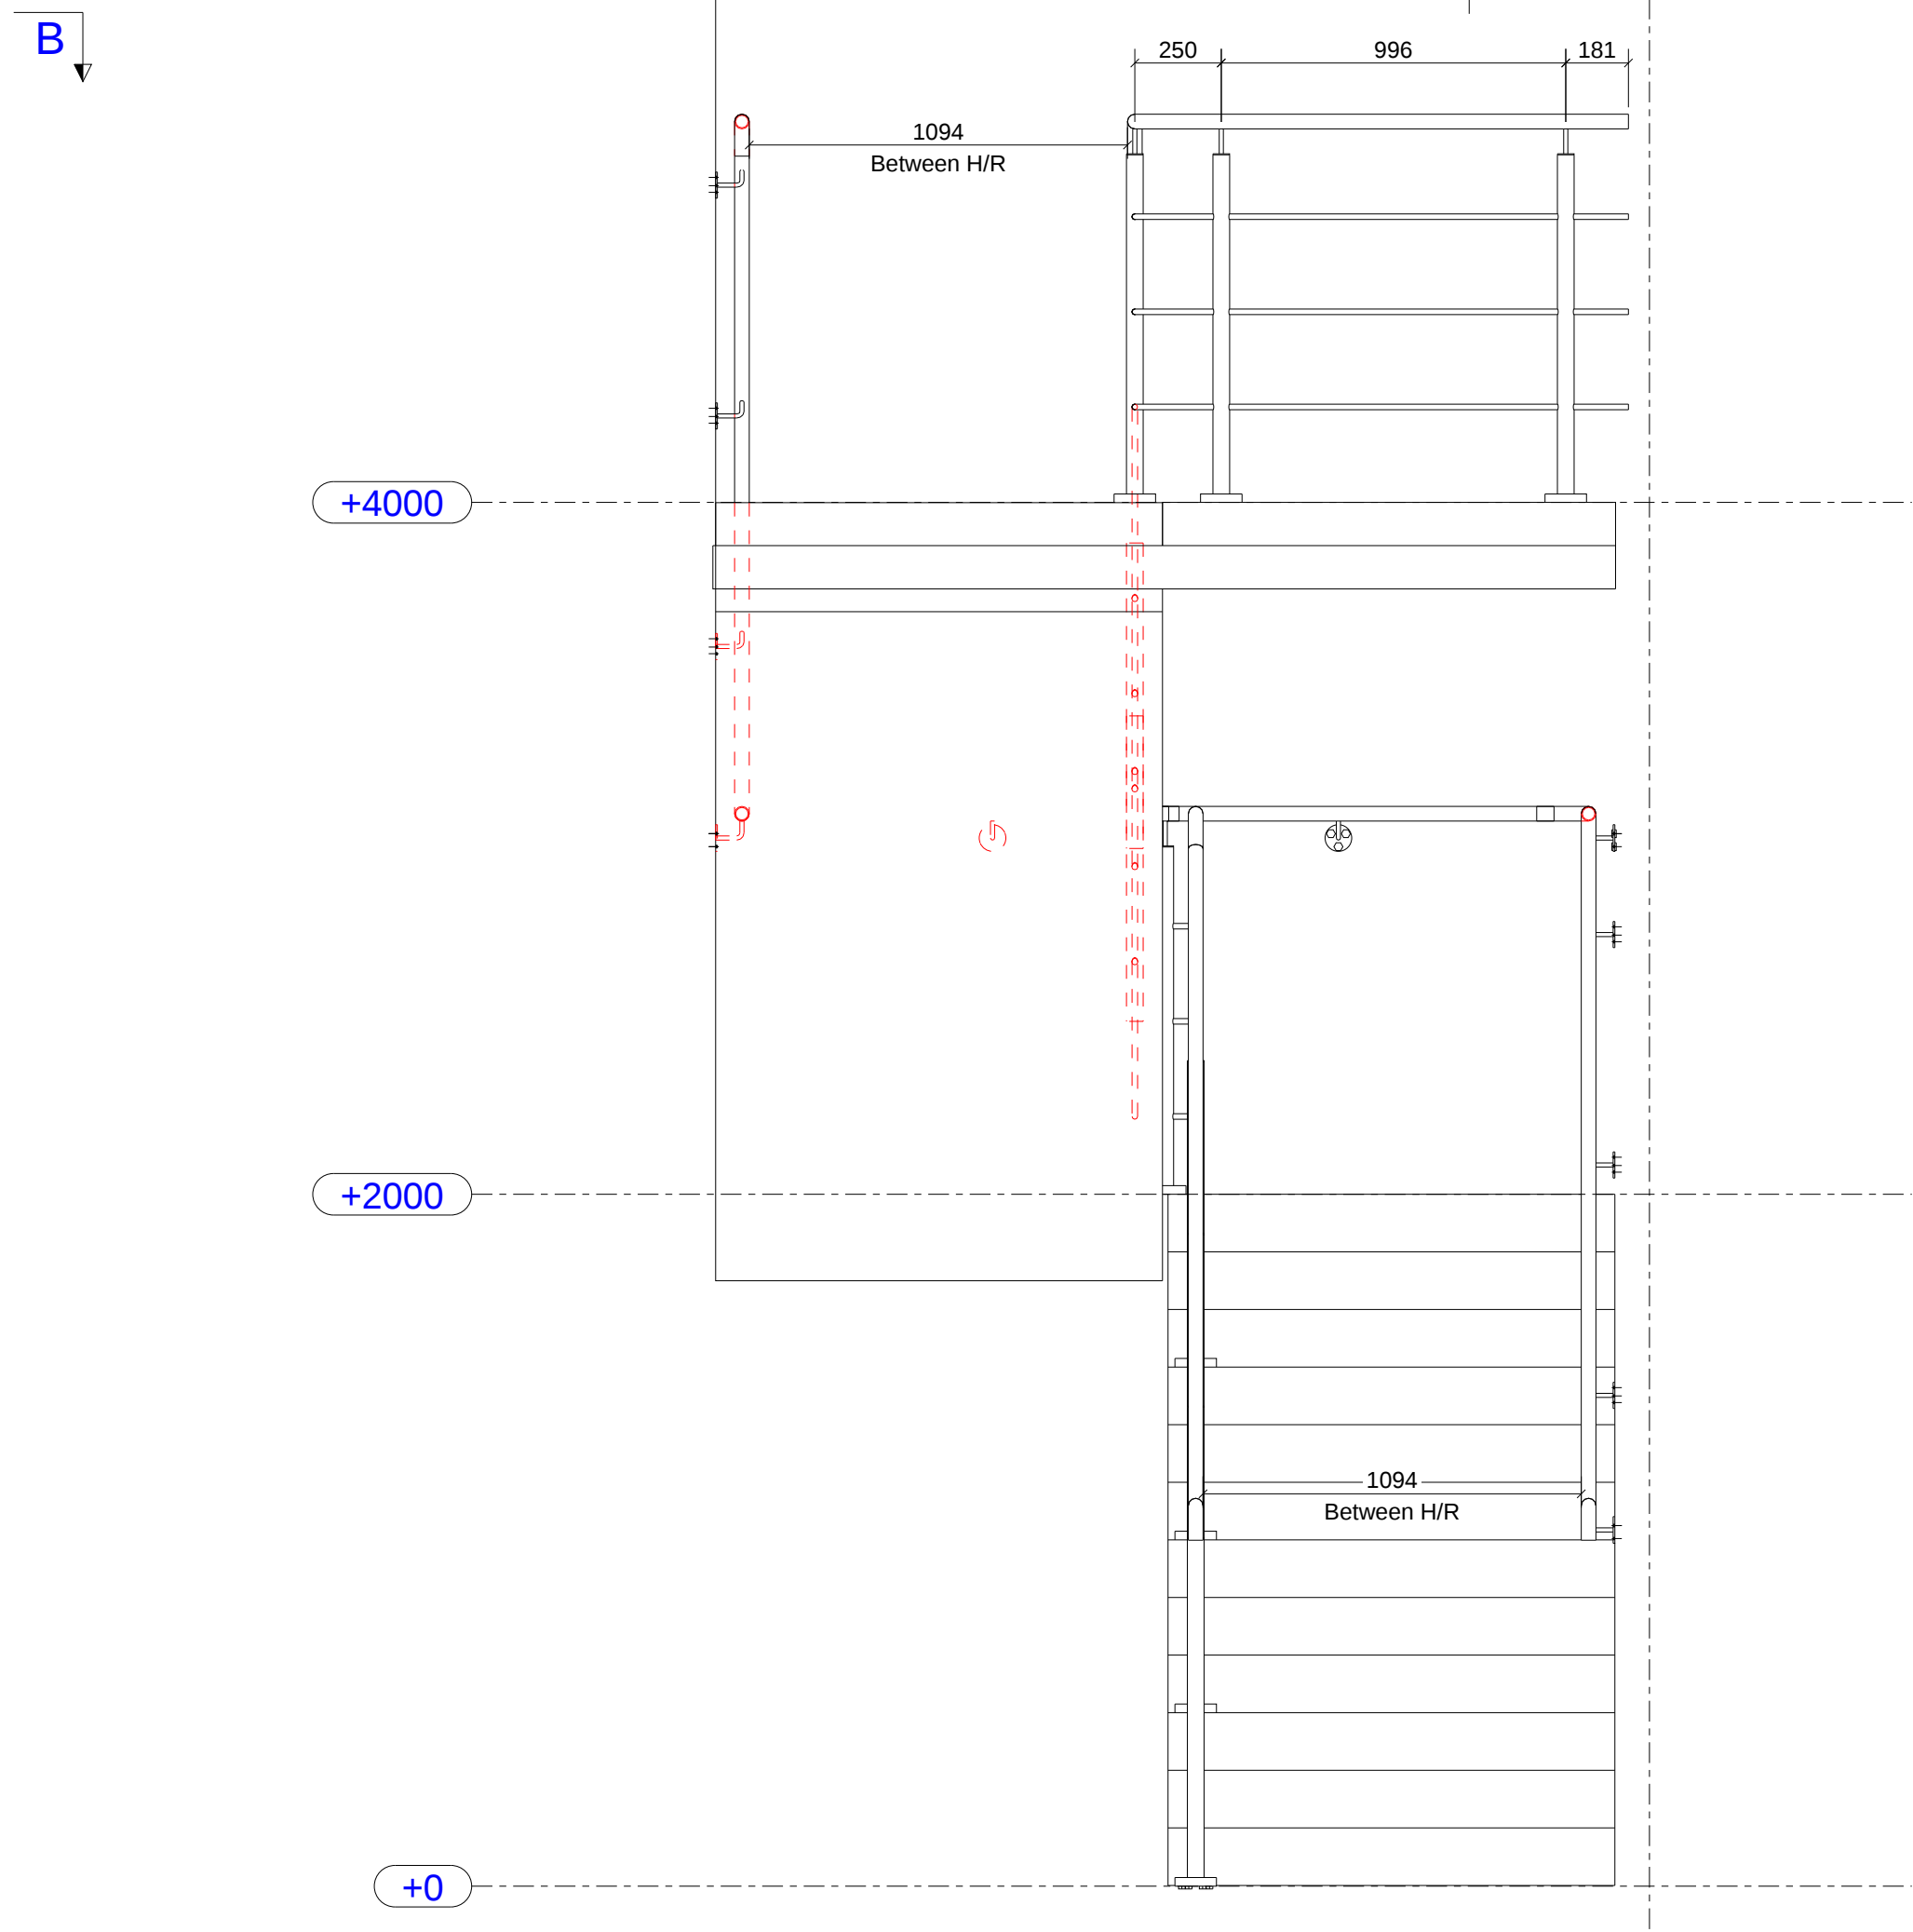


Grid 15

W

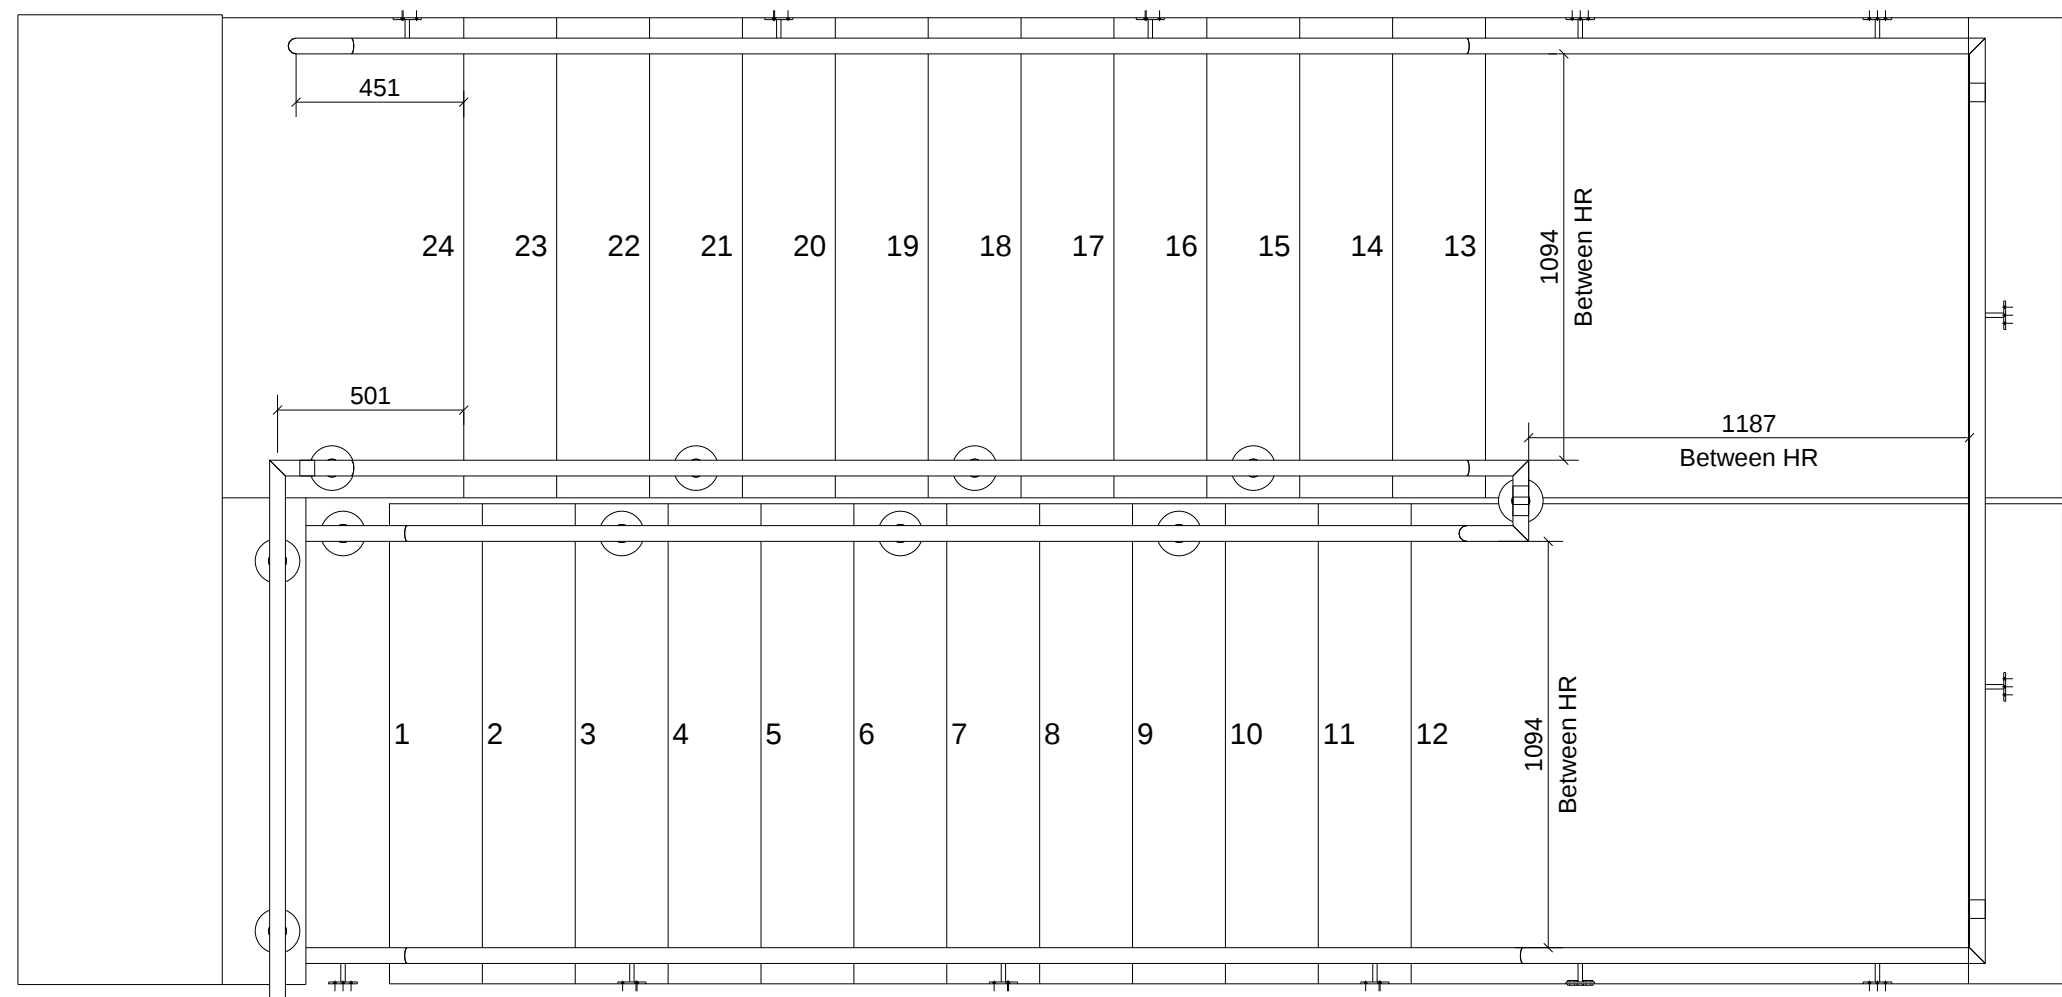

B - B

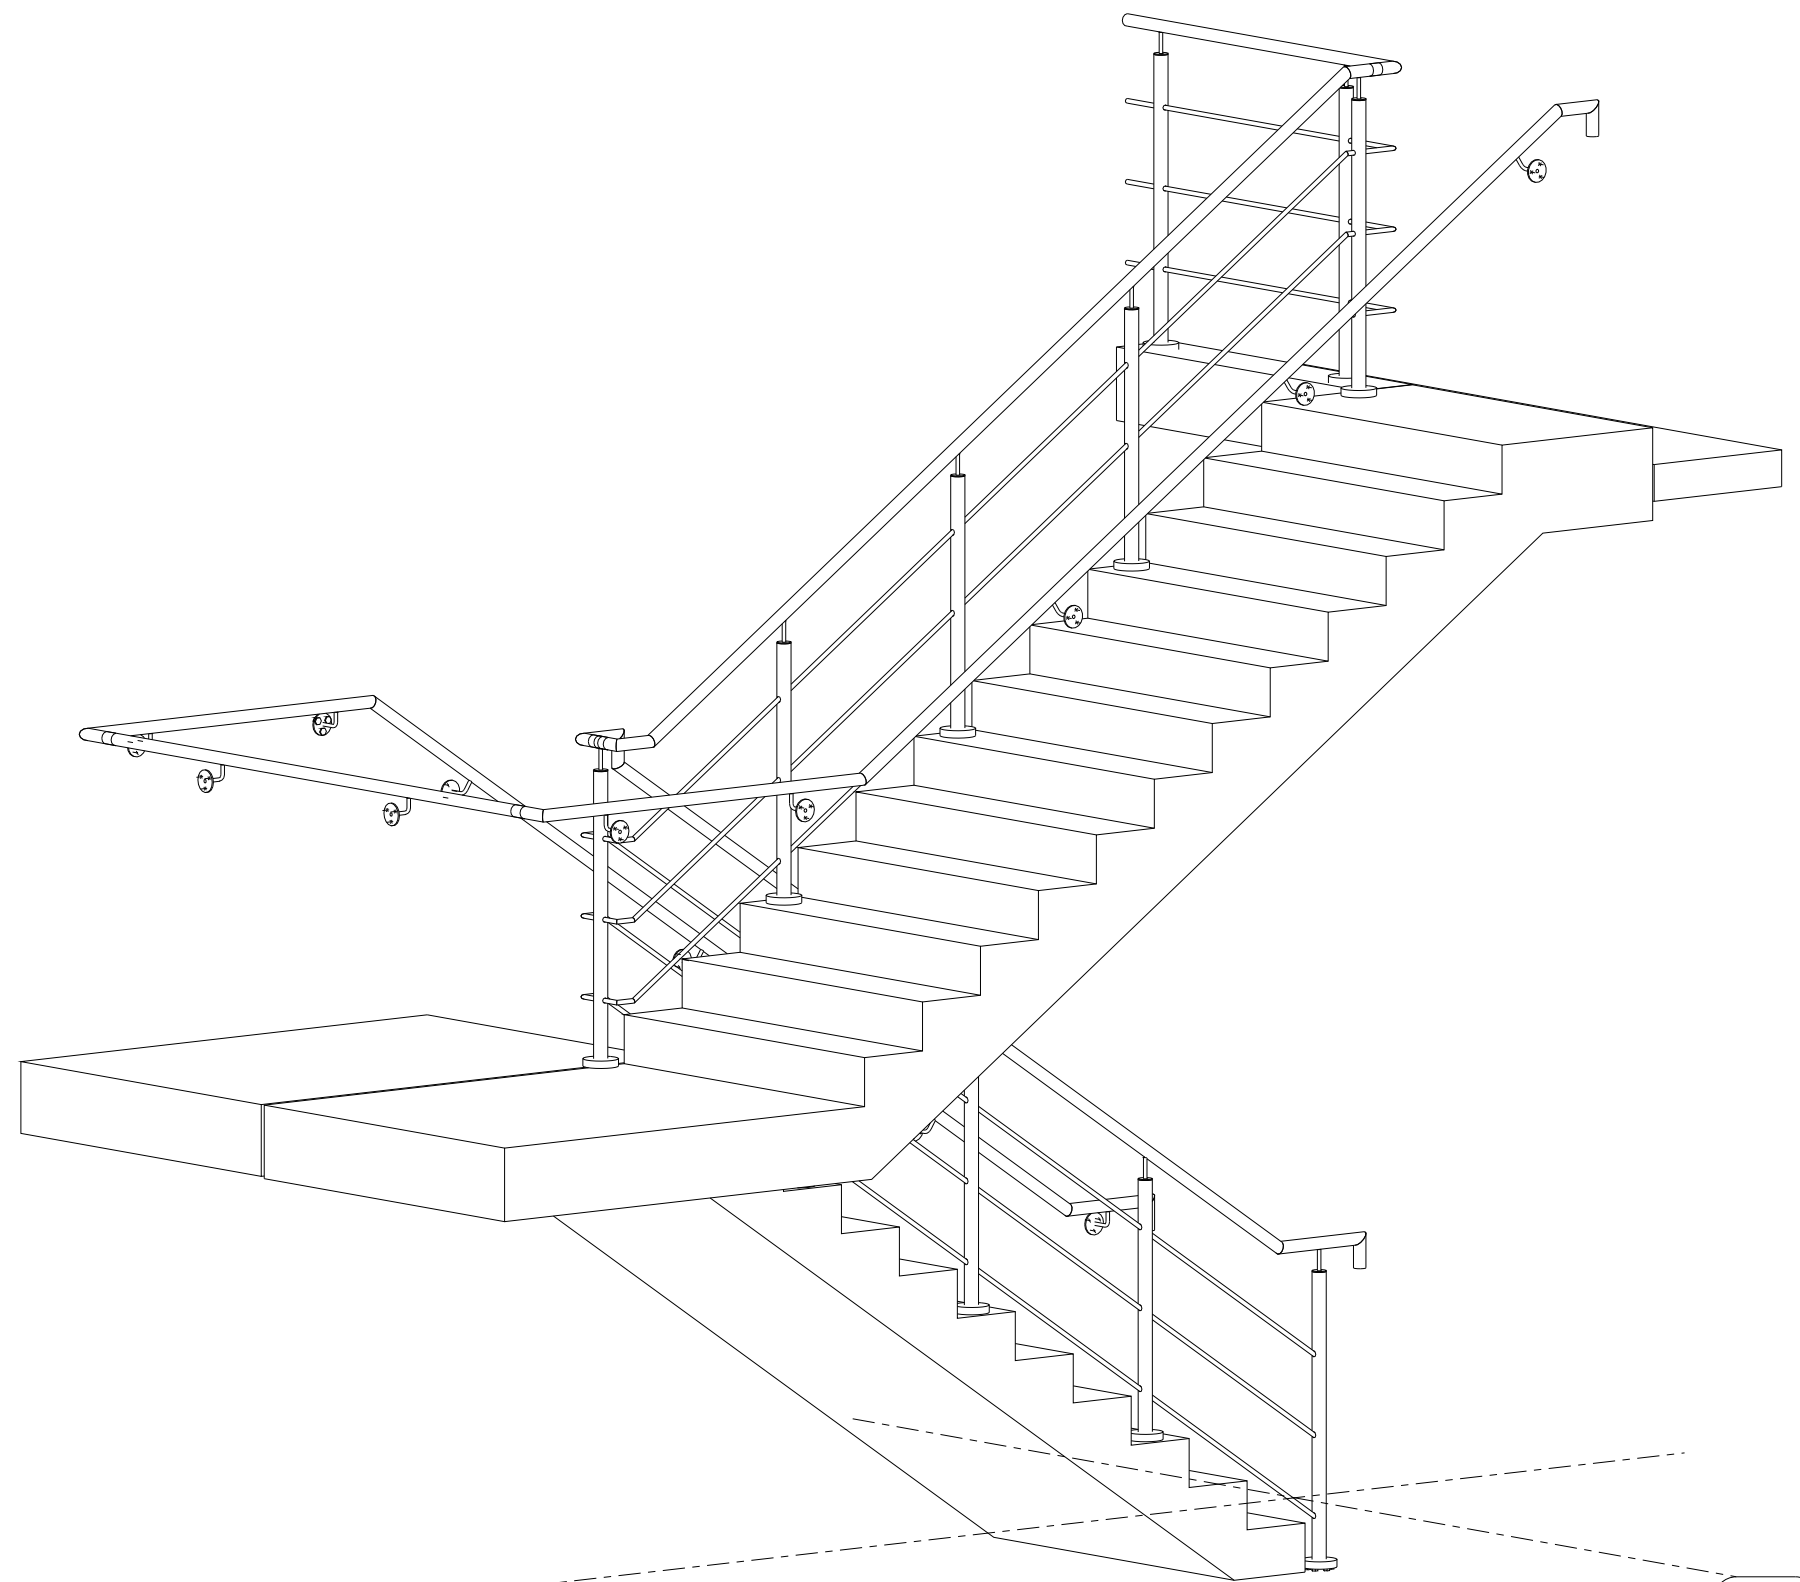

3d

Specification:
Welded mild-steel Balustrade and handrails
powder coated in RAL 7016 (Anthracite Grey).
Handrail - Ø42.4mm
Stanchions - Ø48.3mm
Balustrade infill bars - Ø16mm

NOTE:
PATRESSING IS REQUIRED TO
FIX WALL MOUNTED HANDRAIL

REV	MARK	DESCRIPTION	CREATED	CHECKED
Z01	As Built	NM	29.07.2022	
CO1	Construction	NM	24.06.2022	
P01	For Approval/Comment	NM	11.05.2022	
By	Date	By	Date	
CLIENT:	Winvic			
PROJECT:	Calder Park			
DRAWING TITLE:	Sections			
CONTRACT:	Hub Office Stair Balustrade			
DRAWN BY:	NM	ISSUE DATE	12.05.2022	
CONTRACT NO:	1160-106	SCALE	1:20 1:25	
DRAWING NO:	P21024-MRI-ZZ-ZZ-DR-X-6001	REVISION No.		Z01